


The North $\frac{1}{2}$ of the NW $\frac{1}{4}$ of the
SW $\frac{1}{4}$ of Section 2, T 3 N, R 15 E.
Walworth County, Wisconsin

SURVEYED FOR: Tom Marshall
Howard Road
Whitewater, WI 53190
473-6357

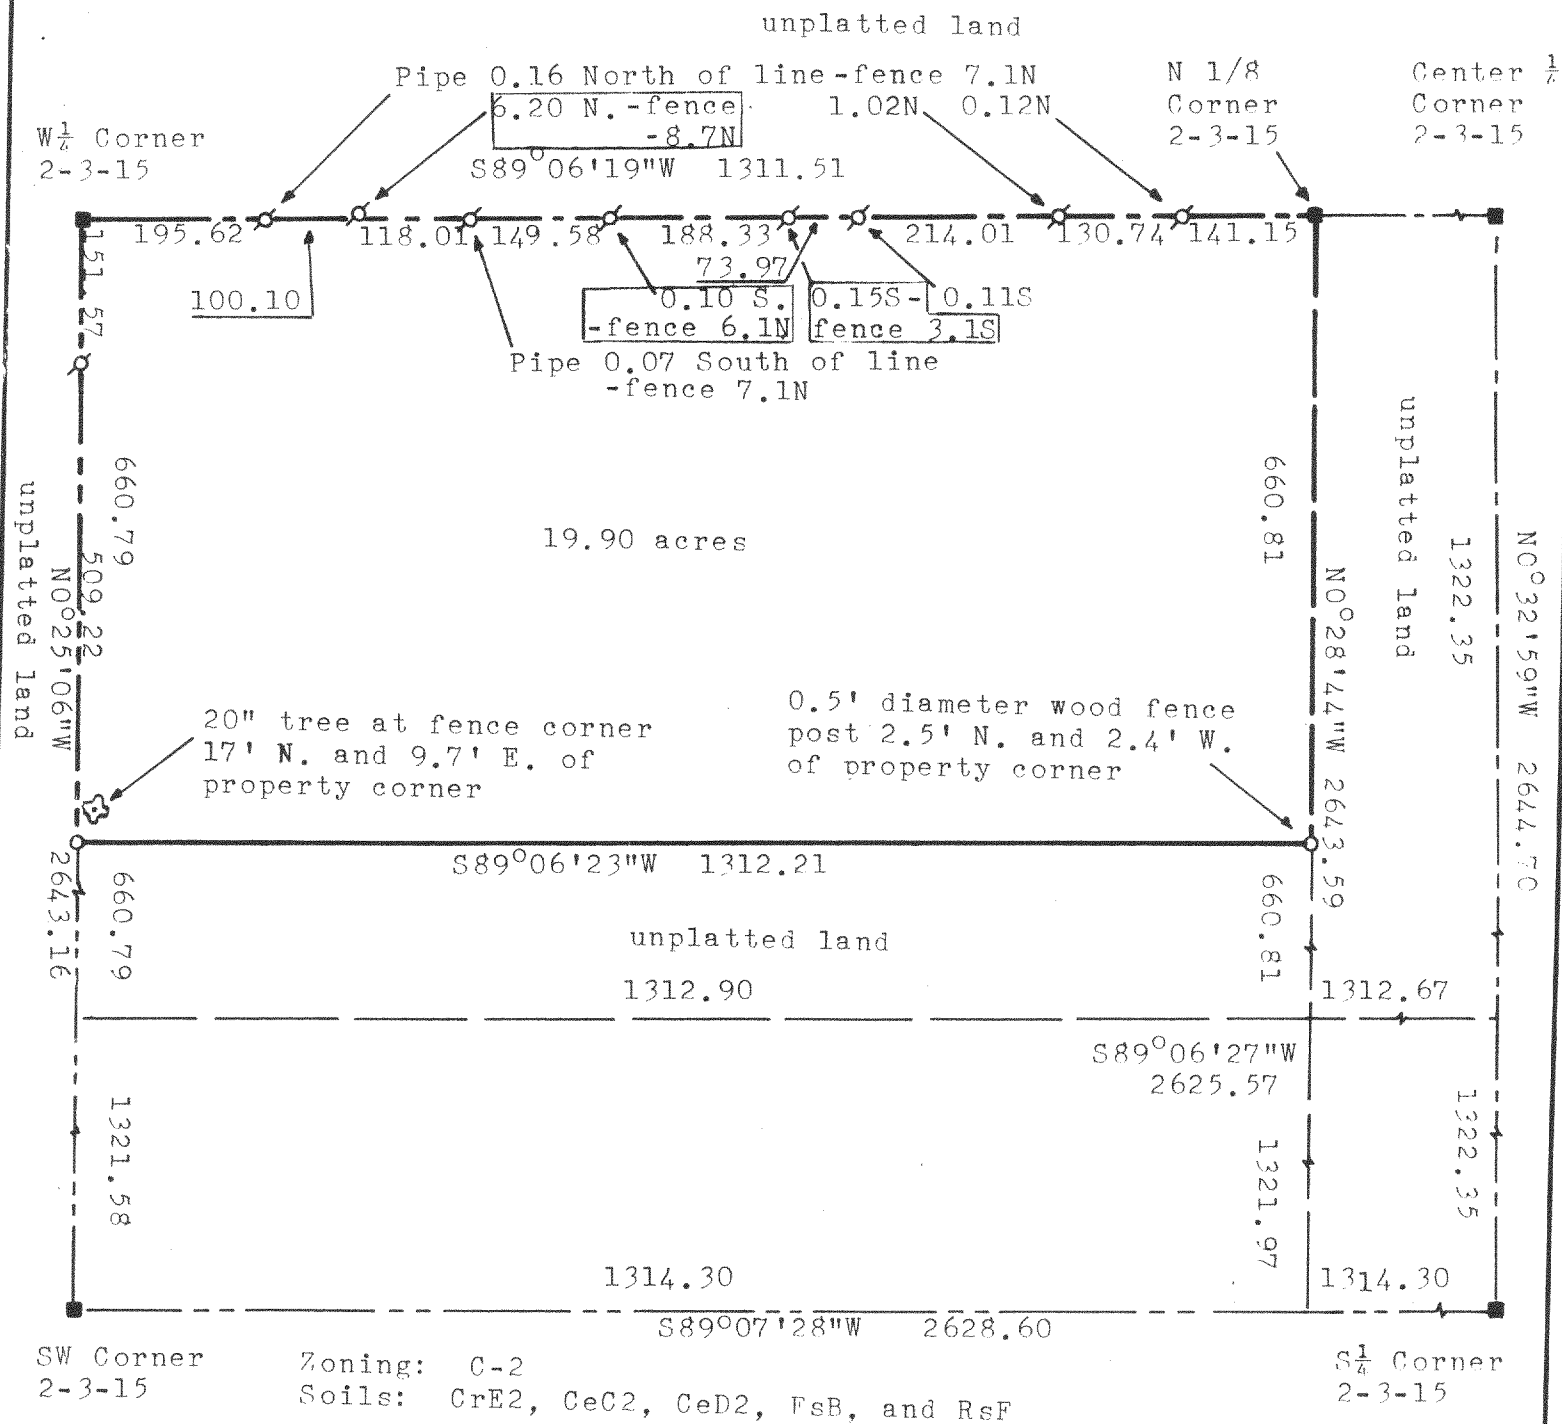

Copyright © 1989 by Jensen Surveying & Mapping S.C.


All rights reserved. No part of this survey plat may be reproduced or transmitted in any form by any means - graphic, electronic, or mechanical, including photocopying, tracing, or information storage and retrieval systems - without permission in writing from Thomas P.A. Jensen, Jensen Surveying & Mapping S.C.

Note: This survey plat is not certified unless signed and sealed in red ink.

I, Thomas F.M. Jensen, Wisconsin Registered Land Surveyor, do hereby certify that this survey was performed by me, or under my direction, in full compliance with the owner's agent's instructions and Chapter A-E 7 of the Wisconsin Administrative Code "Minimum Standards For Property Surveys"; and that this map is an accurate representation thereof to the best of my knowledge and belief.

Thomas P.A. Jensen R.L.S-1084
Jensen Surveying & Mapping S.C.

Bearings referenced to the West line of the SW $\frac{1}{4}$ of Section 2-3-15 assumed as N0°25'06"W to match previous survey records

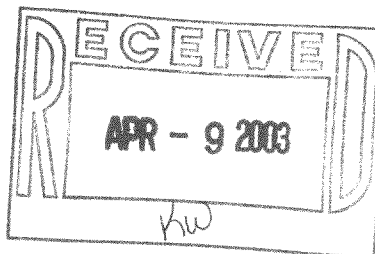

Legend

- Found County Section Corner
- ✓ Found iron pipe
- Set iron rod 3/4" x 24"

Jensen Surveying & Mapping S.C.

45 South Wisconsin Street P.O. Box 322
Elkhorn, Wisconsin. 53121.
(414) 723-3434

Mapping date: DECEMBER 6, 1989

Revisions:

Sheet 1 of 1 Sheets

Job reference number:

1989.140

315-804

Scale: 1 = 200'



CR 2-5