

LAND-MARK SURVEYING
Mark L. Miritz



Wisconsin Registered Land Surveyor S-2582

N9330 Knuteson Drive
Whitewater, WI 53190
Phone: (262) 495-3284
FAX : (262) 495-8421
LAND-MARKSURVEYING.COM

PLAT OF SURVEY

**LOT 1, BLOCK 3 OF CHAPEL HILLS SUBDIVISION,
LOCATED IN SECTION 3, TOWN 3 NORTH, RANGE 15
EAST, RICHMOND TOWNSHIP, WALWORTH COUNTY,
WISCONSIN.**

OWNERS: JAMES T. & GAYLE R. BROUSSEAU
37 N. DEERPATH ROAD
BARRINGTON, IL 60010

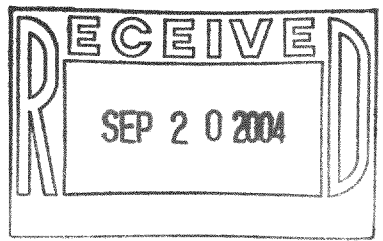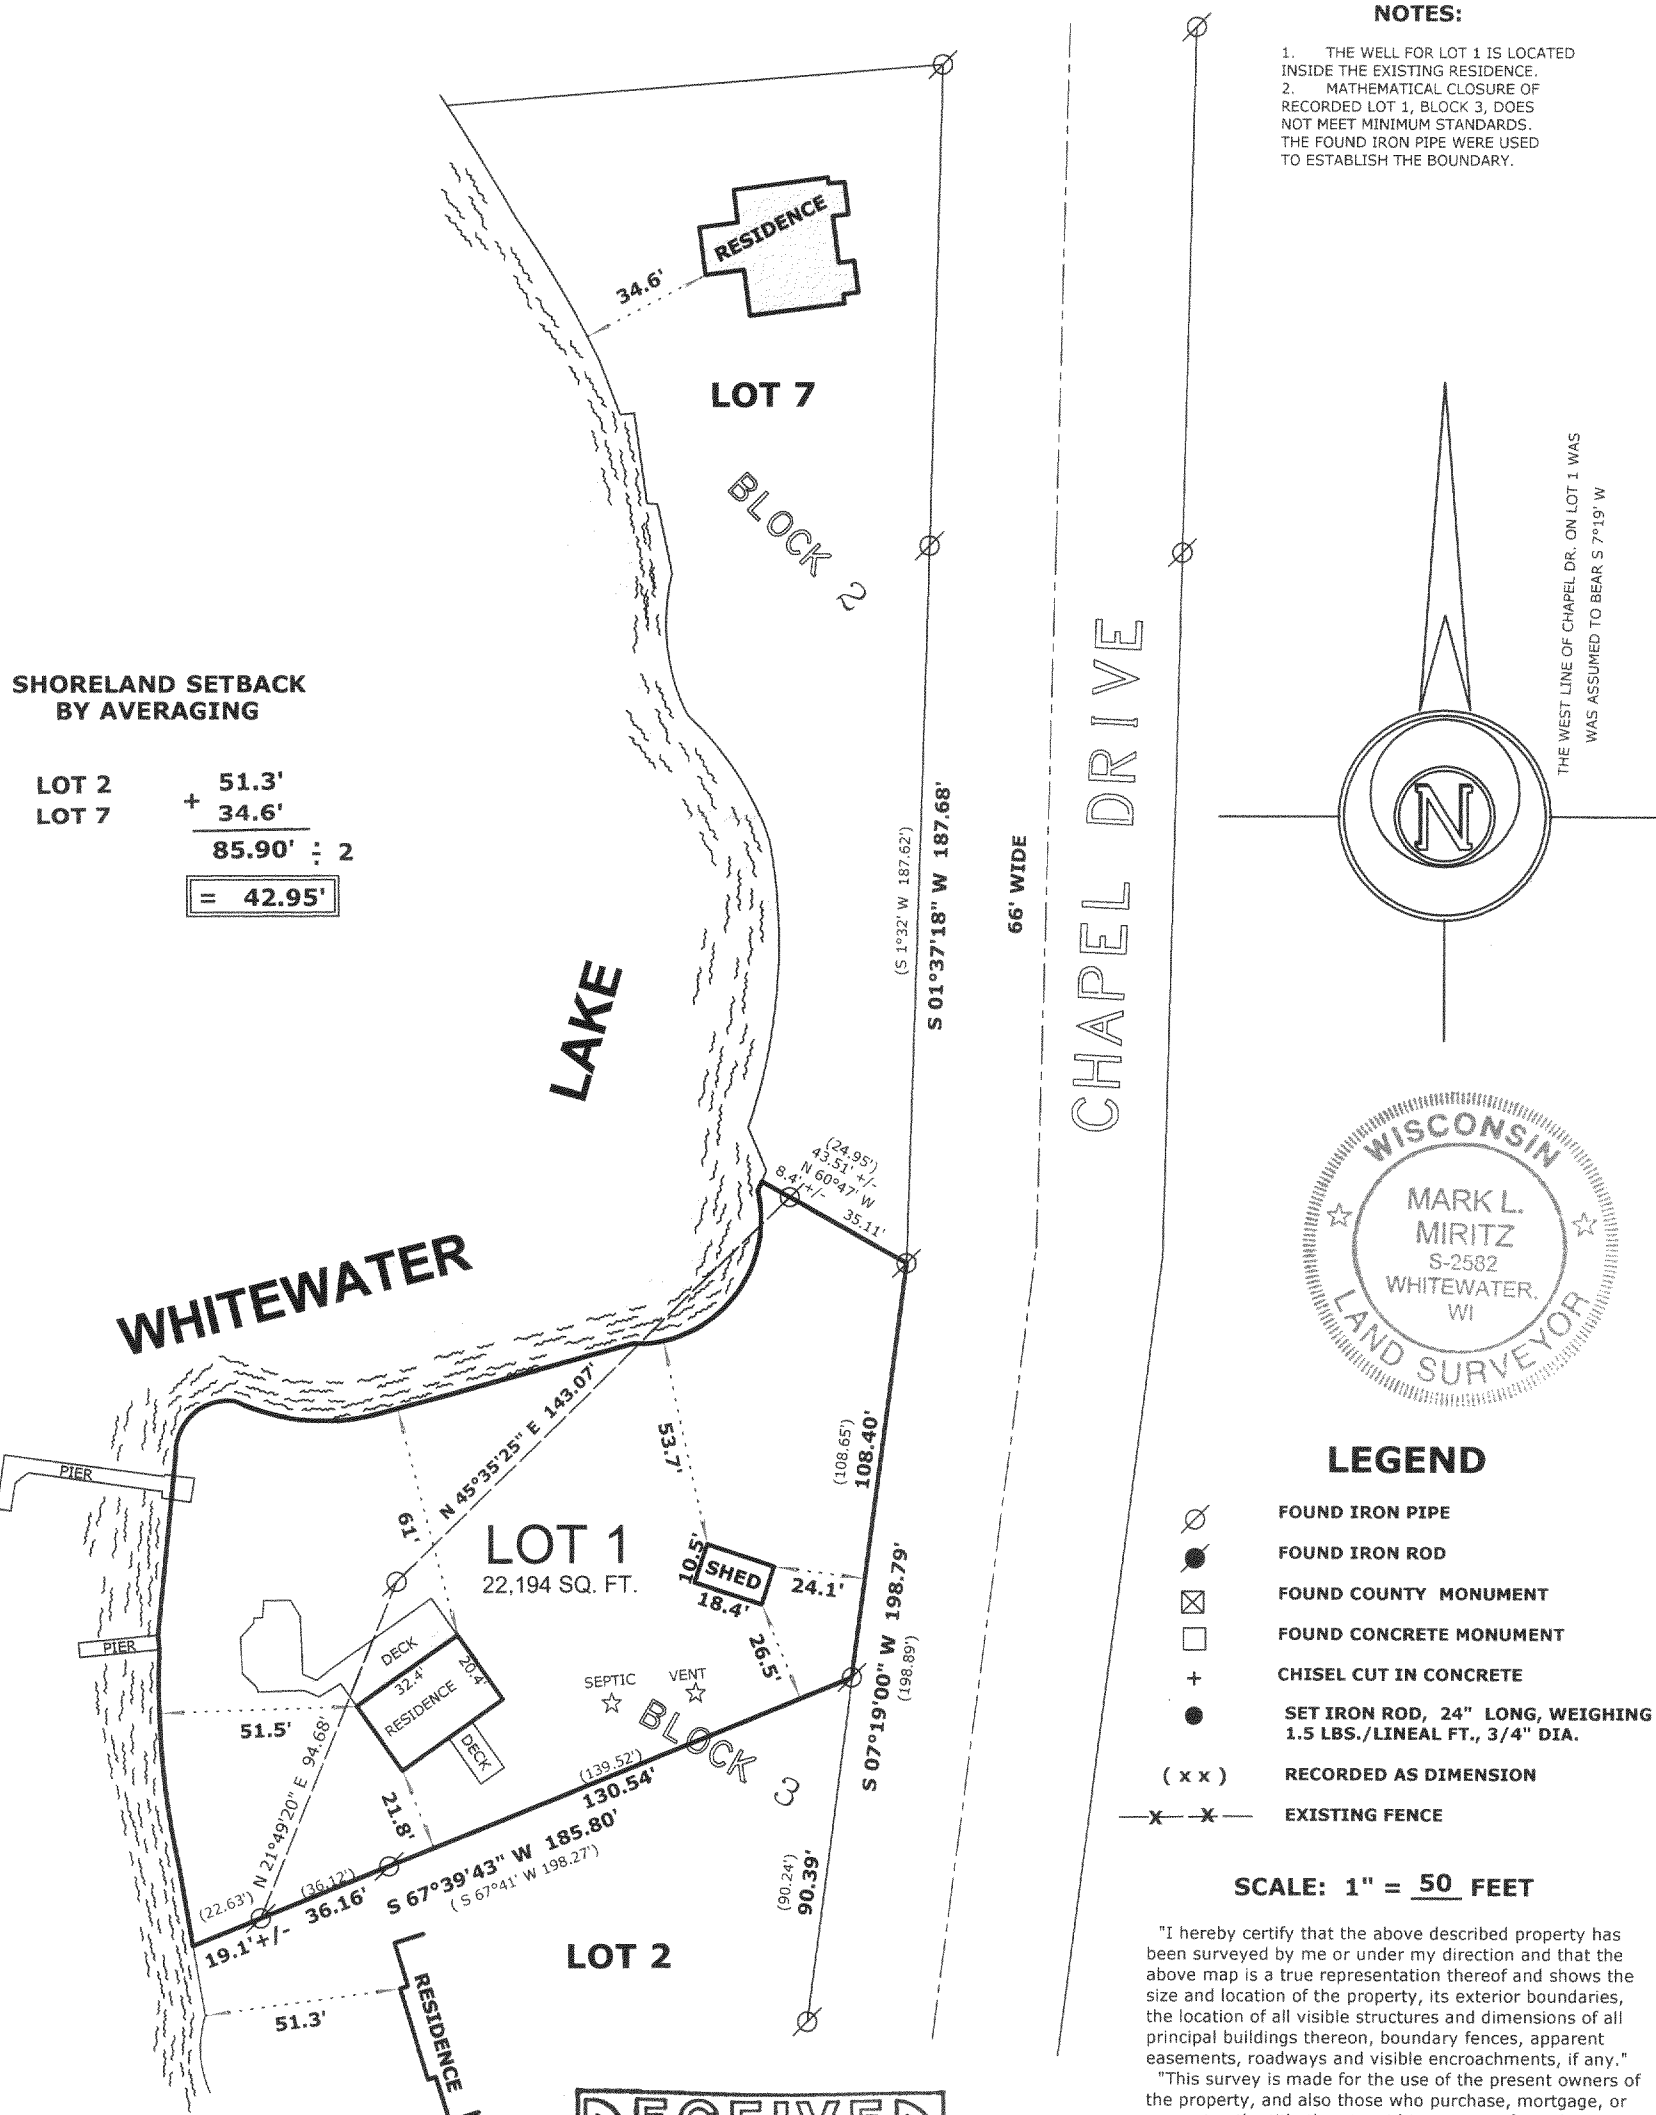

Mark L. Miritz
MARK L. MIRITZ
WISCONSIN REGISTERED
LAND SURVEYOR S-2582
DATE: AUGUST 22, 2004 JOB NO. 04.803

22H 000066

315-875