
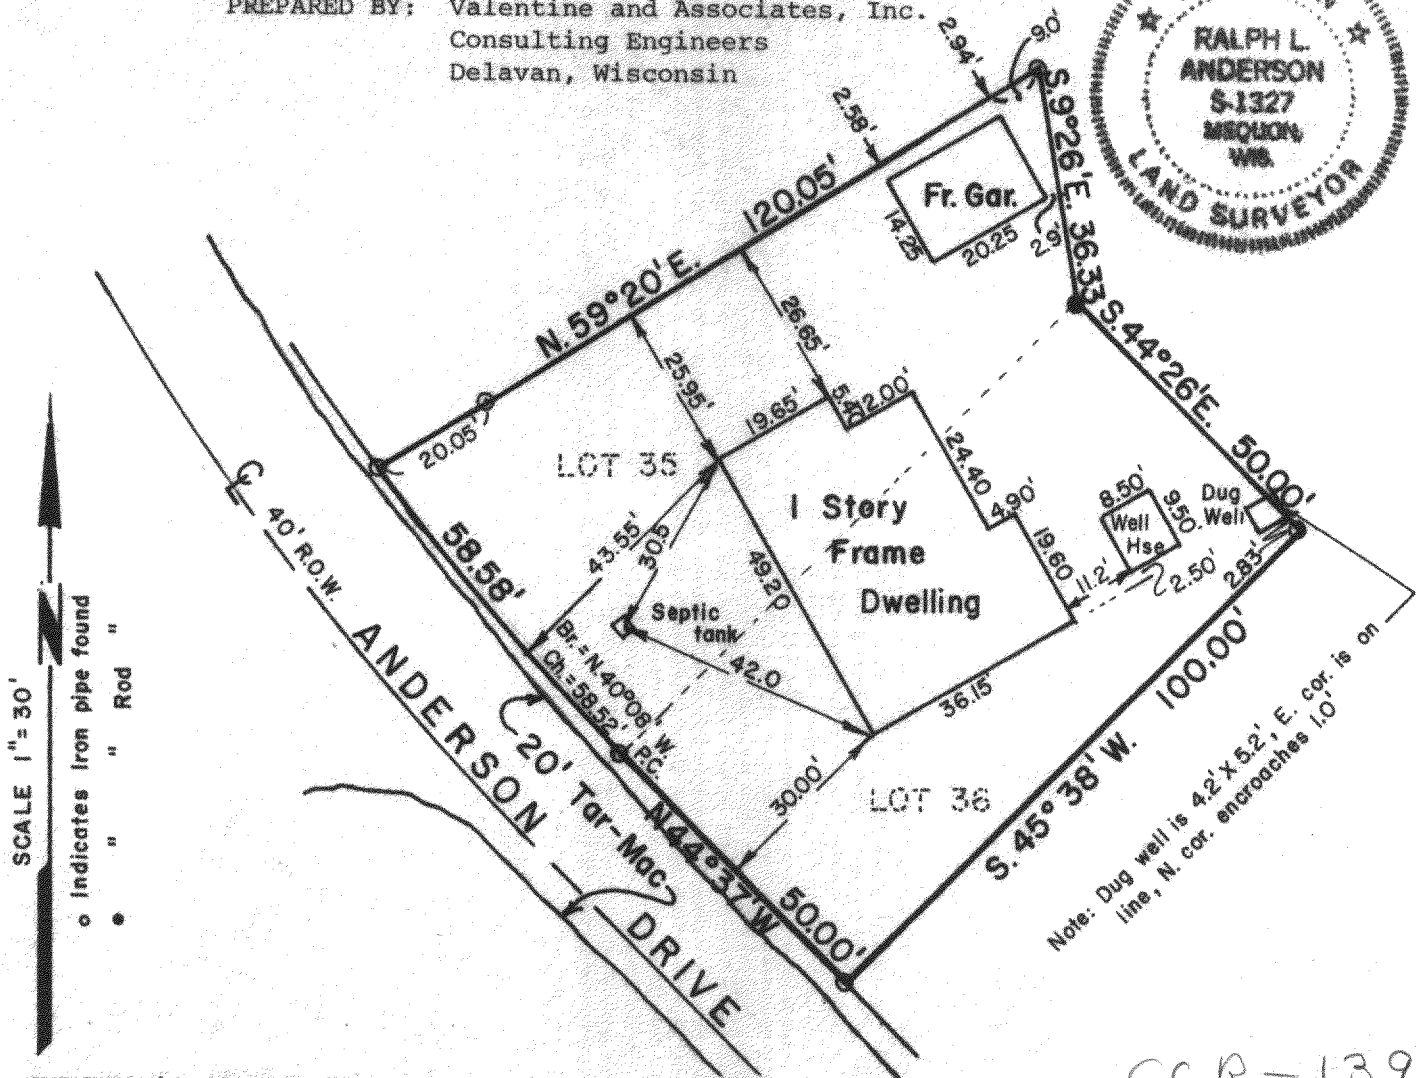


PLAT OF SURVEY

DESCRIPTION: Lots 35 and 36 of Block "G" in CRYSTAL BOWL Subdivision, located in Section 13, T. 3 N., R. 15 E., Richmond Township, Walworth County, Wisconsin.

OWNER: Robert Blankowski
P.O. Box 15145
Milwaukee, Wisconsin 53215

PREPARED BY: Valentine and Associates, Inc.
Consulting Engineers
Delavan, Wisconsin

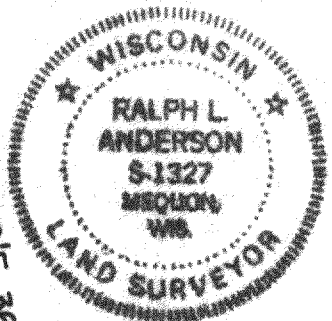

SURVEYOR'S CERTIFICATE:

I have surveyed the above described property and the above map is a true representation thereof and shows the size and location of the property, its exterior boundaries, the location and dimensions of all visible structures thereon, fences, apparent easements and roadways and visible encroachments. This survey is made for the exclusive use of the present owners of the property, and also those who purchase, mortgage, or guarantee the title thereto within one (1) year from date hereof and as to them I warrant the accuracy of said survey and map.

Date 13 August 1976
Job # 7621

Ralph L. Anderson
Ralph L. Anderson, RLS 1327

315-90

CCR-139