

PLAT OF SURVEY

LOT 7 BLOCK 4, CHAPEL HILL SUBDIVISION, LOCATED IN THE SOUTHEAST 1/4 OF THE SOUTHEAST 1/4 OF SECTION 34, TOWN 4 NORTH RANGE 15 EAST, TOWN OF WHITEWATER AND IN THE NORTHEAST 1/4 OF THE NORTHEAST 1/4 AND IN THE EAST 1/2 OF THE SOUTHEAST 1/4 OF THE NORTHEAST 1/4 OF SECTION 3, TOWN 3 NORTH, RANGE 15 EAST, TOWN OF RICHMOND, ALL IN WALWORTH COUNTY, WISCONSIN.

SURVEYED FOR: DENNIS MILLER



CHAPEL DRIVE

CHAPEL DRIVE

WHITEWATER LAKE

SCALE 1"=30'

- FOUND 1" IRON PIPE
- () RECORDED AS DIMENSIONS

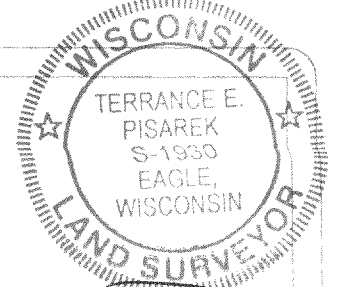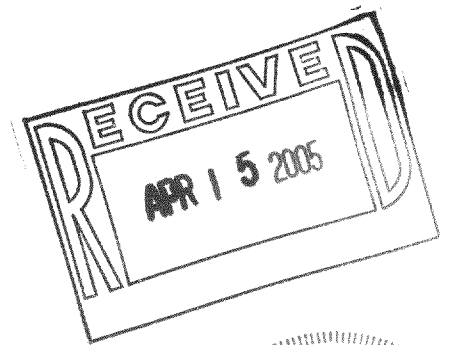

Kettle Moraine Surveying Inc.
P.O. Box 357
Eagle WI. 53119
(262)594-3484

"I hereby certify that I have surveyed the above property and that the above map is a true representation thereof and shows the size and location of the property exterior boundaries, the location of all visible structures and dimensions of all principal buildings thereon, boundary fences, apparent easements, roadways and encroachments if any."
"This survey is made for the use of the present owners of the property, and also those who purchase, mortgage or guarantee the title thereto within one year from date hereof."

THIS IS NOT AN ORIGINAL SURVEY UNLESS THE SEAL IS RED

4/6/05
DATE

TEP/DW
FIELD WORK BY

TEP
DRAWN BY

05036
JOB NUMBER