

FARRIS, HANSEN & ASSOCIATES, INC.

ENGINEERING — ARCHITECTURE — SURVEYING
7 RIDGWAY COURT — P.O. BOX 437 — ELKHORN, WISCONSIN 53121
PHONE: (262) 723-2098 FAX: (262) 723-5886

PLAT OF SURVEY

LOTS 8 THRU 13 OF BLOCK H
OF CRYSTAL BOWL SUBDIVISION
LOCATED IN PART OF THE NE 1/4 OF
THE NW 1/4 OF SECTION 13, TOWN 3 NORTH,
RANGE 15 EAST, WALWORTH COUNTY, WISCONSIN

ASSIGNED EAST LINE OF KENOSHA DRIVE
N 00°02'00" E

MAP SCALE IN FEET ORIGINAL 1" = 30'

— WORK ORDERED BY —
PAUL DEMCHENKO
W4724 S. LAKESHORE DRIVE
FONTANA, WI 53125


- LEGEND
- = SET IRON REBAR STAKE
 - = FOUND IRON PIPE STAKE
 - = FOUND IRON REBAR STAKE
 - △ = FOUND 60 PENNY NAIL IN RAILROAD TIE
 - (XXX) = RECORDE AS

FOUND IRON REBAR STAKE
0.29' WEST OF LOT LINE

NOTE:
EASEMENT REC. AS DOC. 334211 ALLOWS FOR POWER
POLES AND OVERHEAD WIRES TO EXIST IN THE ROADWAYS
FOR CRYSTAL BOWL SUBDIVISION.

40' WIDE R.O.W.

KENOSHA DRIVE

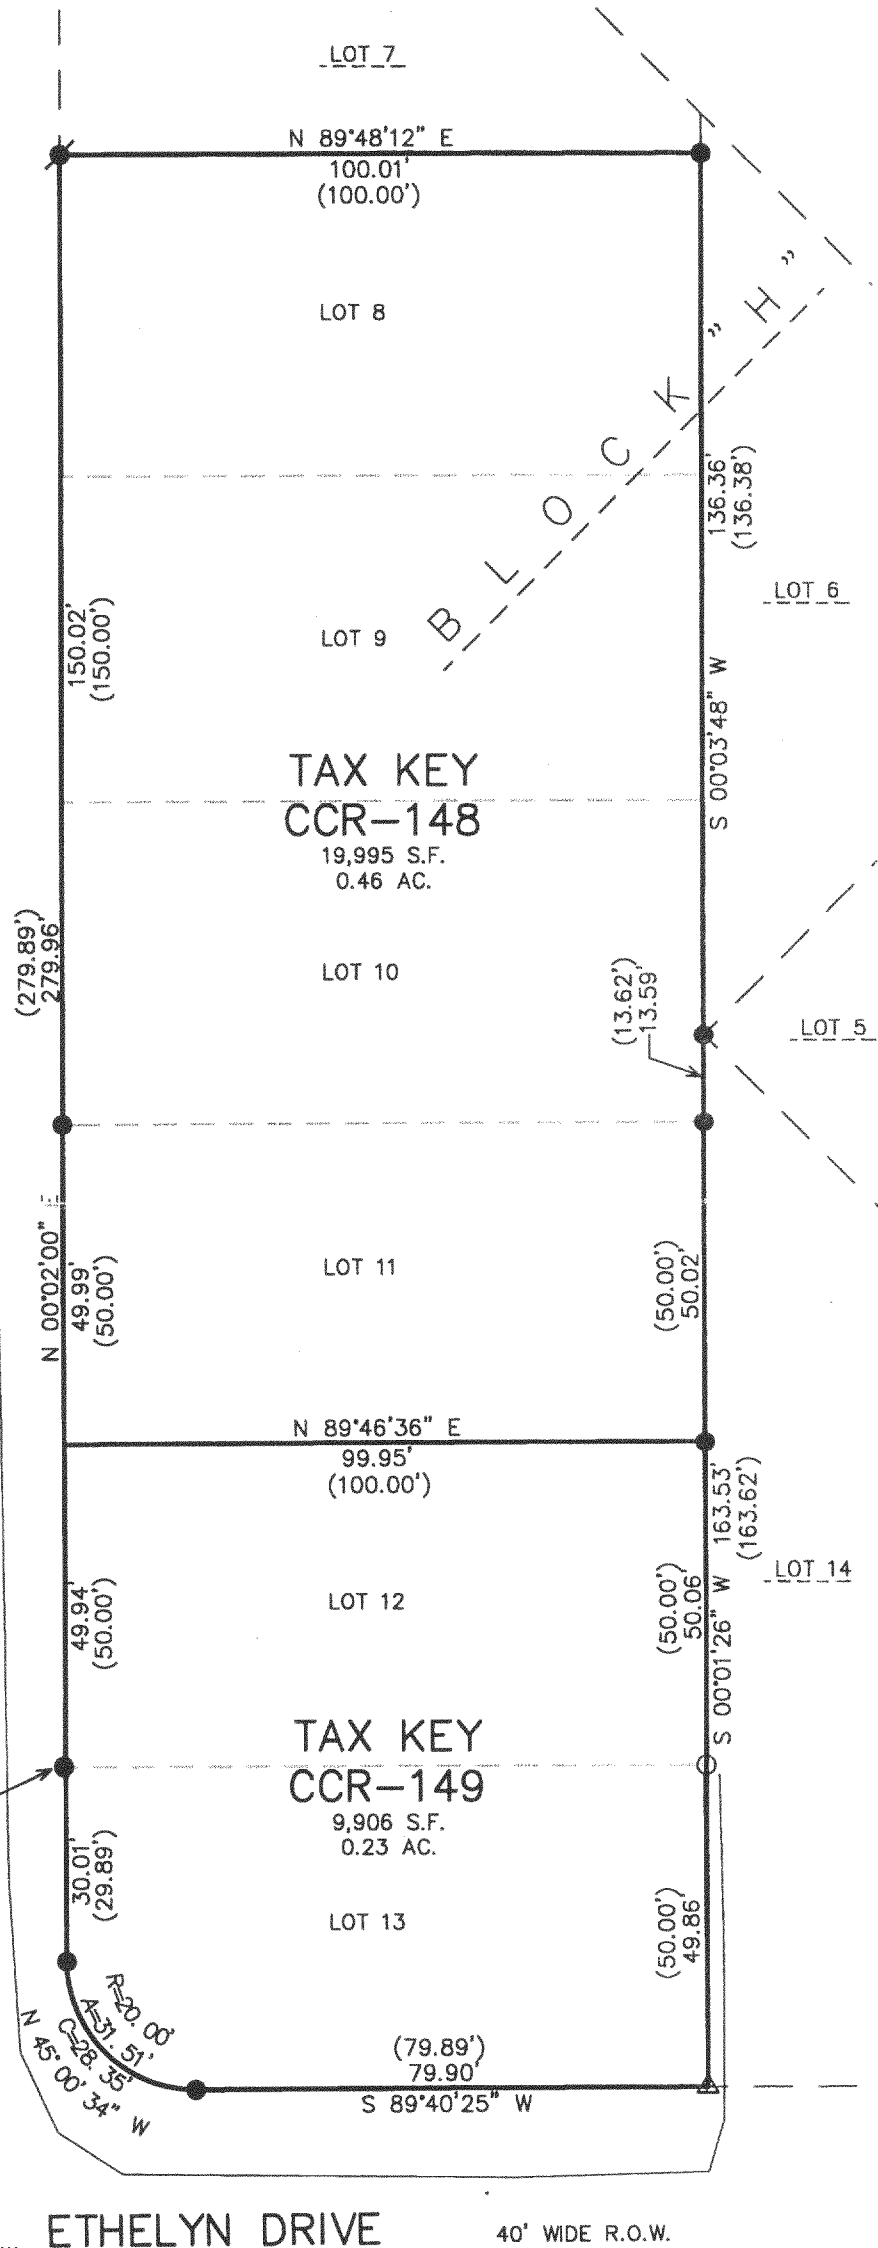

NOTE: COPIES OF THIS MAP TO WHICH THE FOLLOWING CERTIFICATE WILL APPLY SHOW
THE SURVEYOR'S ORIGINAL SEAL AND SIGNATURE IN RED INK. COPIES BY ANY OTHER
MEANS MAY HAVE ALTERATIONS WHICH DO NOT REPRESENT THE SURVEYOR'S WORK
PRODUCT.

I HEREBY CERTIFY THAT THE ABOVE DESCRIBED PROPERTY HAS BEEN SURVEYED UNDER
MY DIRECTION AND THAT THE ABOVE MAP IS A TRUE REPRESENTATION THEREOF AND
SHOWS THE SIZE AND LOCATION OF THE PROPERTY, ITS EXTERIOR BOUNDARIES, THE
LOCATION OF ALL VISIBLE STRUCTURES, AND DIMENSIONS OF ALL PRINCIPLE
BUILDINGS THEREON, BOUNDARY FENCES, APPARENT EASEMENTS, ROADWAYS, AND
VISIBLE ENCROACHMENTS, IF ANY. THIS SURVEY IS MADE FOR THE USE OF THE
PRESENT OWNERS OF THE PROPERTY, AND ALSO THOSE WHO PURCHASE, MORTGAGE, OR
GUARANTEE THE TITLE THERETO WITHIN ONE YEAR FROM THE DATE HEREOF.

DATED: OCTOBER 25, 2005

PETER S. GORDON

PROJECT: 6904
DATE: 10/25/2005
SHEET 1 OF 1

10/31/2005 X:\Projects\6904\Dead\TTLESUR

CCR-149 CCR-148

315-941