

HAROLD H. KOLB

REGISTERED PROFESSIONAL LAND SURVEYOR
LAKE GENEVA, WISCONSIN

PLAT OF SURVEY OF
The Easterly line of Lot 4, Oak
Knoll Subdivision, located in
Section 3, T36, R15E, Walworth
County, Wisconsin.

Owner: Margaret Priestag

Accuracy: Distances $\pm 0.01'$
Angles $\pm 30''$


Note: Readings are assumed
as recorded.



SCALE 1" = 60'

LEGEND

- ◆ - IRON PIPE FOUND
- - IRON PIPE PLACED
- - CONCRETE MONUMENT
- ✕ - SPIKE

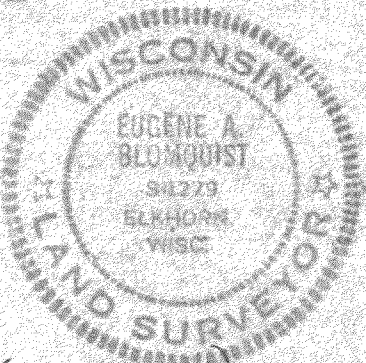

I, EUGENE A. BLUMQUIST DO HEREBY CERTIFY THAT I HAVE
SURVEYED THE PROPERTY HEREON DESCRIBED ACCORDING
TO THE OFFICIAL RECORDS, AND THAT THE PLAT HEREON
IS A CORRECT REPRESENTATION OF THE LOT LINES.

EUGENE A. BLUMQUIST
WISCONSIN REGISTERED LAND SURVEYOR, 8-1279

DATE

Sept 21, 1976

COX-3 (2 Line 12 4)

315-95

