

LAND-MARK SURVEYING

Mark L. Miritz


Wisconsin Registered Land Surveyor S-2582

N9330 Knuteson Drive
Whitewater, WI 53190
Phone: (262) 495-3284
FAX: (262) 495-8421
LAND-MARKSURVEYING.COM

ORDERED BY: CAROL STANZEAK
COLDWELL BANKER
PRIMUS REALTY
1823 E. GENEVA ST.
SUITE K
DELAVER, WI 53115



OWNERS: SCOTT W. BARRETT
LAURIE M. BARRETT
996 CEDAR DR.
BURLINGTON, WI. 53105

OAK ROAD
UNIMPROVED
30' WIDE

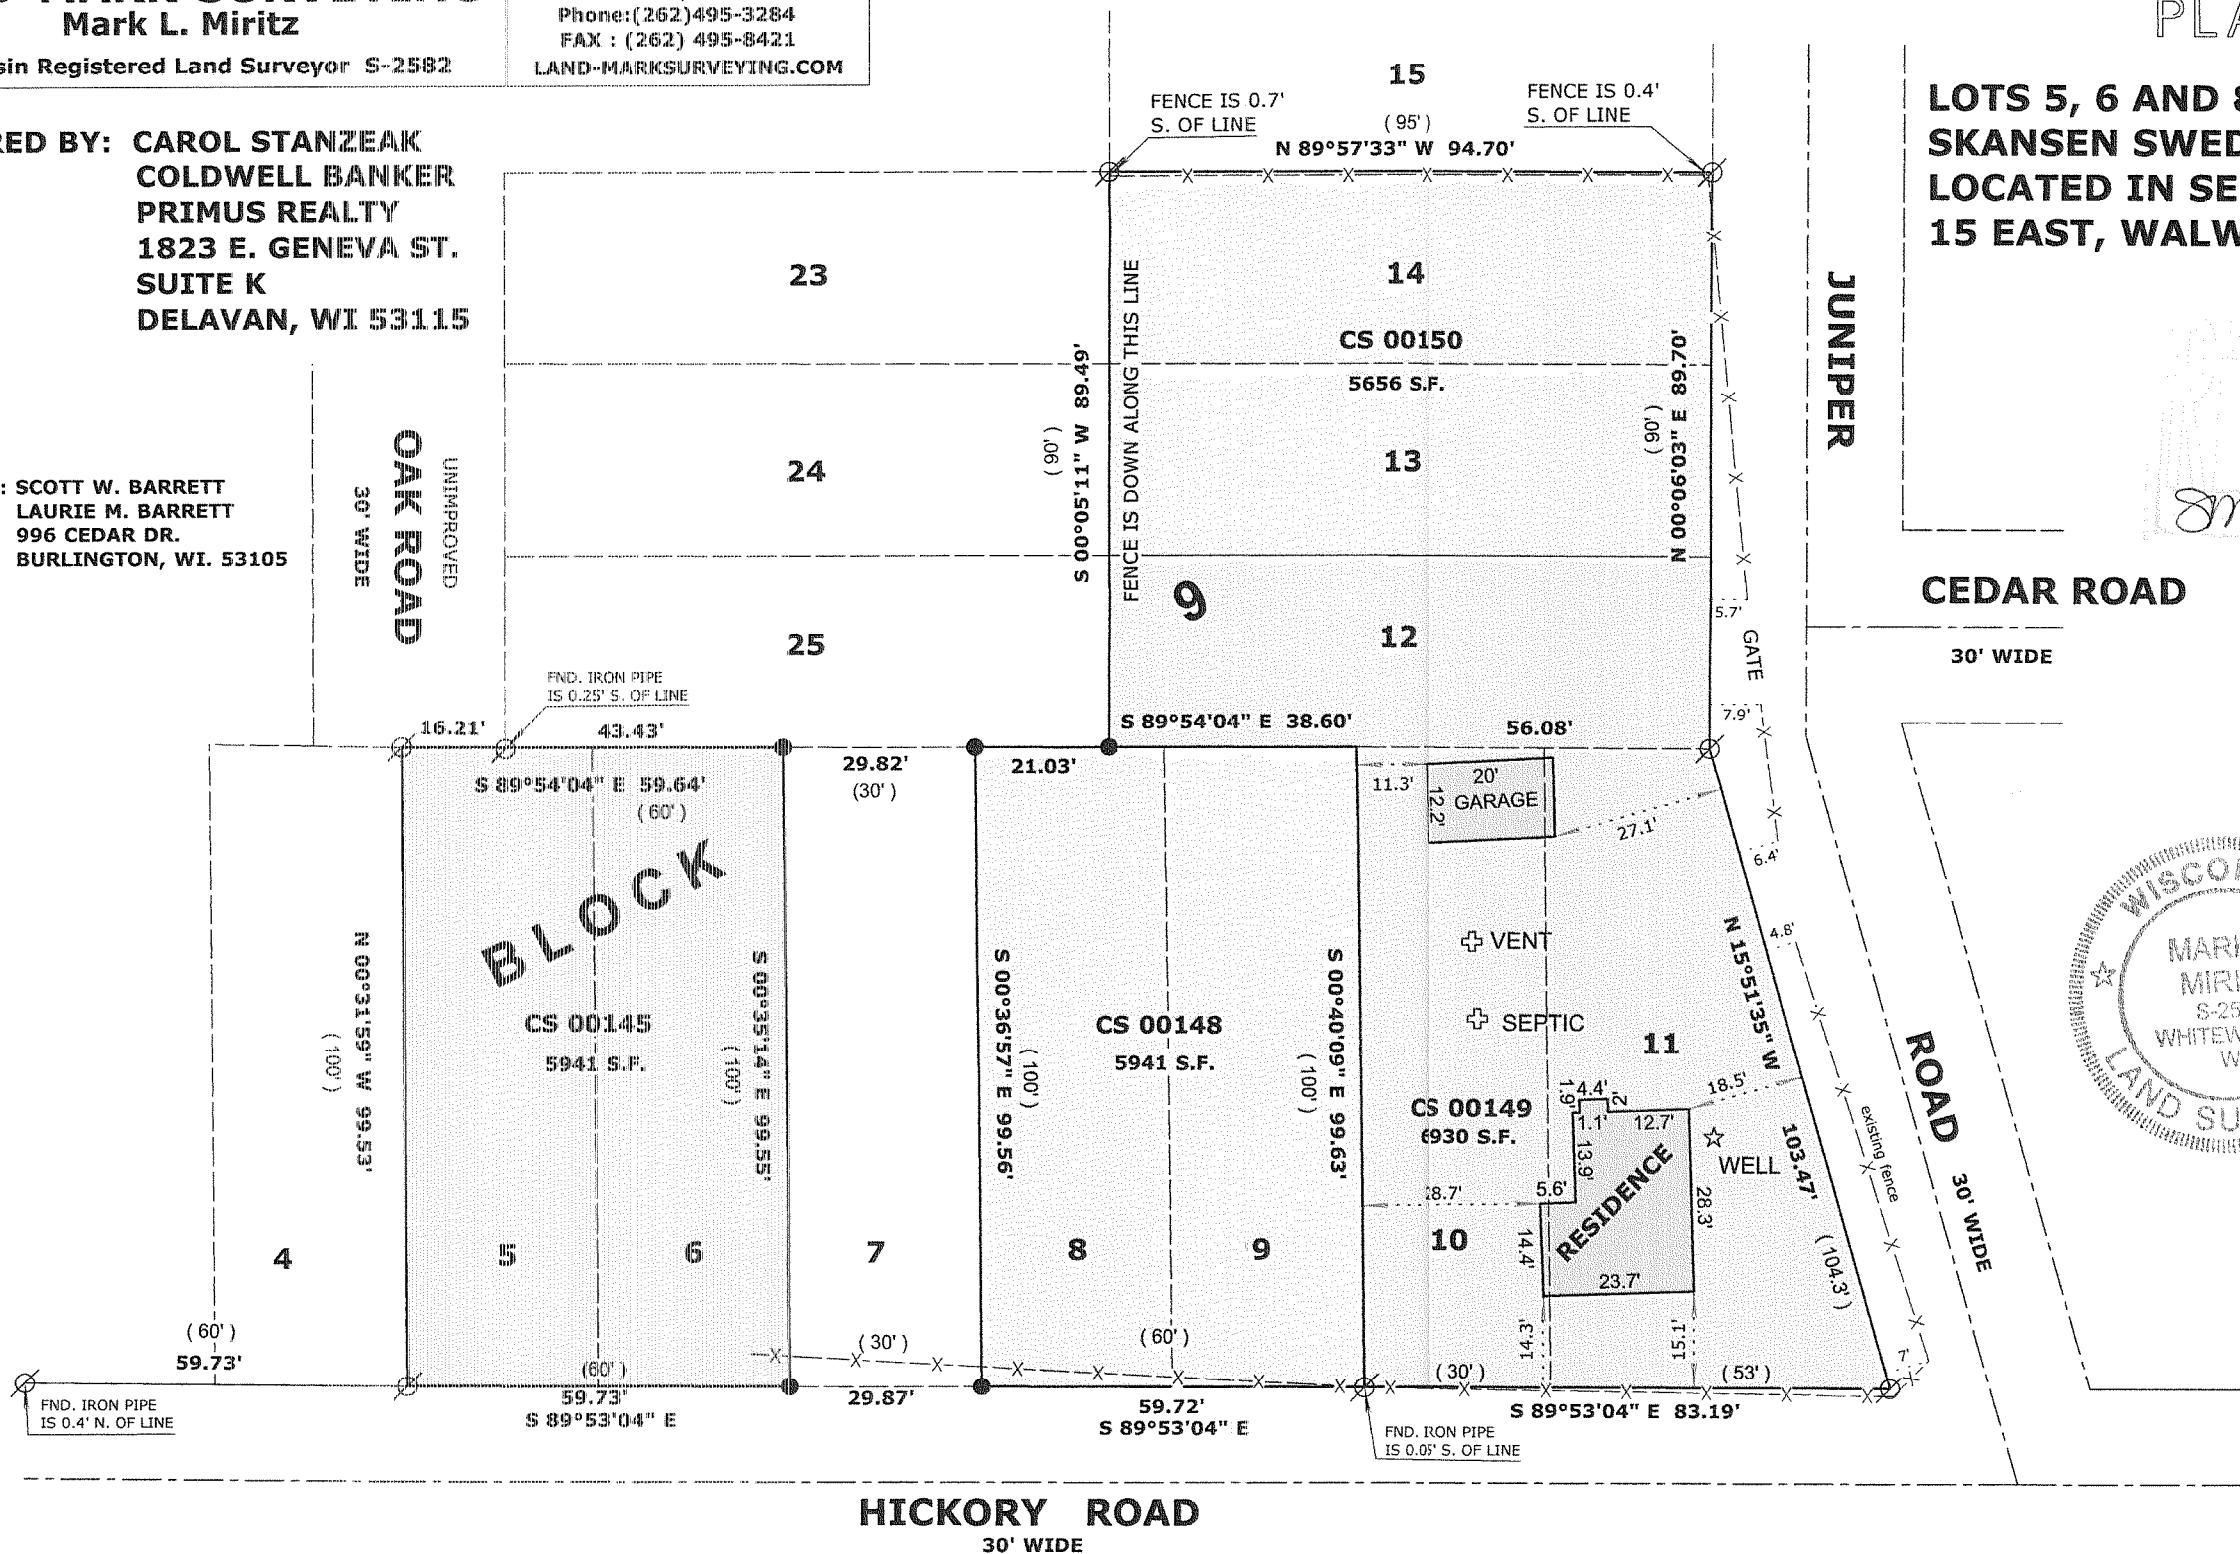

PLAT OF SURVEY

LOTS 5, 6 AND 8-14 INCLUSIVE OF BLOCK 9 OF
SKANSEN SWEDISH TRIBUNE NEWS SUBDIVISION,
LOCATED IN SECTION 9, TOWN 3 NORTH, RANGE
15 EAST, WALWORTH COUNTY, WISCONSIN.

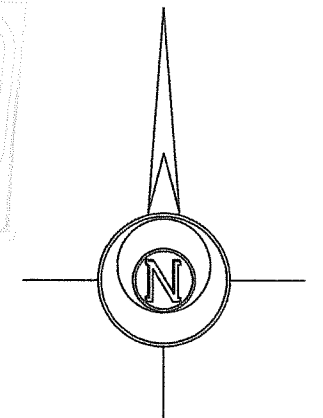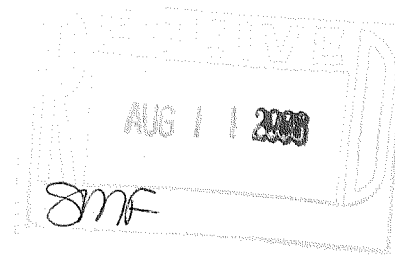

BEARINGS ARE BASED ON PREVIOUS SURVEYS OF RECORD

LEGEND

- FOUND IRON PIPE
- FOUND IRON ROD
- FOUND COUNTY MONUMENT
- FOUND CONCRETE MONUMENT
- CHISEL CUT IN CONCRETE
- SET IRON ROD, 24" LONG, WEIGHING 1.5 LBS./LINEAL FT., 3/4" DIA.
- (x x) RECORDED AS DIMENSION
- EXISTING FENCE

SCALE: 1" = 30 FEET

"I hereby certify that the above described property has been surveyed by me or under my direction and that the above map is a true representation thereof and shows the size and location of the property, its exterior boundaries, the location of all visible structures and dimensions of all principal buildings thereon, boundary fences, apparent easements, roadways and visible encroachments, if any."

"This survey is made for the use of the present owners of the property, and also those who purchase, mortgage, or guarantee the title thereto within one year from date hereof."

Mark L. Miritz
MARK L. MIRITZ
WISCONSIN REGISTERED
LAND SURVEYOR S-2582

DATE: AUG. 8, 2006 JOB NO. 06.803

CS 145 CS 148

315-983