

ABELL  
SURVEYING & MAPPING

1140 SEQUOIA STREET • DELAVAN, WISCONSIN 53115  
262-728-6737

SHORE WOOD TERRACE

PLAT OF SURVEY OF

LOT 14, BLOCK B, CRYSTAL BOWL SUBDIVISION,  
LOCATED IN T3N.R15E, WALWORTH COUNTY,  
WISCONSIN.

ORDERED BY: ANDREW CLIFFGARD  
W7648 TURTLE LAKE ROAD  
DELAVAN, WI 53115


LOT 15

LOT 13

LOT 14

0.17 ACRES

BLOCK

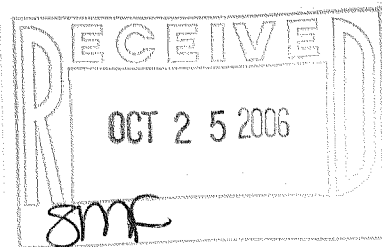

N



SCALE 1"=20'

LEGEND

- - IRON ROD FOUND
- △ - UTILITY POLE
- - OVERHEAD UTILITY LINES
- ( ) - RECORDED AS


I HEREBY CERTIFY THAT I HAVE SURVEYED THE ABOVE DESCRIBED PROPERTY AND THAT THE ABOVE MAP IS A TRUE REPRESENTATION THEREOF AND SHOWS THE SIZE AND LOCATION OF THE PROPERTY, ITS EXTERIOR BOUNDARIES, THE LOCATION OF ALL VISIBLE STRUCTURES AND DIMENSIONS OF ALL PRINCIPAL BUILDINGS THEREON, BOUNDARY FENCES, APPARENT EASEMENTS, ROADWAYS AND VISIBLE ENCROACHMENTS, IF ANY, TO THE BEST OF MY KNOWLEDGE AND BELIEF.

THIS SURVEY IS MADE FOR THE USE OF THE PRESENT OWNERS OF THE PROPERTY, AND ALSO THOSE WHO PURCHASE, MORTGAGE, OR GUARANTEE THE TITLE THERETO WITHIN ONE (1) YEAR FROM DATE HEREON.

DAVID F. ABELL  
WISCONSIN REGISTERED LAND SURVEYOR, S-1596

July 11, 2006

DATE JOB NUMBER - 06066  
NOTE: THIS IS NOT A CERTIFIED COPY UNLESS SEALED.

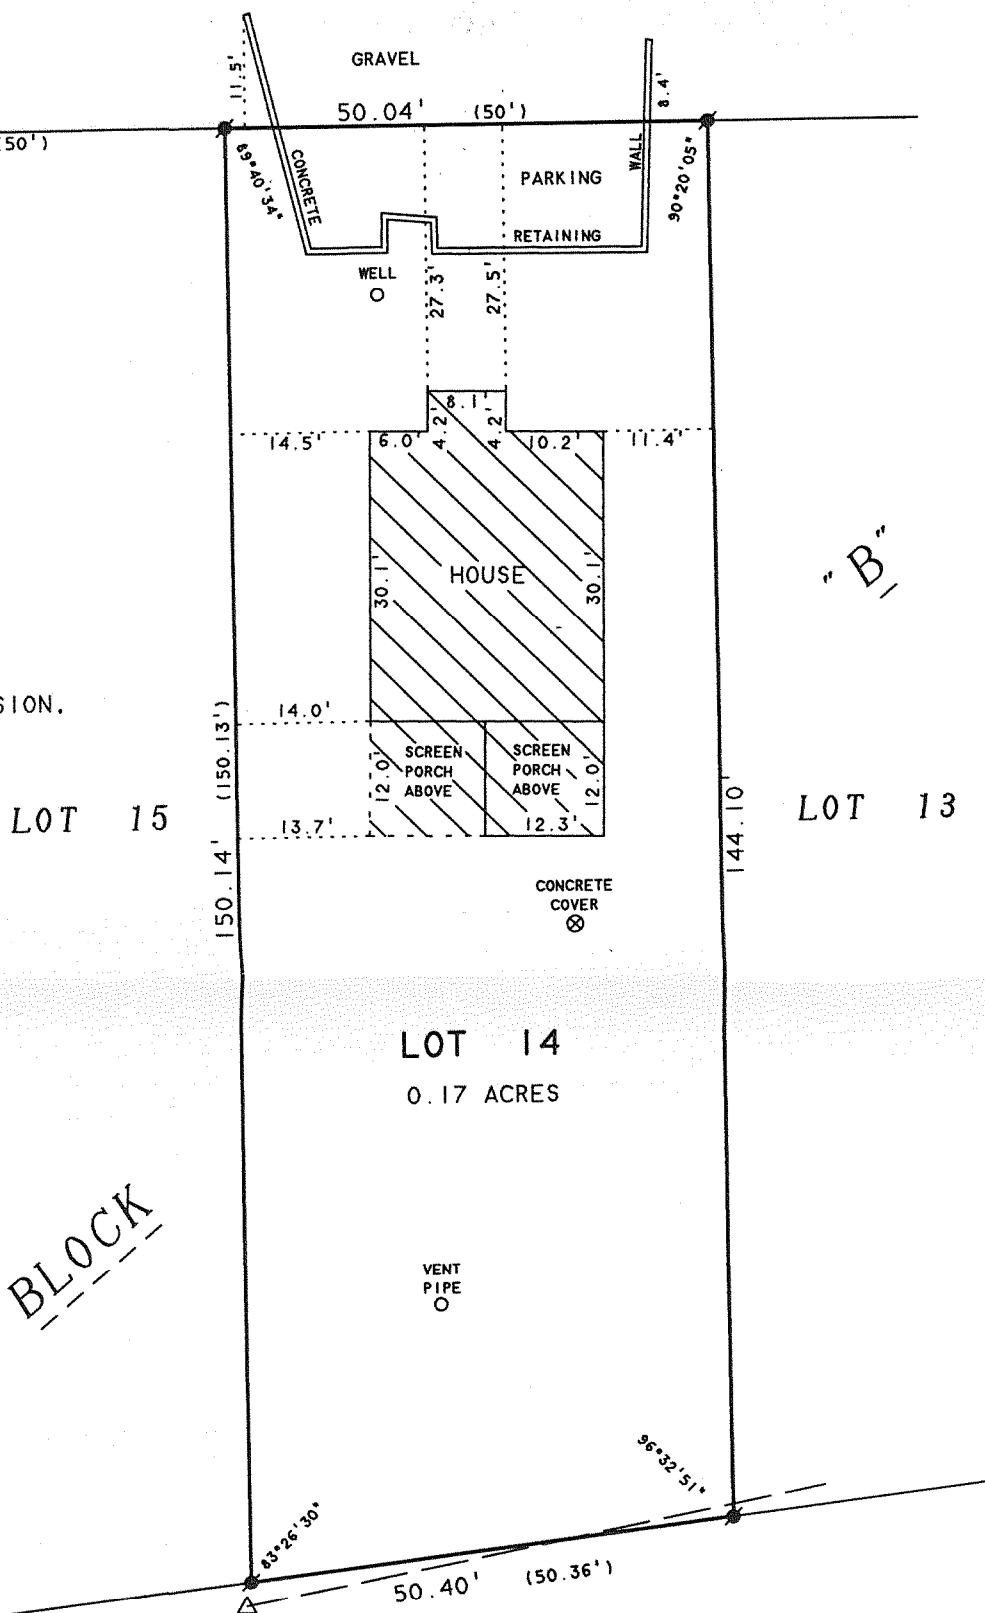

CCR-25

315-993