


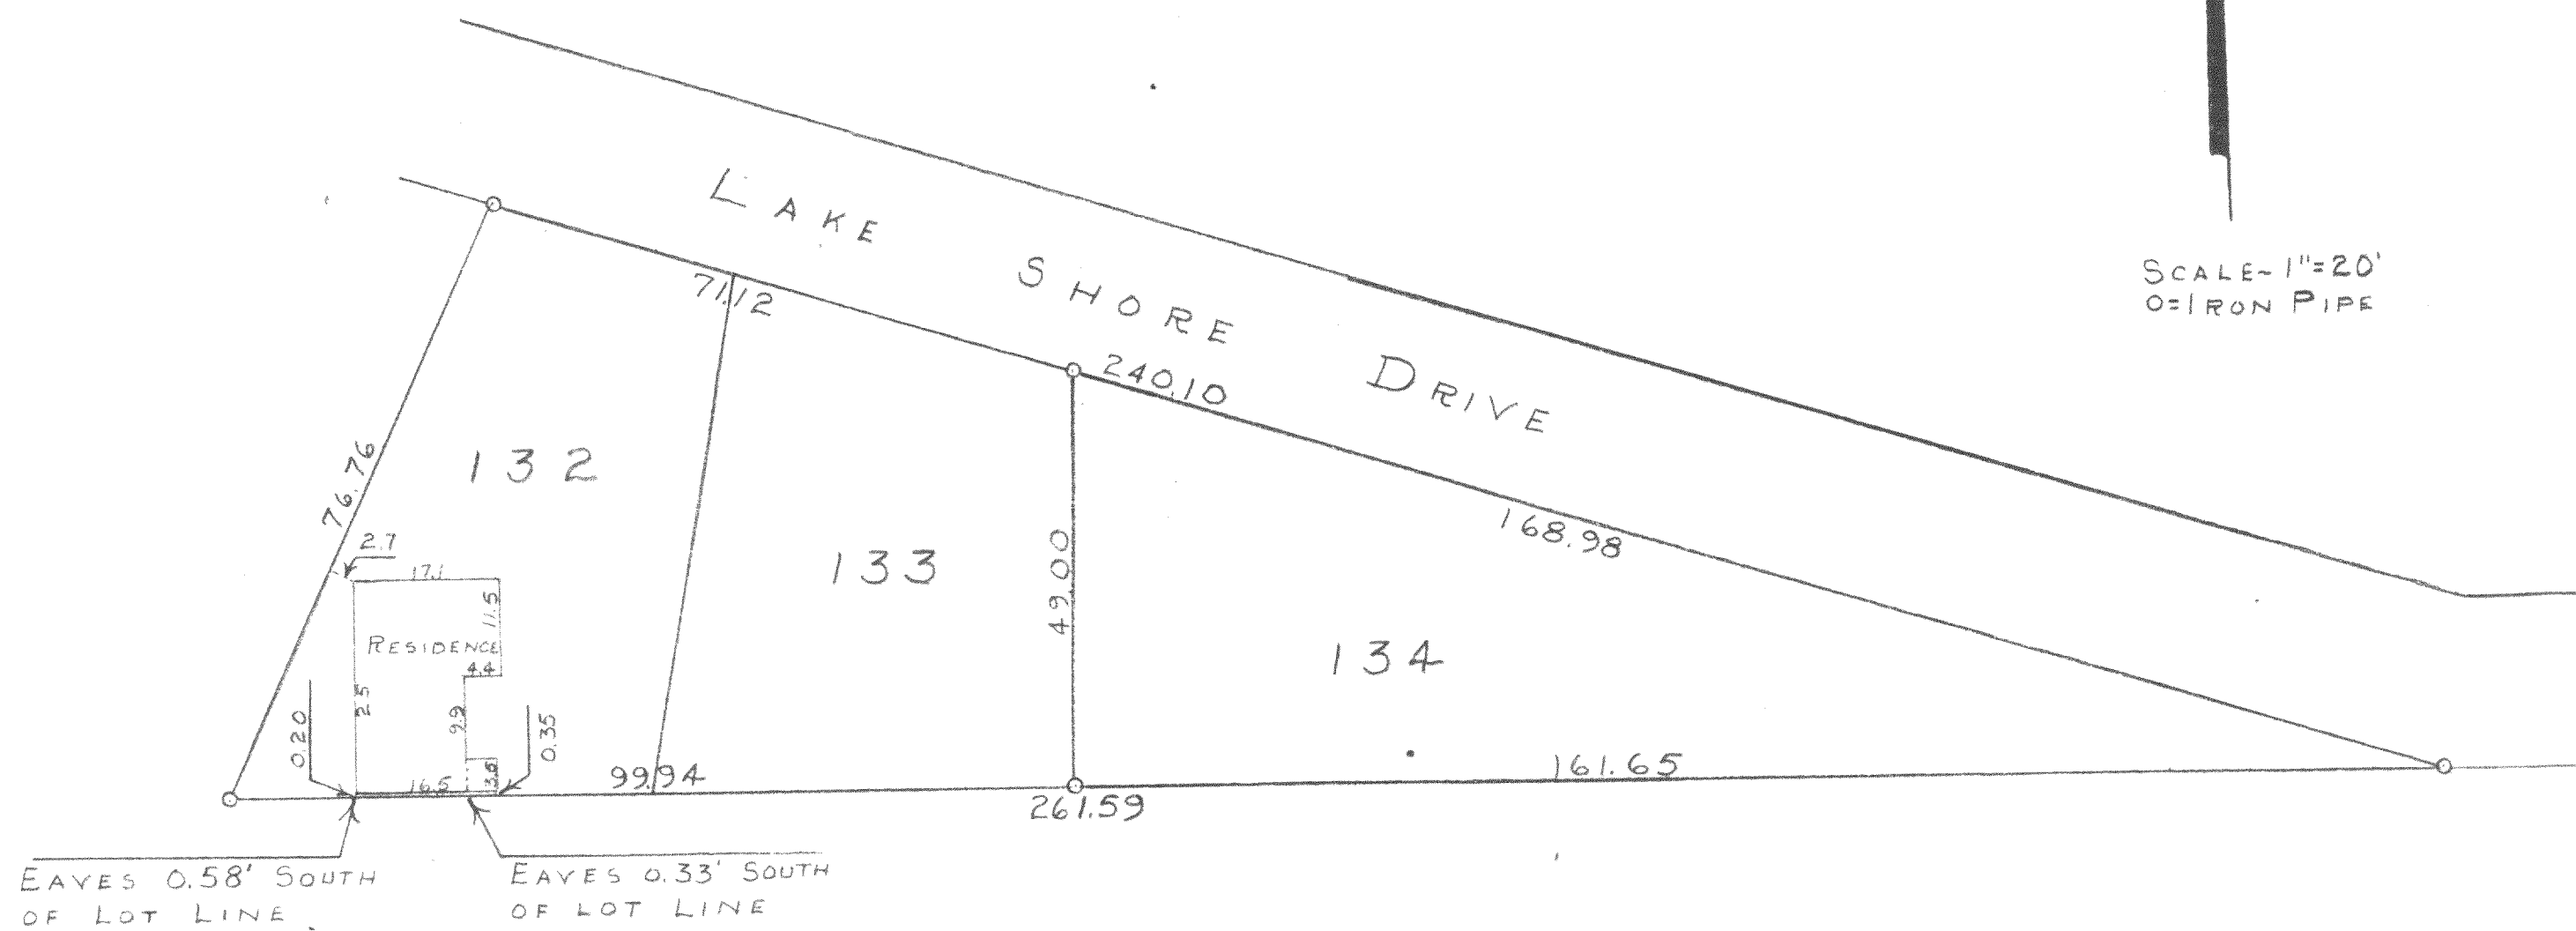

PLAT OF SURVEY OF LOTS 132-134, BLOCK "A", NORTH LAKE BEACH
TRACT NO. 3 LOCATED IN SECTION 5, T3N R16E OF WALWORTH
COUNTY, WISCONSIN
NOV. 10, 1954

George T. Dunham
GEORGE T. DUNHAM, SURVEYOR
DELAVER, WISCONSIN