

PLAT OF SURVEY

PREPARED FOR: CAREFREE HOMES



LOCATION: Clearwater Lane, Sugar Creek, Wisconsin

LEGAL DESCRIPTION: Lot 23 LAUDERDALE LAKES ESTATES a condominium located in the NW 1/4 and SW 1/4 of the SE 1/4 of Section 1 and the NW 1/4 of the NE 1/4 of Section 12, Town 3 North, Range 16 East, Town of Sugar Creek, Walworth County, Wisconsin.


January 12, 1998

Survey No. 980001

CLEARWATER LANE

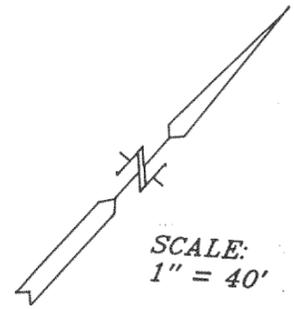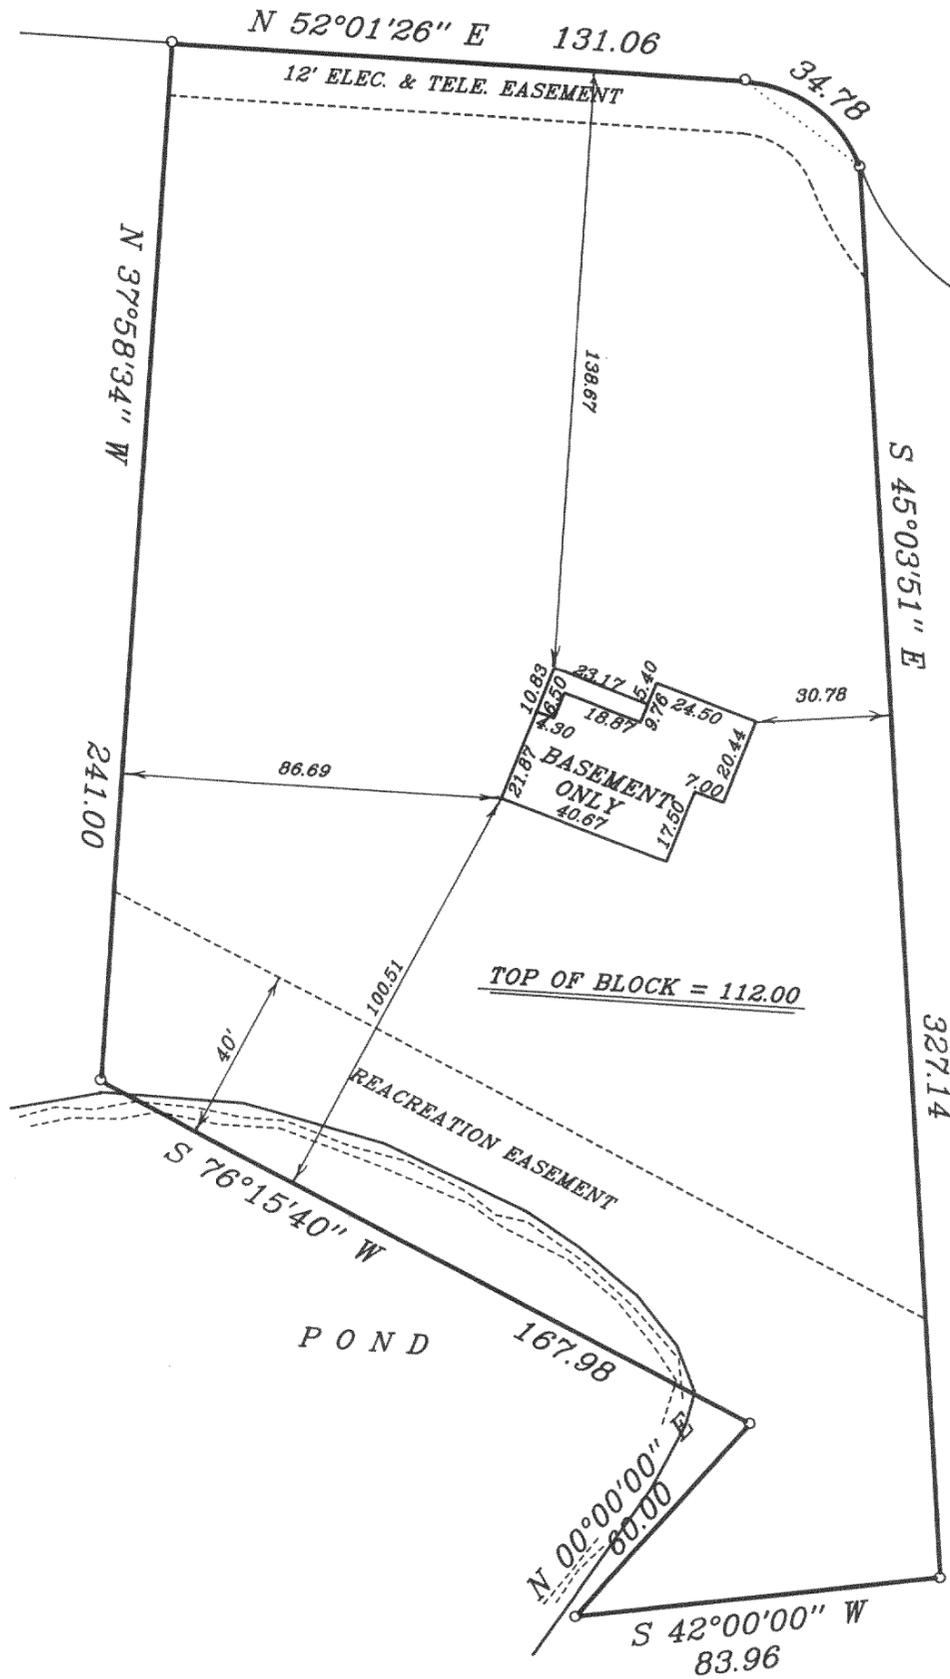

316-1005
GLE-2

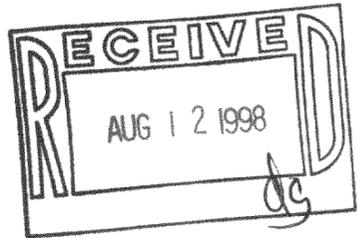

I hereby certify that I have surveyed the above described property and the above map is a true representation thereof and shows the size and location of the property, its exterior boundaries, the location of all visible structures and dimensions of all principal buildings thereon, boundary fences, apparent easements, roadway and visible encroachments, if any. This survey is made for the present owners of the property, and also those who purchase, mortgage or otherwise guarantee the title thereto within one (1) year from date hereof.

Christopher J. Kunkel
CHRISTOPHER J. KUNKEL, REGISTERED LAND SURVEYOR S-1755

METROPOLITAN ENGINEERING, INC.
20875 CROSSROADS CIRCLE, SUITE 150, WAUKESHA, WI 53186
PH. (414) 782-2221 FAX 782-4426