

ABERNATHY and ASSOCIATES


Kenneth B. Abernathy Jr.

Wisconsin Registered Land Surveyor S-1594

Rt. 3, Box 273
Elkhorn, Wisconsin 53121
Phone: (414) 723 4260 (office)
(414) 723 7209 (FAX)


PLAT OF SURVEY

LOTS 3 AND 4, BLOCK 12, BLUE WING ESTATES, LOCATED
IN SECTION 5, TOWN 3 NORTH, RANGE 16 EAST, SUGAR
CREEK TOWNSHIP, WALWORTH COUNTY, WISCONSIN.

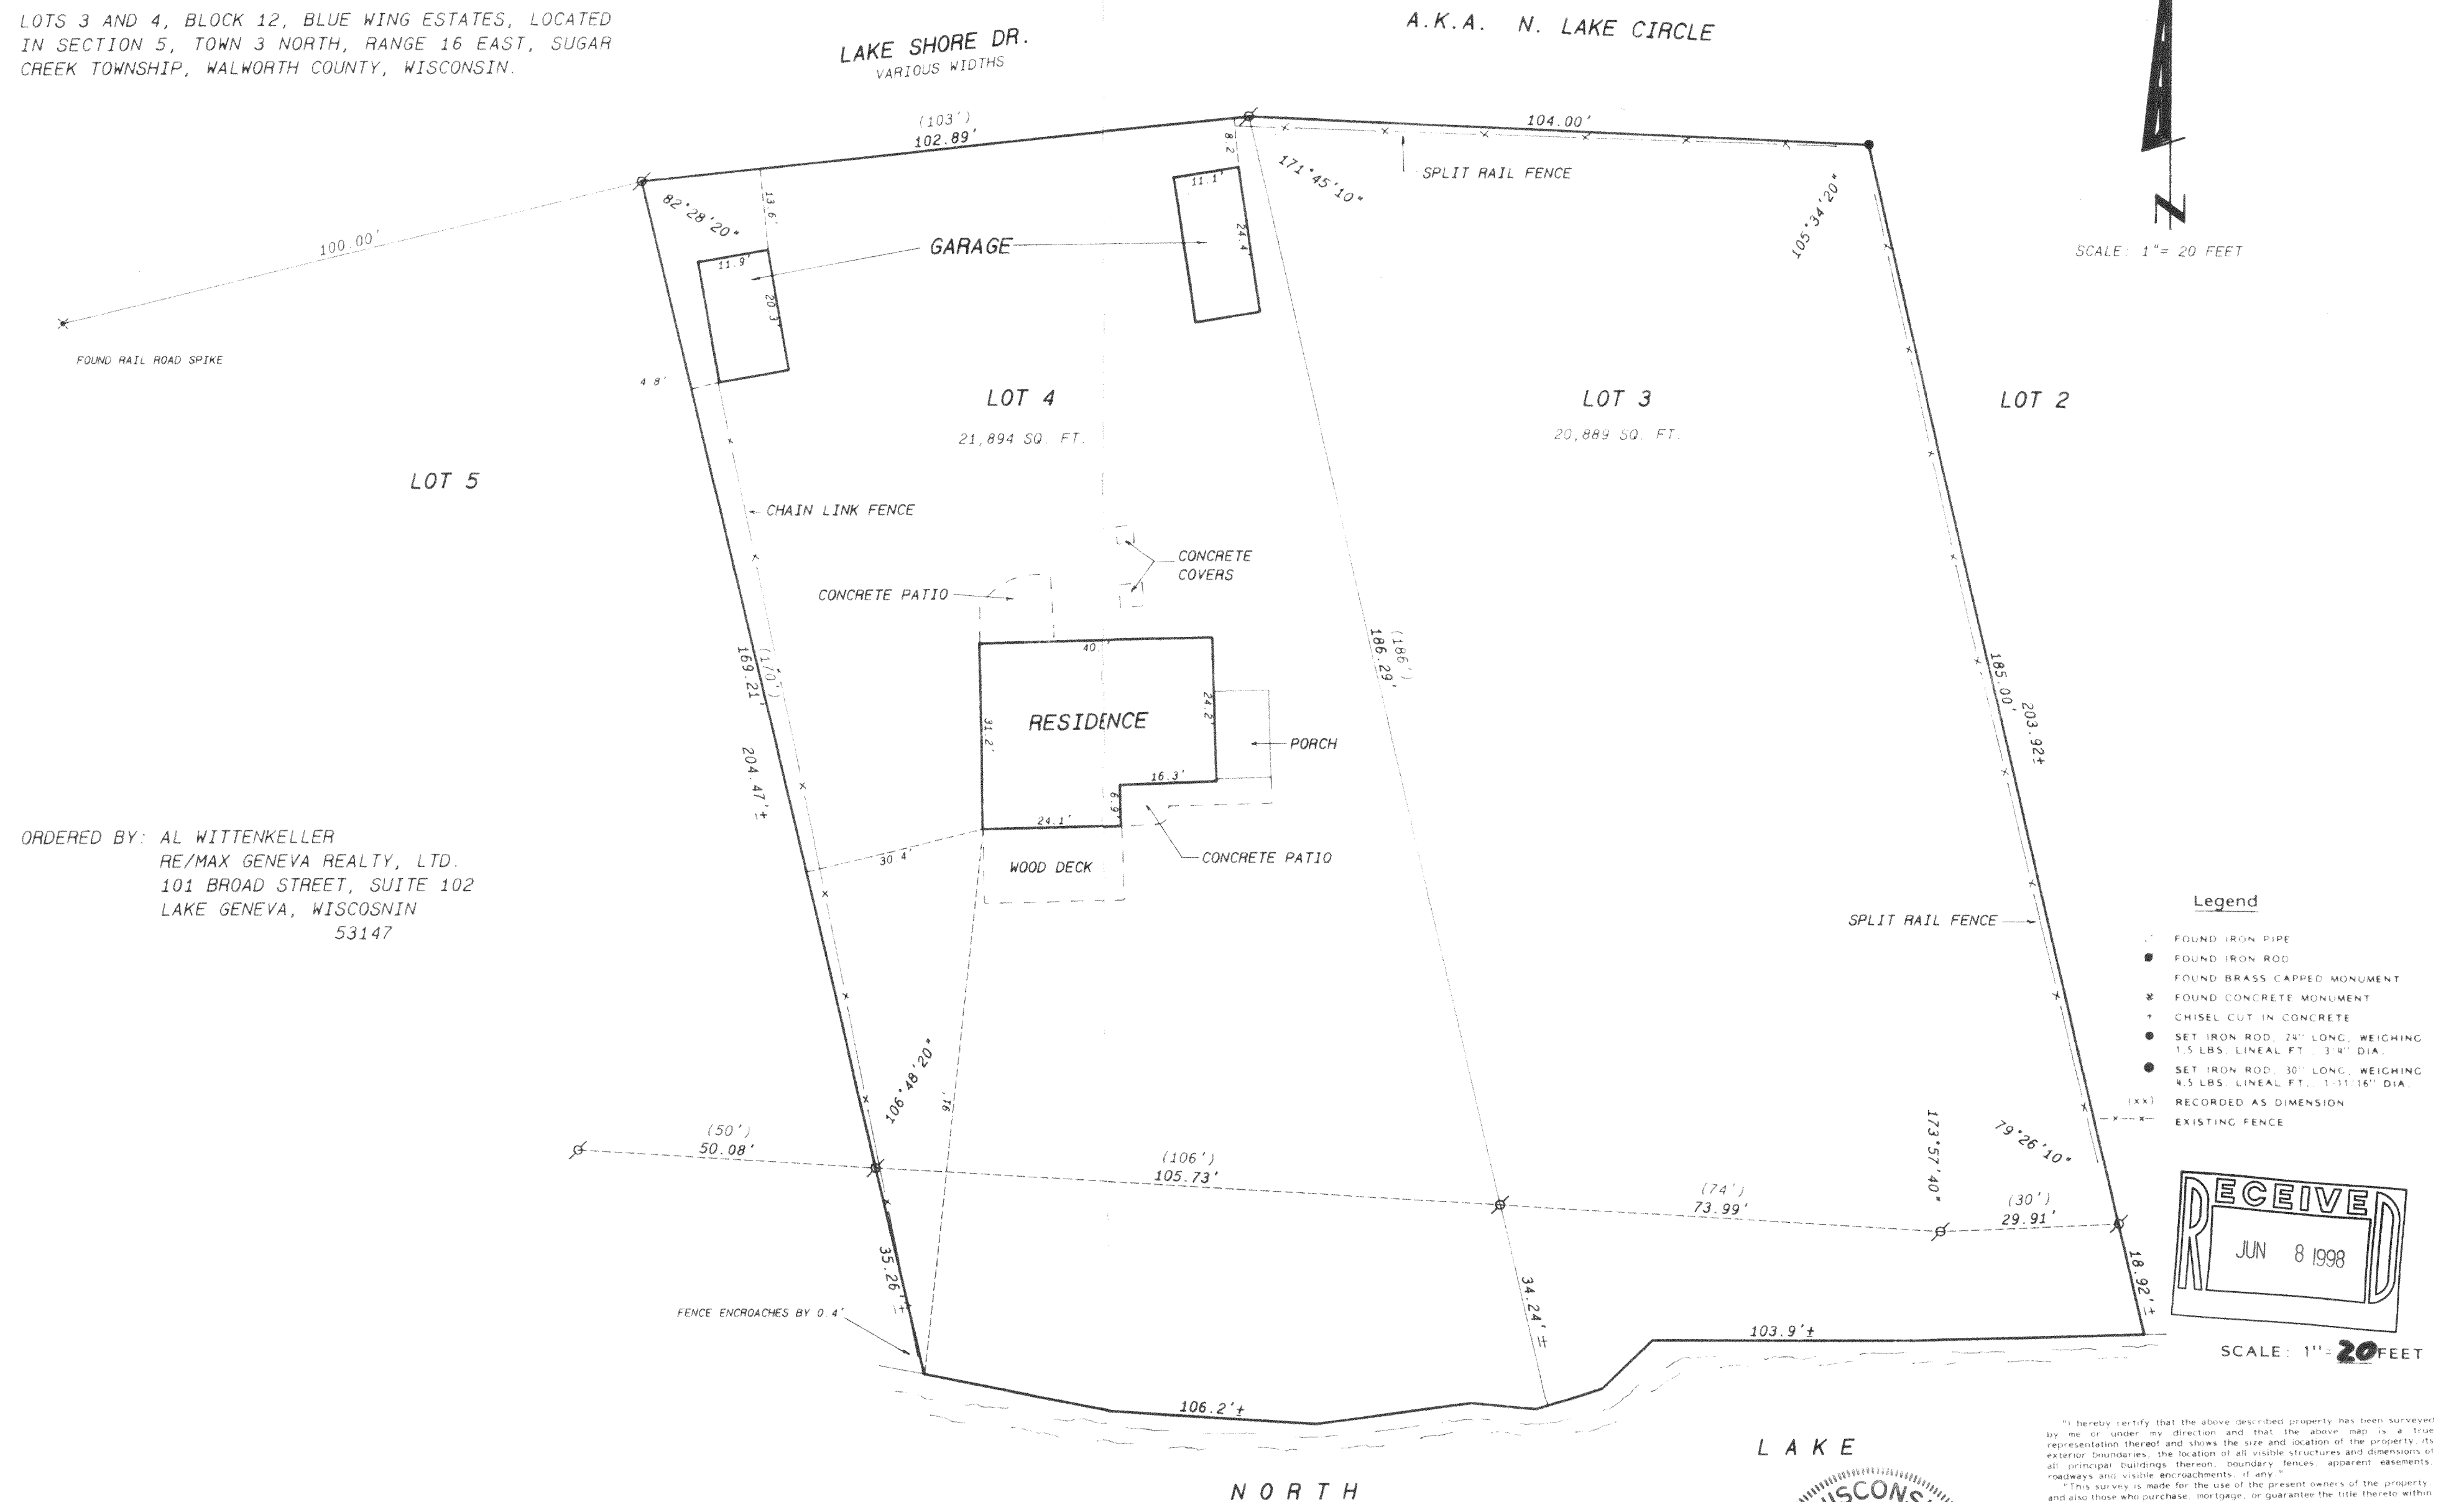

ORDERED BY: AL WITTENKELLER
RE/MAX GENEVA REALTY, LTD.
101 BROAD STREET, SUITE 102
LAKE GENEVA, WISCONSIN
53147

LAKE

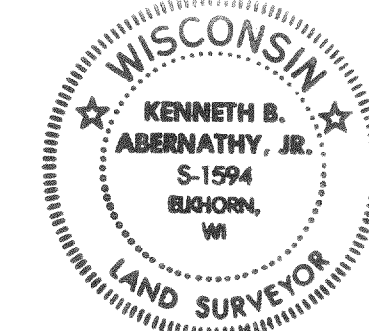

"I hereby certify that the above described property has been surveyed
by me or under my direction and that the above map is a true
representation thereof and shows the size and location of the property, its
exterior boundaries, the location of all visible structures and dimensions of
all principal buildings thereon, boundary fences, apparent easements,
roadways and visible encroachments, if any."

"This survey is made for the use of the present owners of the property
and also those who purchase, mortgage, or guarantee the title thereto within
one year from date hereof."

Kenneth B. Abernathy, Jr.
WISCONSIN REGISTERED LAND SURVEYOR,
S-1594

Date: 4-21-98 Job No. 98408

316-1019

GBW-32
GBW-33