

DESCRIPTION:

LOTS 5, 9, 10, 11, 12, 13, & 14 ALL IN BLOCK 6 OF NORTH LAKE SHOREWOODS, A SUBDIVISION LOCATED IN THE E 1/2 OF SECTION 5, T3N, R16E, WALWORTH COUNTY, WISCONSIN

CERTIFICATE:



I, JOSEPH M. BIAGI, SURVEYOR, DO HEREBY CERTIFY THAT
I HAVE SURVEYED THE LANDS HEREON DESCRIBED

DATE:

APRIL 2, 1974

~~JOSEPH M. BIRCH
ELKHORN, WIS.~~

~~R.L.S. #12~~

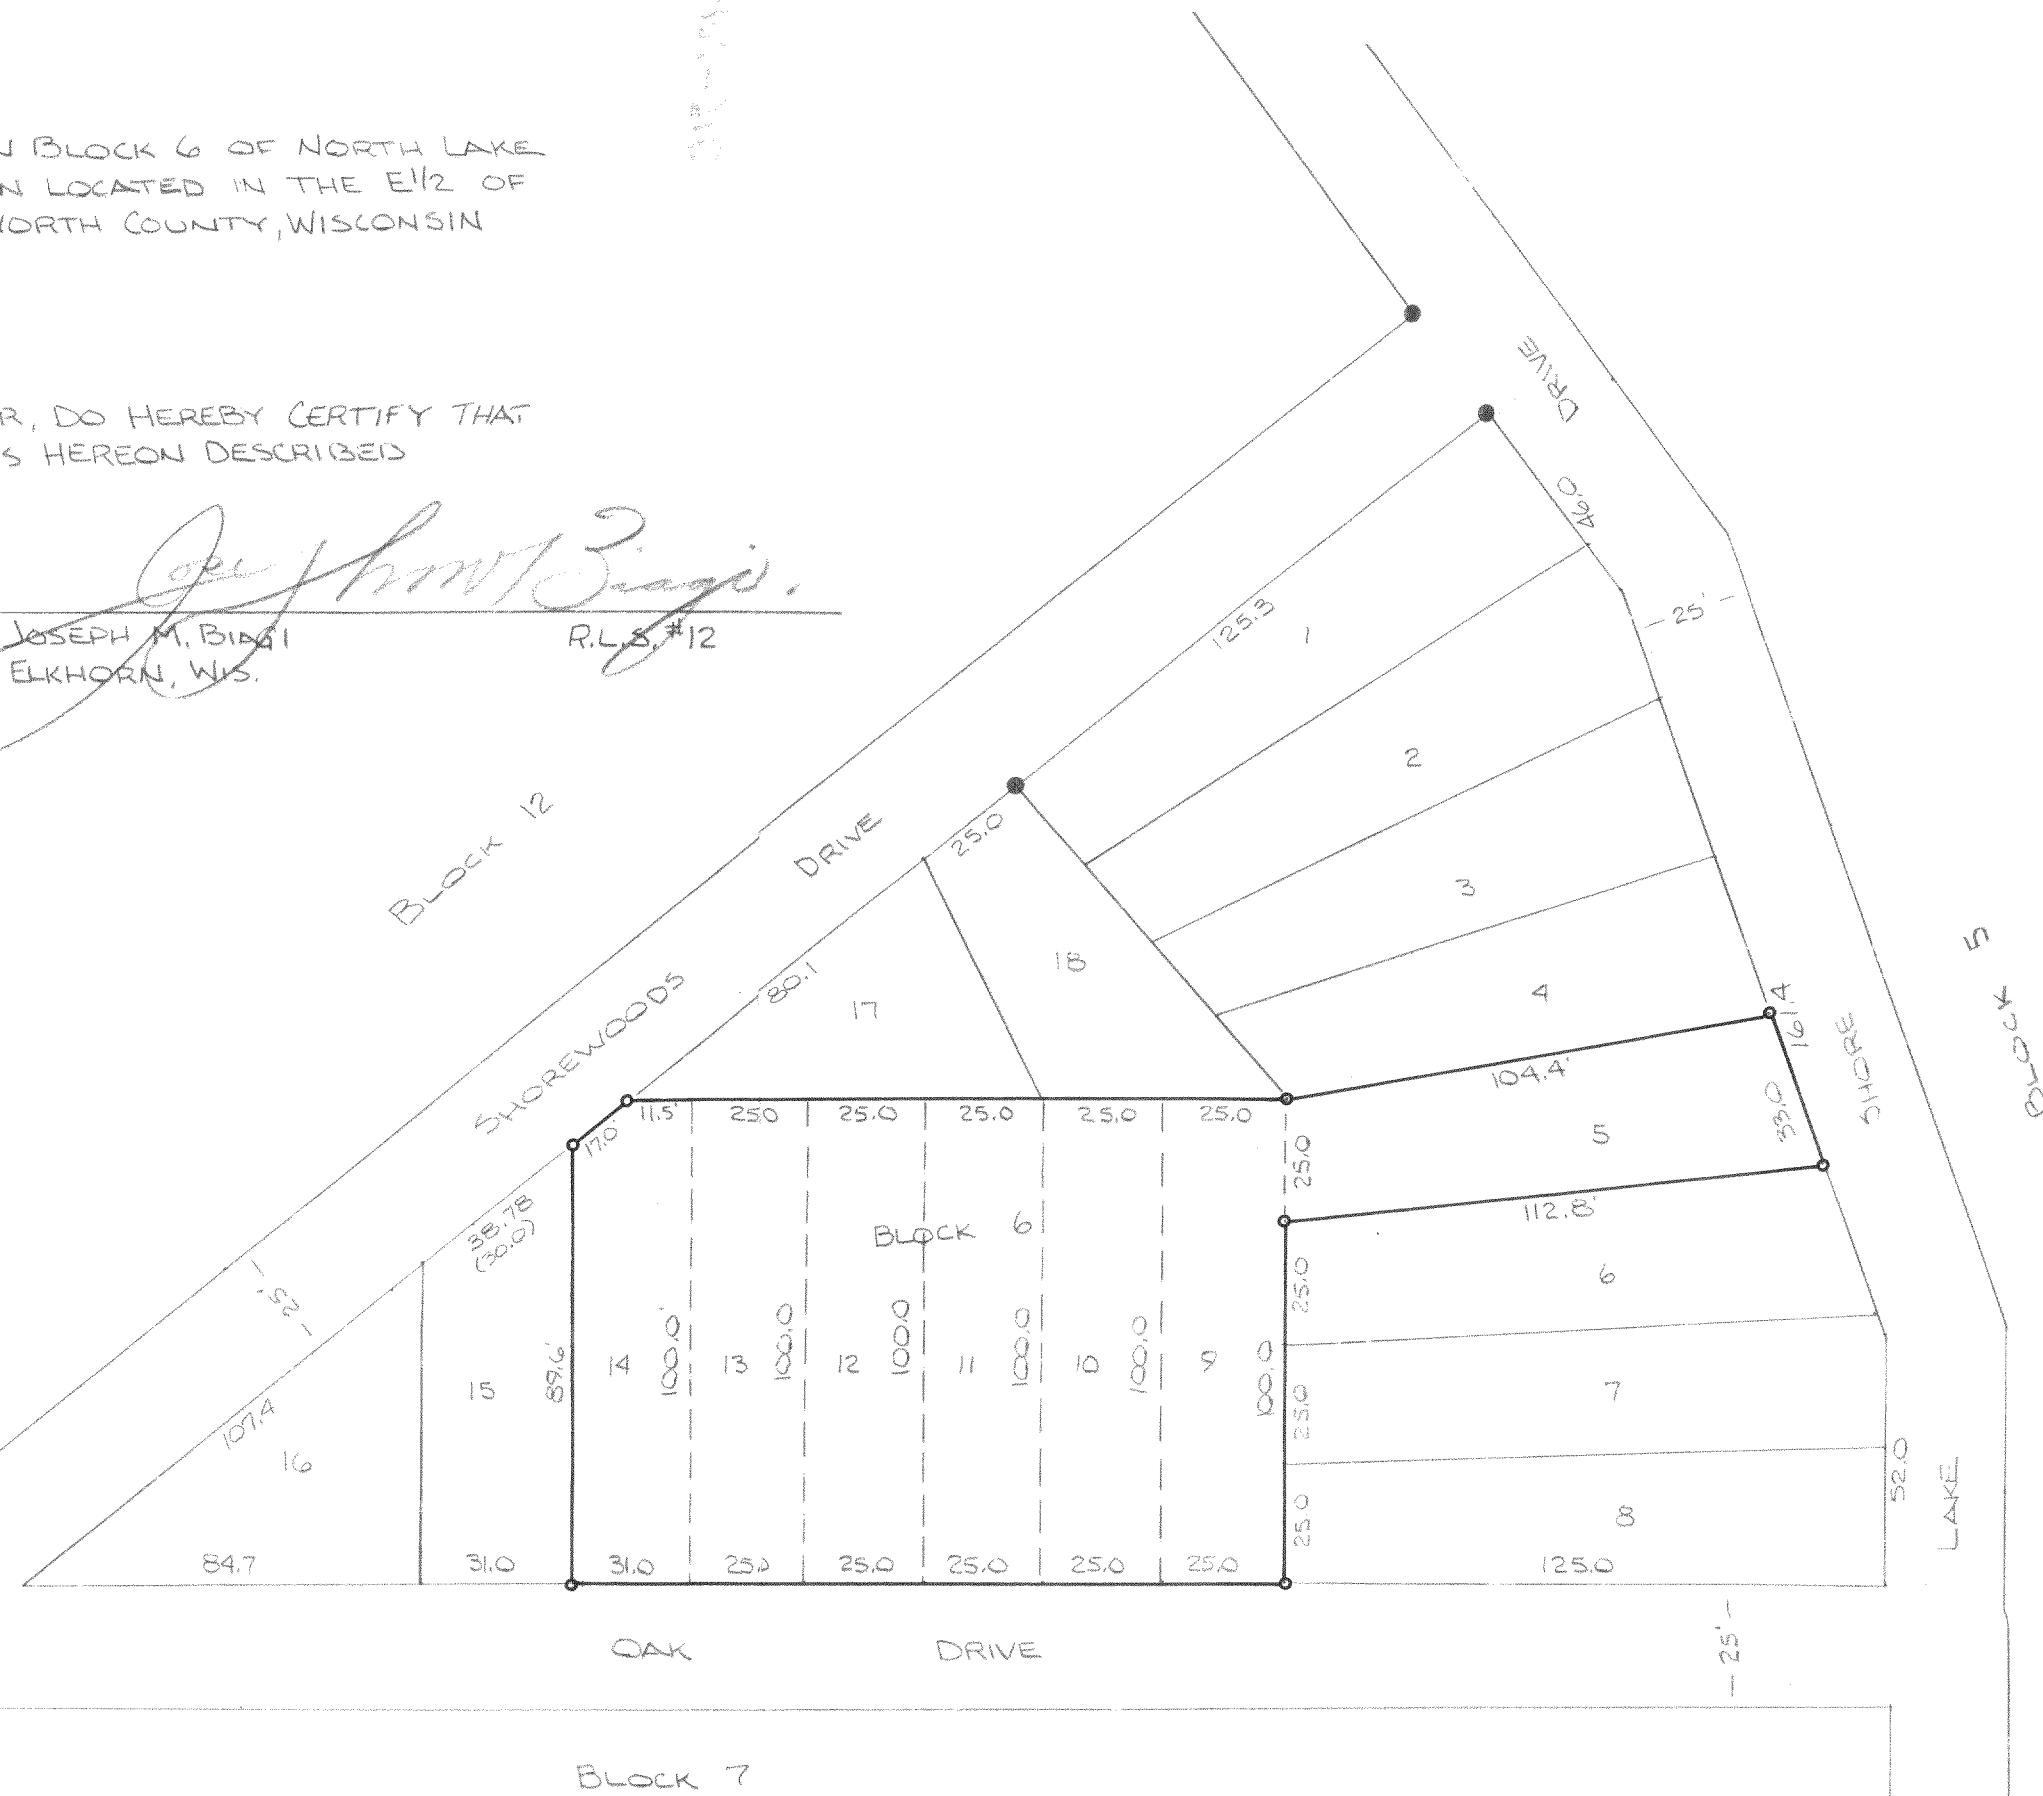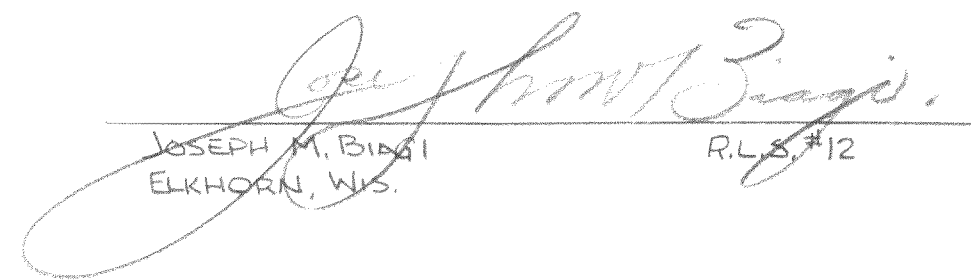

LEGEND

- - INDICATES IRON PIPE FOUND
- - INDICATES IRON PIPE SET
- () - RECORDED DISTANCE



REVISIONS			PART OF BLOCK 6 NORTH LAKE SHORE- WOODS.		
NO.	DATE	BY			
1					
2					
3					
4			DRAWN BY	SCALE	MATERIAL
			GW	1" = 40'-0'	
4			CHK'D	DATE	DRAWING NO.
			MB	4/1/74	29-74
5			TRACED	APP'D	
				MB	