


Wisconsin Registered Land Surveyor S-1594

Rt. 3, Box 273
Elkhorn, Wisconsin 53121
Phone: (414) 723-4260 (office)
(414) 723-4813 (residence)

THE EAST 1/2 OF LOT 3, LOT 4
AND LOT 5, BLOCK 21, 2ND MAP
OF INTERLAKEN SUBDIVISION,
LOCATED IN SECTION 3, TOWN 3
NORTH, RANGE 16 EAST, SUGAR
CREEK TOWNSHIP, WALWORTH
COUNTY, WISCONSIN.

ORDERED BY:
MYRON MATHISON
CENTURY 21 AFFILIATED
50 WEST GENEVA ST.
P.O. BOX 367
WILLIAMS BAY, WI. 53191

OWNER: KEVIN PLOSAJ

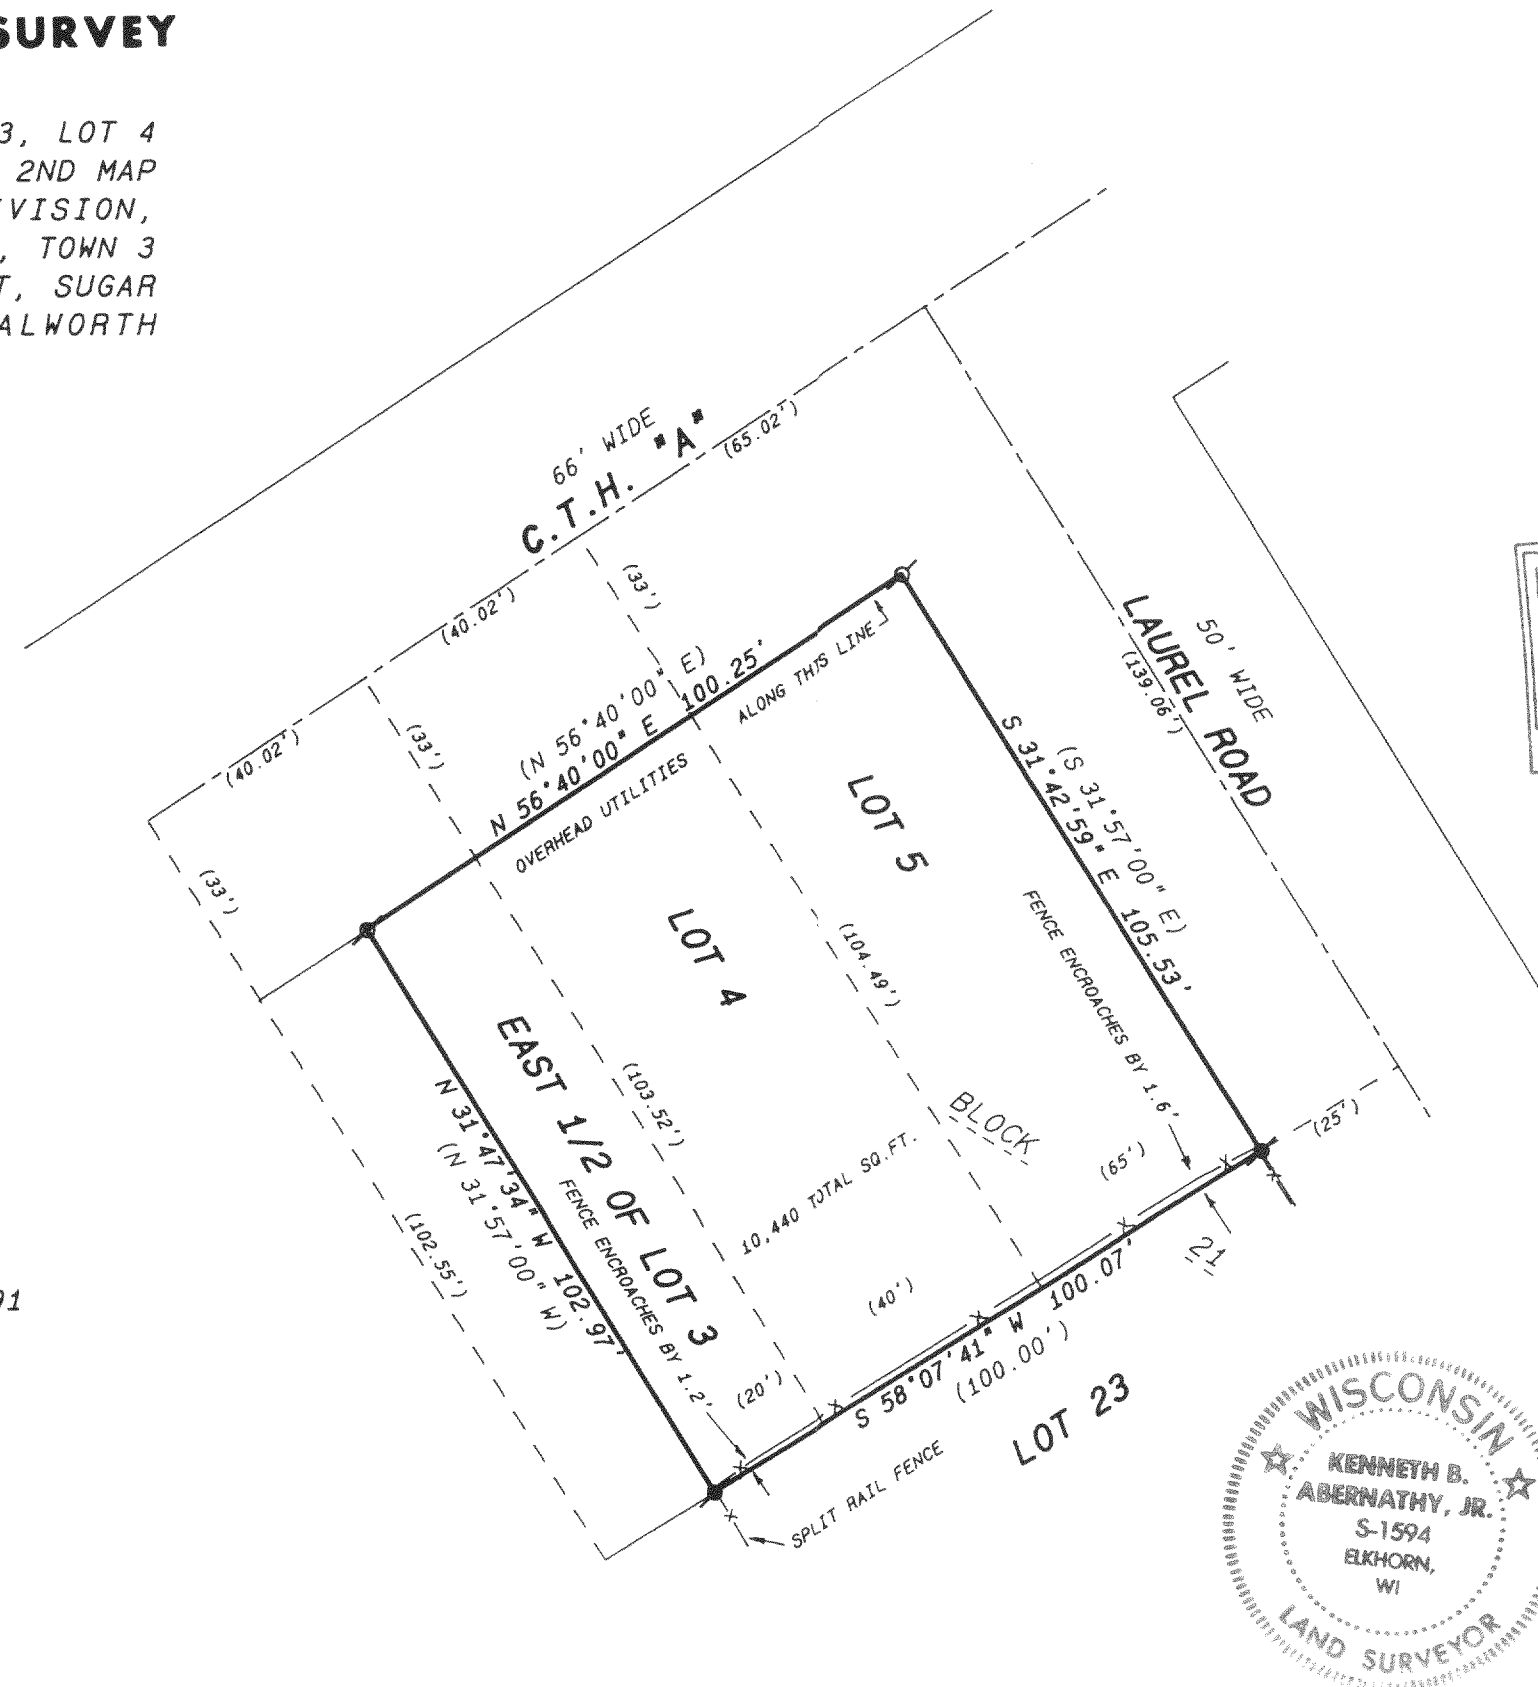

NUMERICAL LINE WAS ASSUMED N 30 40 E



SCALE: 1"= 30 FEET

Legend

-  FOUND IRON PIPE
 FOUND IRON ROD
 FOUND BRASS CAPPED MONUMENT
 FOUND CONCRETE MONUMENT
 CHISEL CUT IN CONCRETE
 SET IRON ROD, 24" LONG, WEIGHING
1.5 LBS./LINEAL FT., 3/4" DIA.
 SET IRON ROD, 30" LONG, WEIGHING
4.5 LBS./LINEAL FT., 1-11/16" DIA.
({xx}) RECORDED AS DIMENSION
—x—x— EXISTING FENCE

"I hereby certify that I have surveyed the above described property and that the above map is a true representation thereof and shows the size and location of the property, its exterior boundaries, the location of all visible structures and dimensions of all principal buildings thereon, boundary fences, apparent easements, roadways and visible encroachments, if any."

"This survey is made for the use of the present owners of the property, and also those who purchase, mortgage, or guarantee the title thereto within one year from date hereof."

Kenneth B. Auerbach

KENNETH B. ABERNATHY, JR.
WISCONSIN REGISTERED LAND SURVEYOR,
S-1594

Date: 6-1-98 Job No. 98.522

316-1025
GI-257C