

ABERNATHY and ASSOCIATES

Kenneth B. Abernathy Jr.

Wisconsin Registered Land Surveyor S-1594


Rt. 3, Box 273
Elkhorn, Wisconsin 53121
Phone: (414) 723-4260 (office)
(414) 723-4813 (residence)

PLAT OF SURVEY

LOTS 8 AND 9 AND THE SOUTHERLY 20 FEET OF LOT 7,
ALL IN BLOCK 16, INTERLAKEN SUBDIVISION
1ST MAP, SUGAR CREEK TOWNSHIP, WALWORTH
COUNTY, WISCONSIN.

OWNER: MARQUERITE STANLEY
N6574 ASPEN ROAD
ELKHORN, WI. 53121

NOTE: WELL IS LOCATED INSIDE RESIDENCE

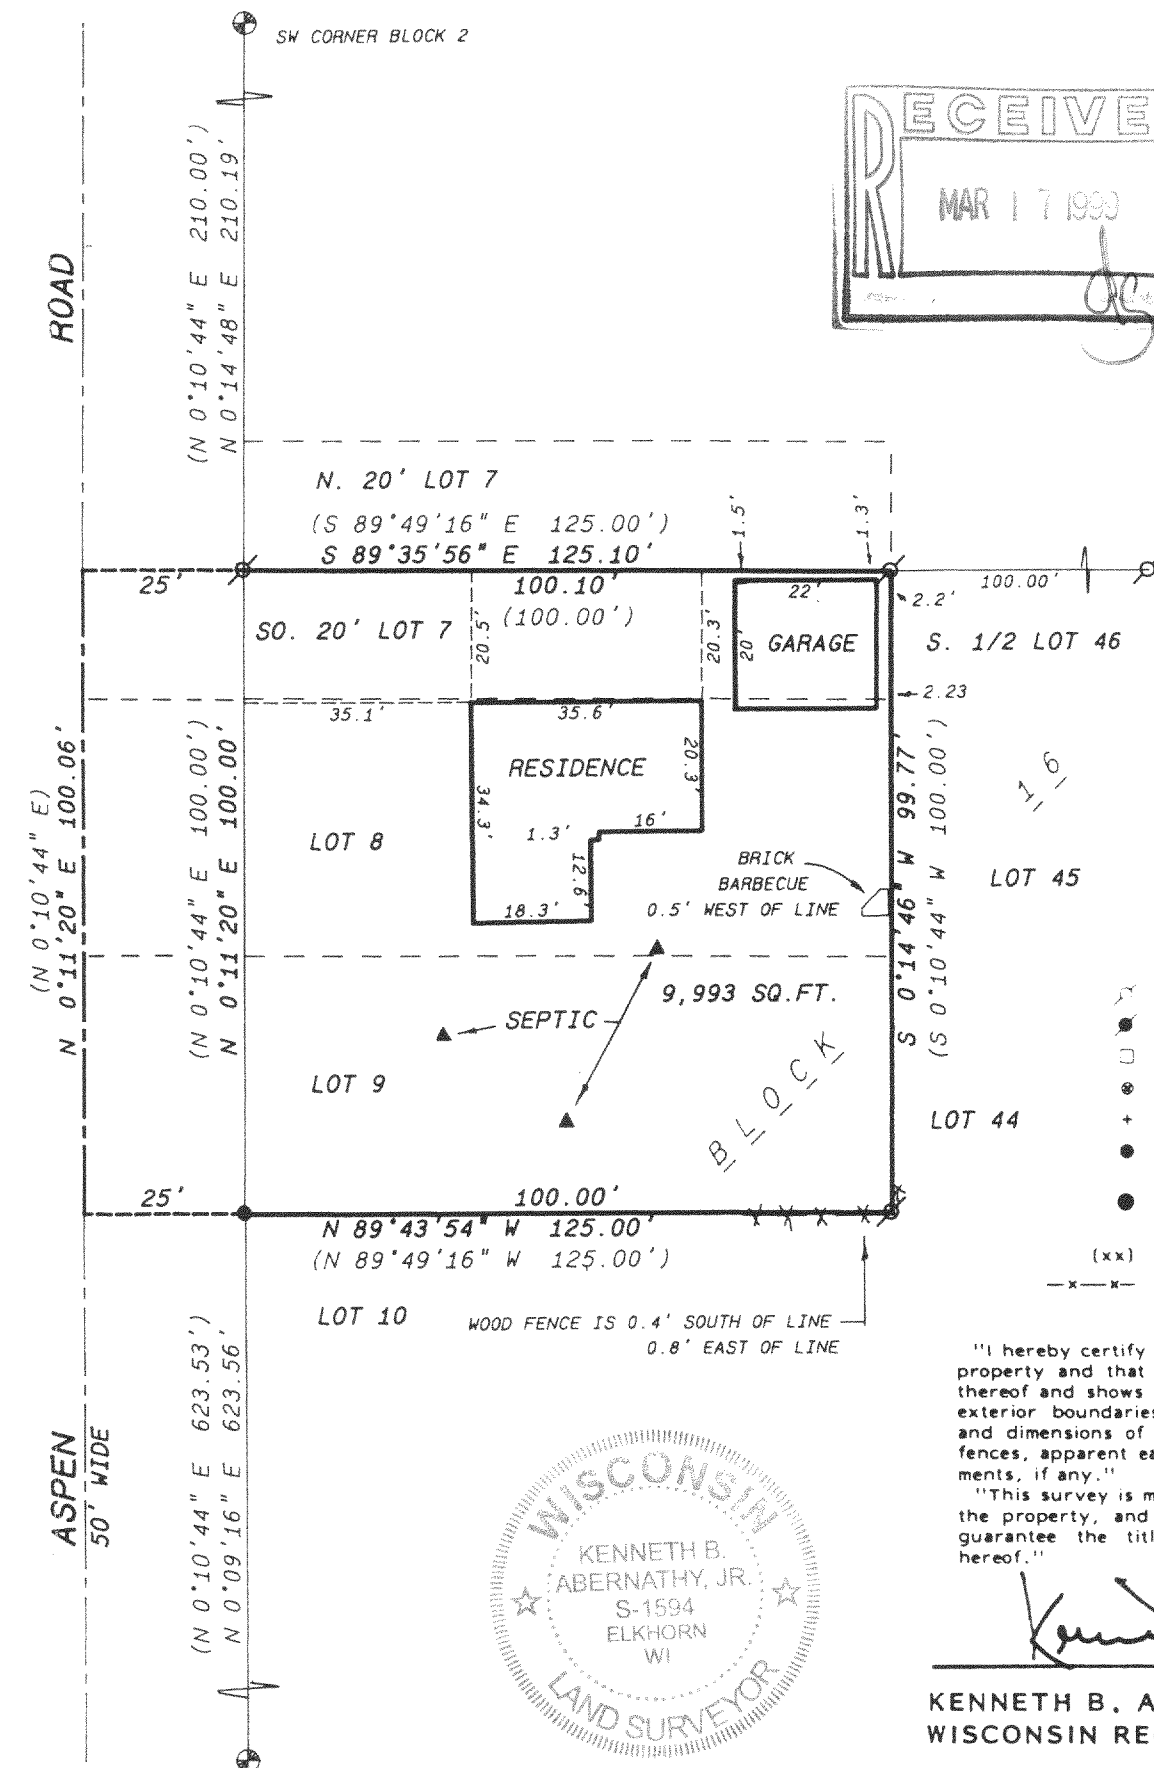

316-1051
GI-197