

ABERNATHY and ASSOCIATES

Kenneth B. Abernathy Jr.

Wisconsin Registered Land Surveyor S-1594


Rt. 3, Box 273
Elkhorn, Wisconsin 53121
Phone: (414) 723-4260 (office)
(414) 723-7209 (FAX)

PLAT OF SURVEY


LOT 31 OF STRAWBERRY BANKE PLANTATION NO. 1, BEING A SUBDIVISION LOCATED IN THE SOUTHWEST 1/4 OF SECTION 36, TOWN 4 NORTH, RANGE 16 EAST, AND IN THE NORTHWEST 1/4 OF SECTION 1 TOWN 3 NORTH, RANGE 16 EAST, WALWORTH COUNTY, WISCONSIN.

OWNERS: STANLEY F. WASILEWSKI AND MARY A. WASILEWSKI
W5111 STRAWBERRY HILL ROAD
ELKHORN, WI. 53121

STRAWBERRY BANKE PLANTATION
ADDITION NO. 1

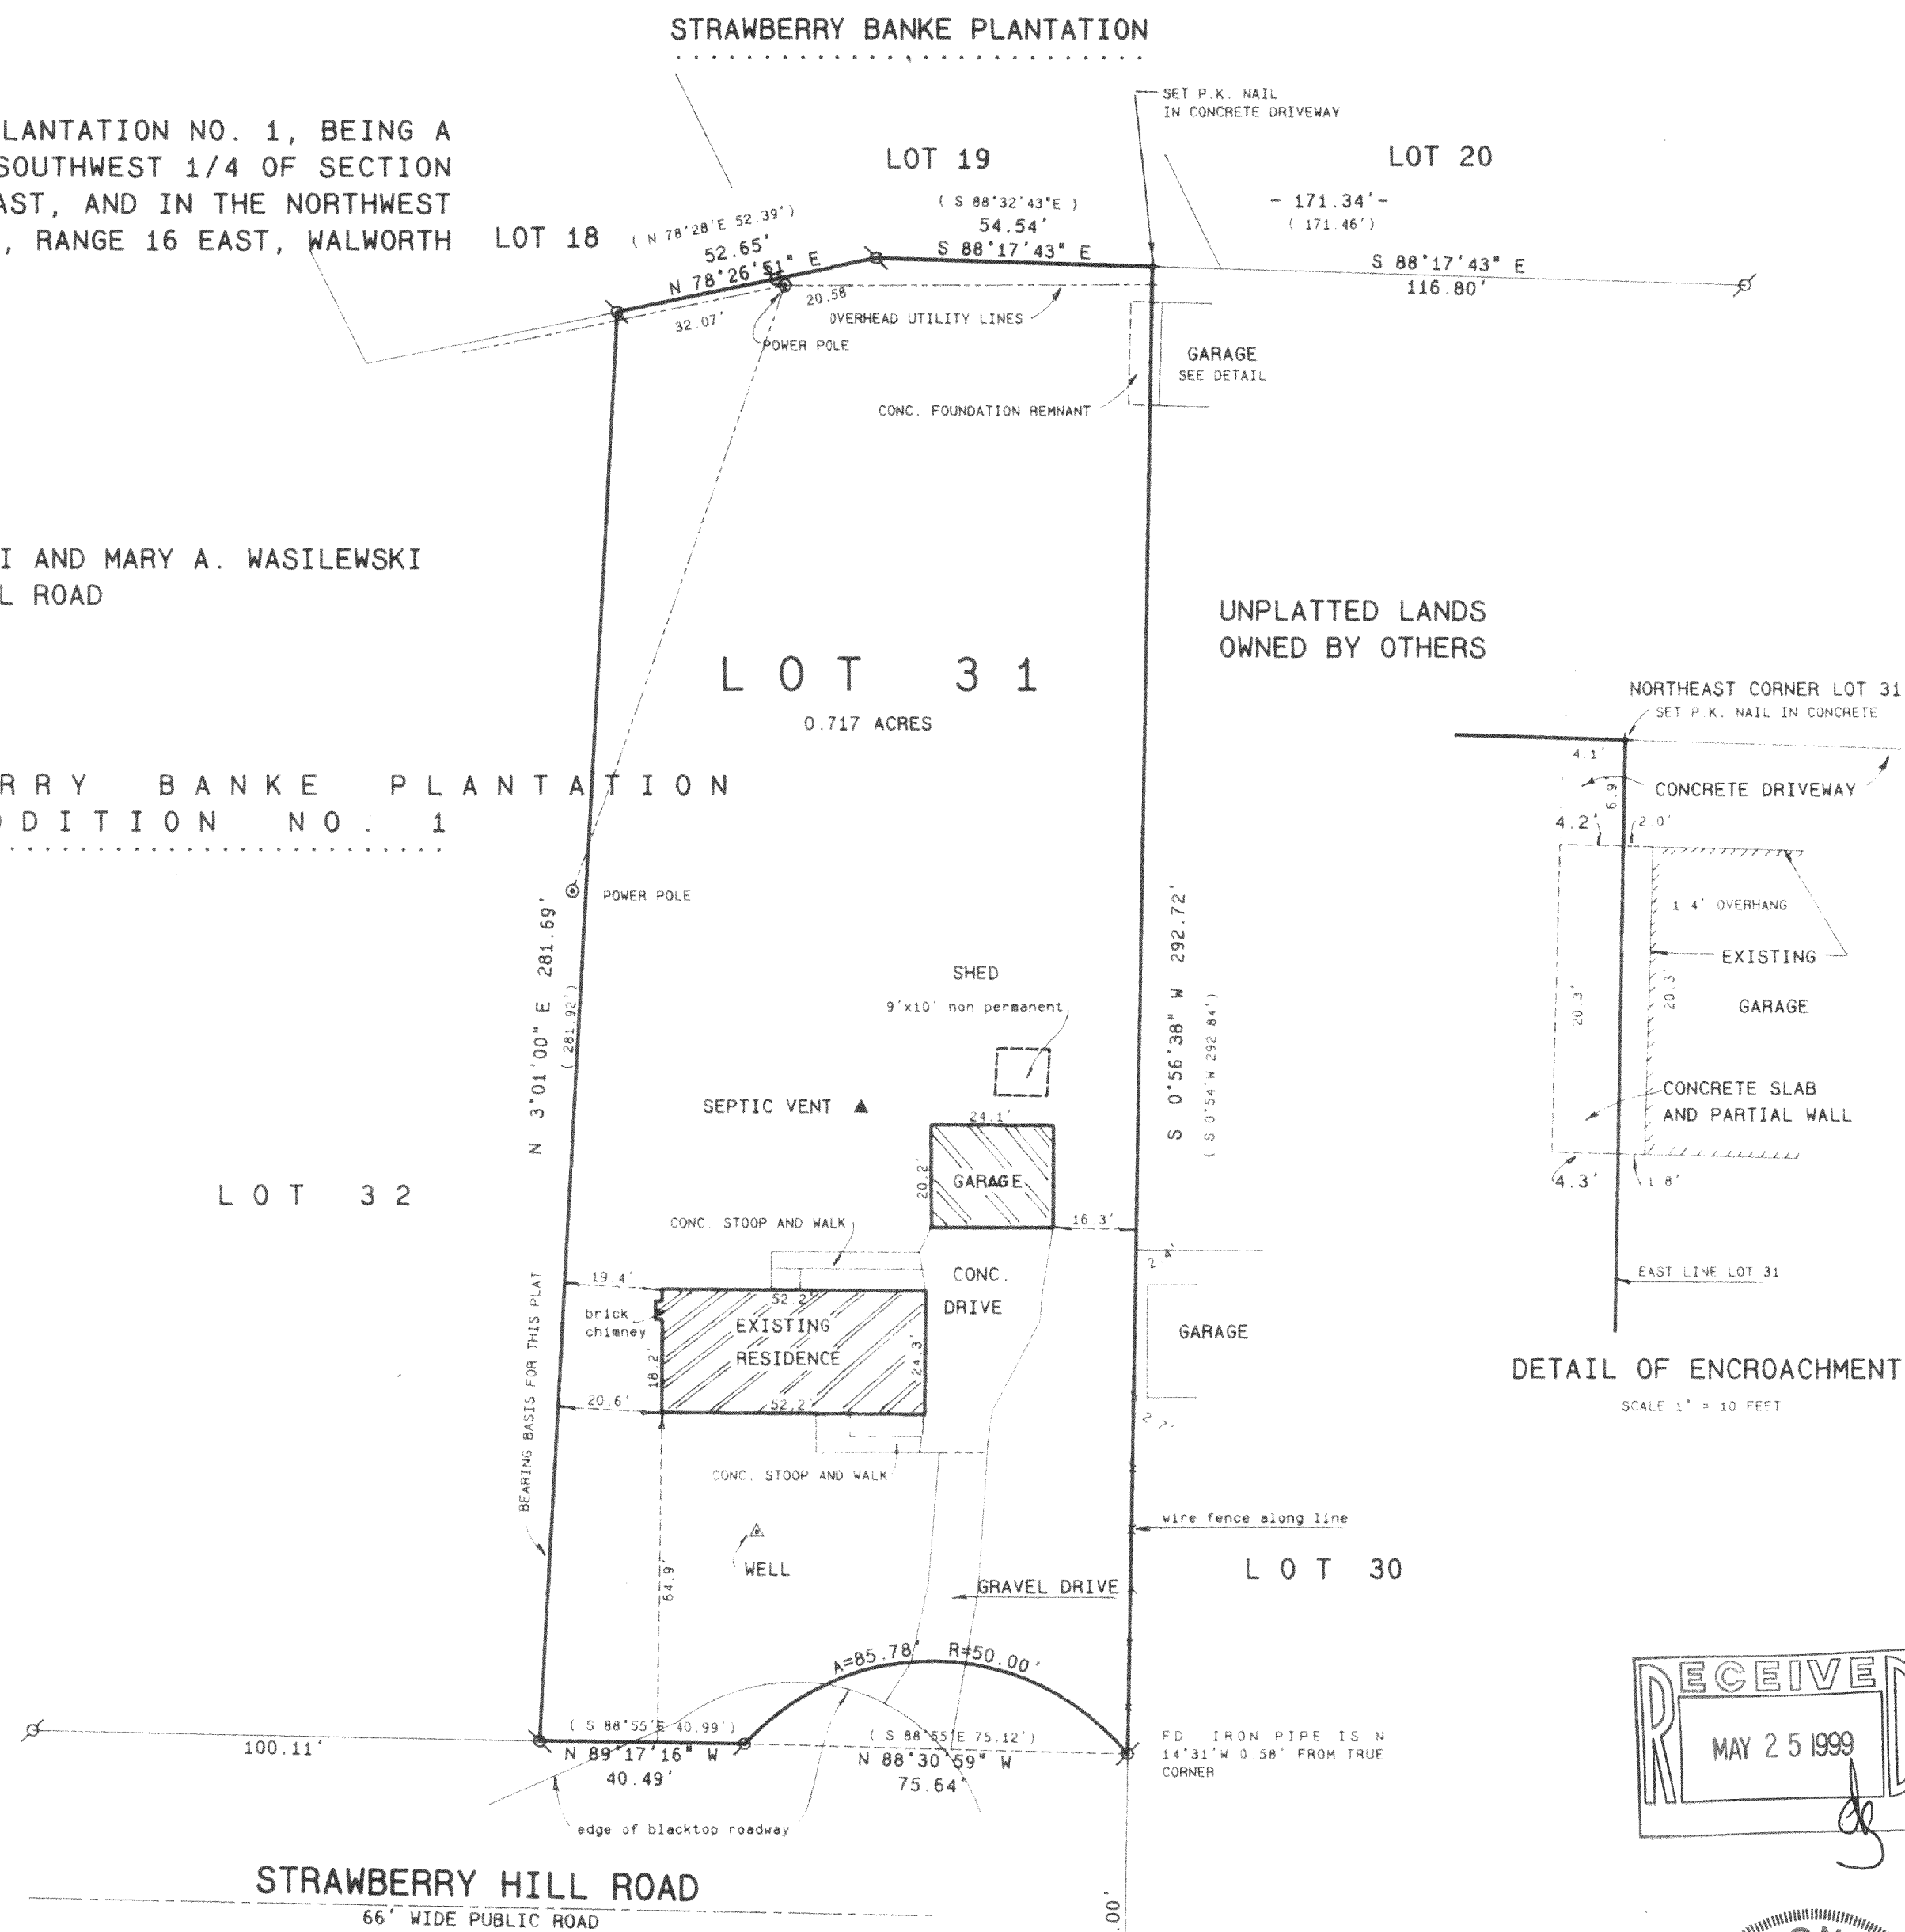

SCALE 1" = 30 FEET

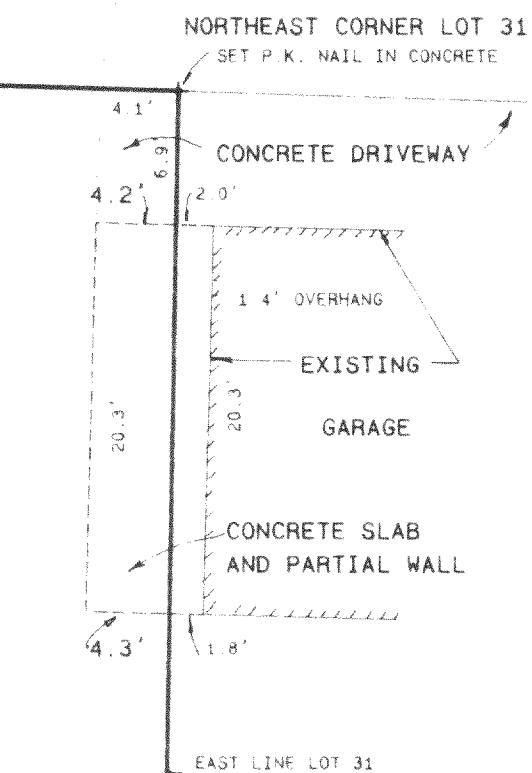


DETAIL OF ENCROACHMENT

SCALE 1" = 10 FEET

Legend

- FOUND IRON PIPE
- FOUND IRON ROD
- FOUND BRASS CAPPED MONUMENT
- FOUND CONCRETE MONUMENT
- CHISEL CUT IN CONCRETE
- SET IRON ROD, 24" LONG, WEIGHING 1.5 LBS., LINEAL FT. 3.4" DIA.
- SET IRON ROD, 30" LONG, WEIGHING 4.5 LBS., LINEAL FT. 1.11 1/16" DIA.
- RECORDED AS DIMENSION
- EXISTING FENCE

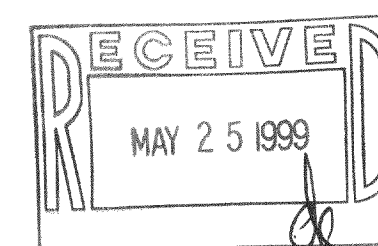

SCALE 1" = 30 FEET



I hereby certify that the above described property has been surveyed by me or under my direction and that the above map is a true representation thereof and shows the size and location of the property, its exterior boundaries, the location of all visible structures and dimensions of all principal buildings thereon, boundary lines, apparent easements, roadways, and visible encroachments, if any.

This survey is made for the use of the present owner(s) of the property and also those who purchase, mortgage, or guarantee the title thereto within one year from date hereof.

Kenneth B. Abernathy, Jr.
WISCONSIN REGISTERED LAND SURVEYOR,
S-1594

Date: MAY 10, 1999 Job No. 97503

316-1063

CSA-31