


LOTS 15, 16, 17 AND 18 IN BLOCK 2
 OF THE recorded plat of North
 Lake Shore Woods Subdivision
 in Sugar Creek Township
 Waukesha County, Wisconsin

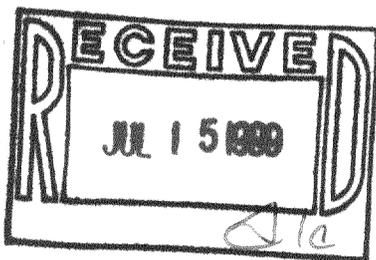

Survey for: LESLIE B. FARNSWORTH
 Name: W 1767
 Address of survey: W 1767
 Part of _____ Quarter of _____
 Section 5 Town 3 N.R. 12 E. SCALE 1"=20'
 Ref: _____ * = PIPE
 Date of survey: 3/15/77 GNS-21

SURVEY CERTIFICATE
 I CERTIFY THAT I HAVE SURVEYED THE ABOVE DESCRIBED (PROPERTY)
 AND THE ABOVE MAP IS A TRUE REPRESENTATION THEREOF AND SHOWS
 THE SIZE AND LOCATION OF THE PROPERTY, ITS EXTERIOR BOUNDARIES,
 THE LOCATION AND DIMENSIONS OF ALL VISIBLE STRUCTURES, THE FENCES,
 APPARENT EASEMENTS AND ROADWAYS AND VISIBLE ENCROACHMENTS,
 IF ANY.
 THIS SURVEY IS MADE FOR THE EXCLUSIVE USE OF THE PRESENT OWNERS
 OF THE PROPERTY, AND ALSO THOSE WHO PURCHASE MORTGAGE OR
 GUARANTEE THE TITLE THERETO WITHIN ONE (1) YEAR FROM DATE HEREOF
 AND AS TO THEM I WARRANT THE ACCURACY OF SAID SURVEY AND MAP

Harold M. Schneider 316-1099