


LOT 8 OF "SYLVAN TRACE SUBDIVISION" LOCATED IN SECTION 2, TOWN 3 NORTH, RANGE 16 EAST, IN THE TOWN OF SUGAR CREEK, COUNTY OF WALWORTH, STATE OF WISCONSIN.

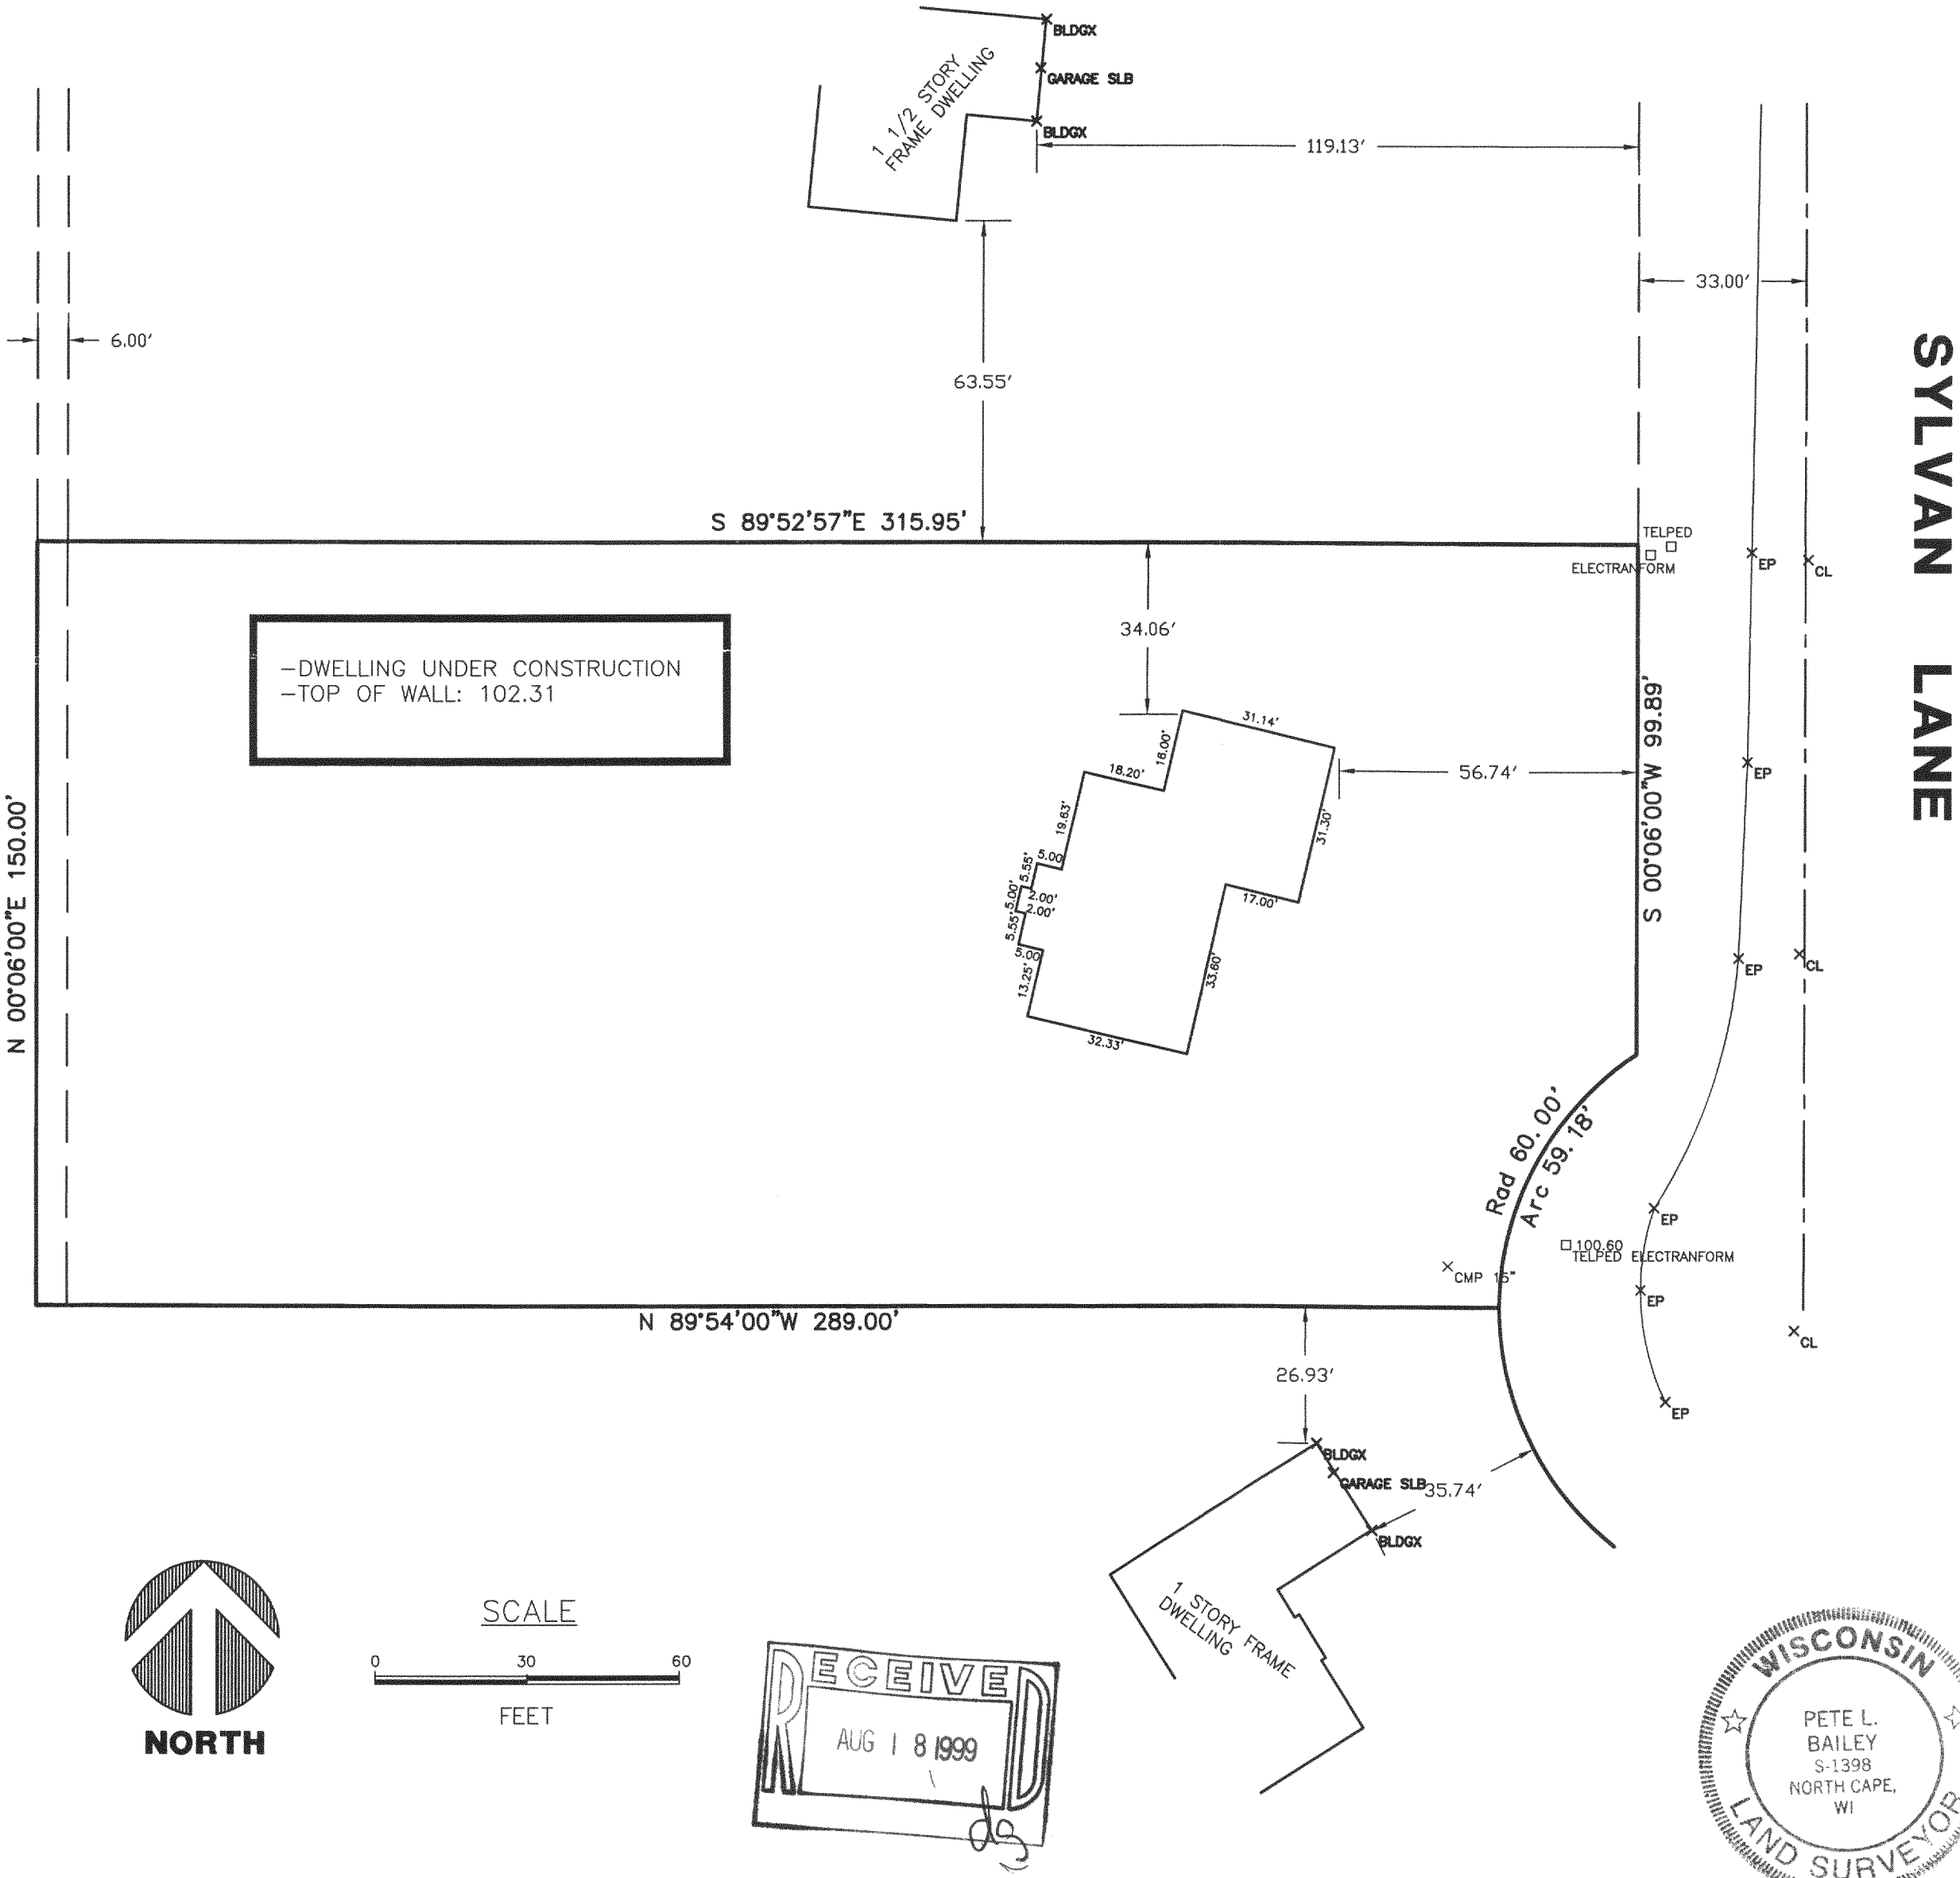

STATE OF WISCONSIN
COUNTY OF RACINE

I HEREBY CERTIFY THAT I HAVE SURVEYED THE ABOVE DESCRIBED PROPERTY AND THE ABOVE MAP IS A TRUE REPRESENTATION THEREOF AND SHOWS THE SIZE AND LOCATION OF THE PROPERTY, ITS EXTERIOR BOUNDARIES, THE LOCATION OF ALL VISIBLE STRUCTURE AND DIMENSIONS OF ALL PRINCIPLE BUILDINGS THEREON, BOUNDARY FENCES, APPARENT EASEMENTS, ROADWAYS AND VISIBLE ENCROACHMENTS, IF ANY.

THIS SURVEY IS MADE FOR THE PRESENT OWNERS OF THE PROPERTY, AND ALSO THOSE WHO PURCHASE, MORTGAGE, OR GUARANTEE THE TITLE THEREOF WITHIN ONE (1) YEAR FROM THE DATE THEREOF.
DATED AT: NORTH CAPE, THIS 5TH DAY OF APRIL, 1999.

AMERICAN SURVEYING COMPANY, INC.
PETE L. BAILEY, RLS NO. 1398
RECERIFIED this 21ST day of JULY, 1999.

**AMERICAN
SURVEYING
COMPANY, INC.**
12207 C.T.H. "K" FRANKSVILLE, WISCONSIN 53126
TEL. (414) 835-4774 FAX: (414) 835-2379

DRAWN BY:	PLB	REVISIONS:	DATE
CHECKED BY:	PLB		
PLOT SCALE:	1 = 30		
DATE:	05/05/99		
JOB NO.:	99.032		
DWG. FILE:	JN99098		

TOWN OF SUGAR CREEK

PROJECT:
PLAT OF SURVEY / STAKE OUT SURVEY

**OWNERS, ROBIN & KAREN HANCOCK
PREPARED FOR: BADGER HOME BUILDERS, INC.**

Sheet
1
of
1

65T-8

316-1113