


PLAT OF SURVEY

LOT 53, LAUDERDALE LAKE ESTATES, located in the Northwest $\frac{1}{4}$ an Southwest $\frac{1}{4}$ of the Southeast $\frac{1}{4}$ of Section 1, and the Northwest $\frac{1}{4}$ of the Northeast $\frac{1}{4}$ of Section 12, Town 3 North, Range 16 East, Town of Sugar Creek, Walworth County, Wisconsin.

Surveyed for: Ray Leanna Construction

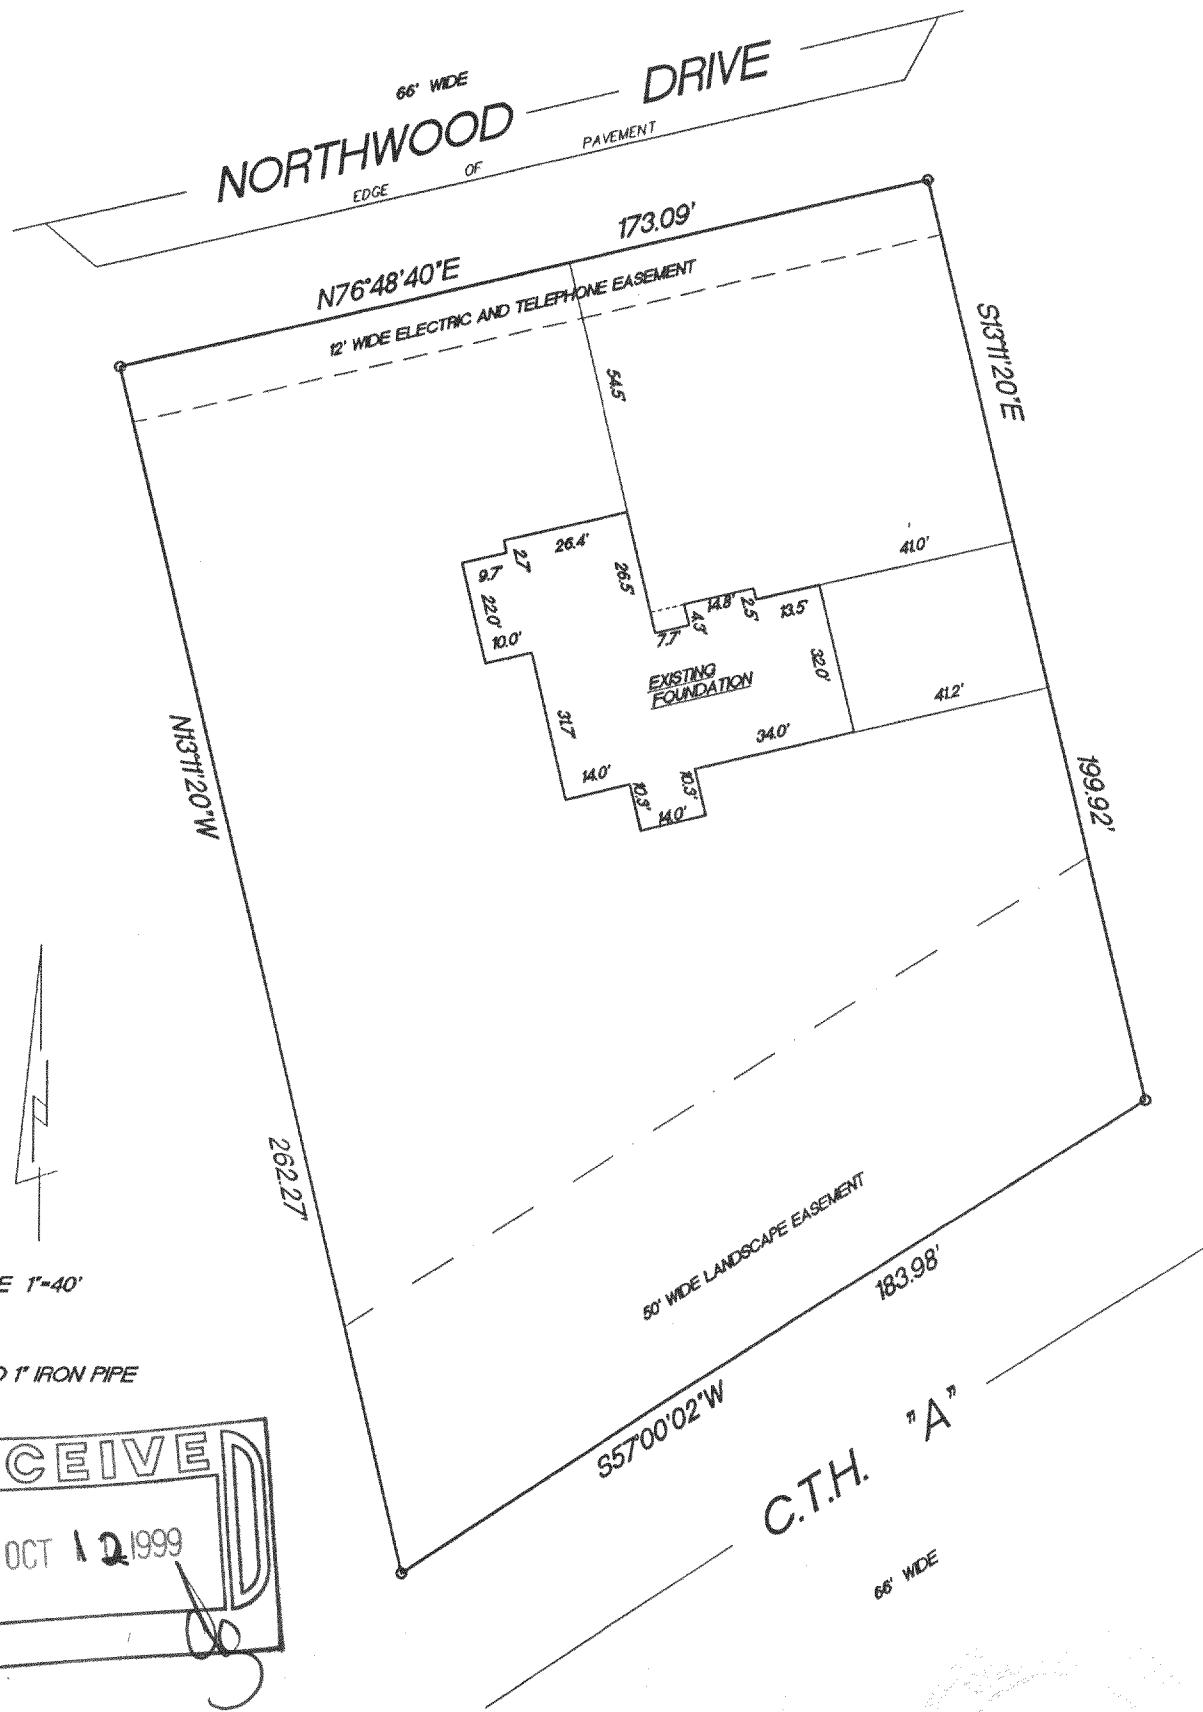

"I hereby certify that I have surveyed the above described property and that the above map is a true representation thereof and shows the size and location of the property, its exterior boundaries, the location of all visible structures and dimension of all principal buildings thereon, boundary fences, apparent easements, roadways and encroachments if any."

"This survey is made for the use of the present owners of the property, and also those who purchase, mortgage or guarantee the title thereto within one year from date hereof."



W356 S9050 Godfrey Lane
P.O. Box 357
Eagle WI. 53119

(414) 594-3484
fax (414) 594-5904

THIS IS NOT AN ORIGINAL SURVEY UNLESS THE SEAL IS RED.

REV. 10/11/99
8/16/99

DATE

TEP/DW

FIELD WORK BY

TEP

DRAWN BY

99203

JOB NUMBER

611-30

316-1128