

ABERNATHY and ASSOCIATES

Kenneth B. Abernathy Jr.

Wisconsin Registered Land Surveyor S-1594



Rt. 3, Box 273
Elkhorn, Wisconsin 53121
Phone: (414) 723 4260 (office)
(414) 723 7209 (FAX)

PLAT OF SURVEY

LOT 26 OF SYLVAN
TRACE SUBDIVISION,
located in the SW
1/4 of the NE 1/4,
the SW 1/4 and the
SE 1/4 of the NW
1/4, and the NE 1/4
and the SE 1/4 and
the NW 1/4 of the SW
1/4 of Section 2,
Town 3 North, Range
16 East, Town of
Sugar Creek,
Walworth County,
Wisconsin.


ORDERED BY: CONNIE POGGENSEE
THE RAULAND AGENCY, INC.
POST OFFICE BOX 159
WALWORTH, WISCONSIN
53184-0159

OWNERS: GARY & MICHELLE KAMENICK

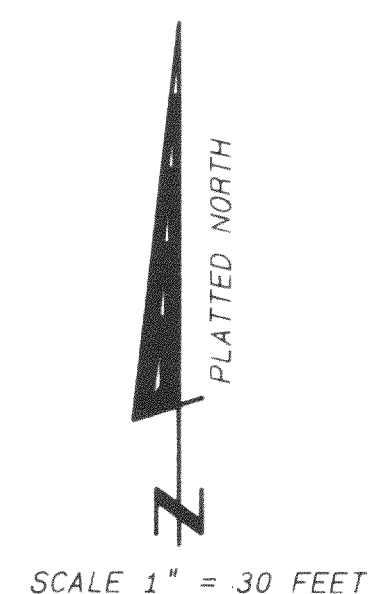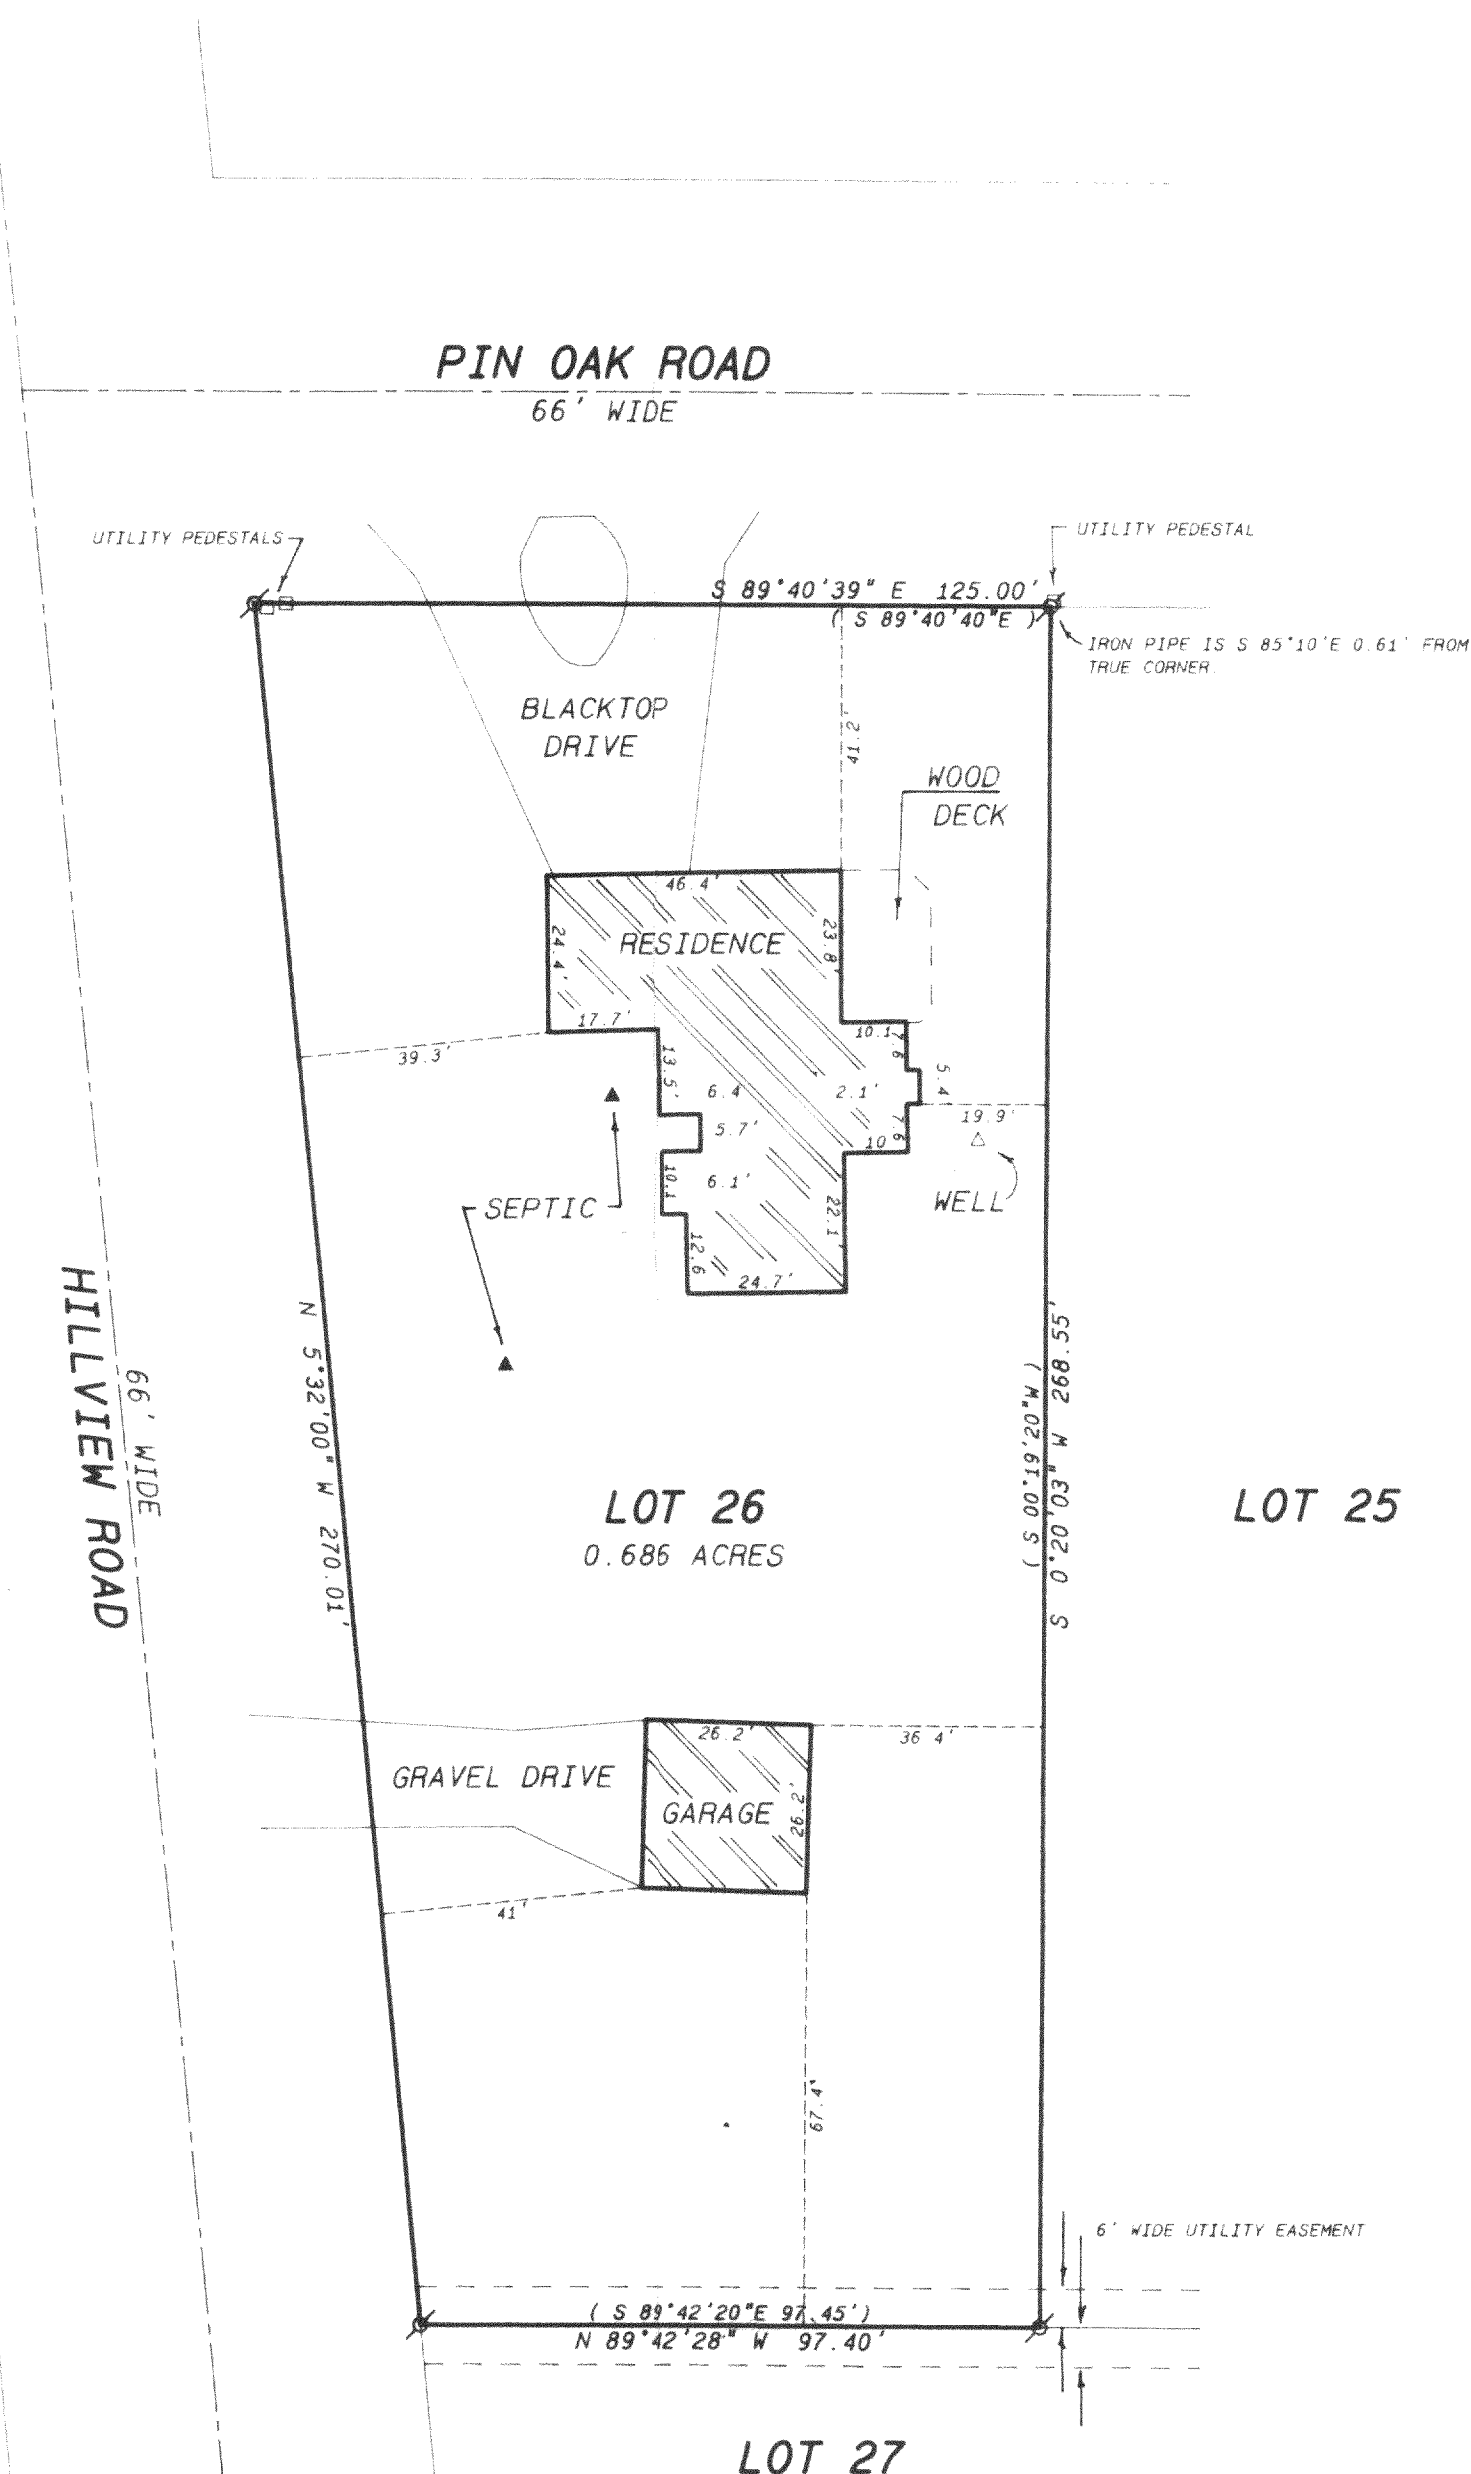


Legend

- FOUND IRON PIPE
- FOUND IRON ROD
- FOUND BRASS CAPPED MONUMENT
- FOUND CONCRETE MONUMENT
- + CHISEL CUT IN CONCRETE
- SET IRON ROD, 24" LONG, WEIGHING 1.5 LBS. LINEAL FT., 3/4" DIA.
- SET IRON ROD, 30" LONG, WEIGHING 4.5 LBS. LINEAL FT., 1-11/16" DIA.
- (xx) RECORDED AS DIMENSION
- x-x- EXISTING FENCE

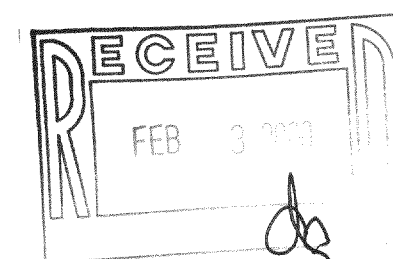

SCALE: 1" = 30 FEET

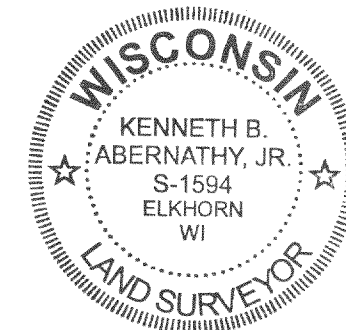

"I hereby certify that the above described property has been surveyed by me or under my direction and that the above map is a true representation thereof and shows the size and location of the property, its exterior boundaries, the location of all visible structures and dimensions of all principal buildings thereon, boundary fences, apparent easements, roadways and visible encroachments, if any."

"This survey is made for the use of the present owners of the property, and also those who purchase, mortgage or guarantee the title thereto within one year from date hereof."

Kenneth B. Abernathy, Jr.
KENNETH B. ABERNATHY, JR.
WISCONSIN REGISTERED LAND SURVEYOR,
S-1594
Date: 8-16-99 Job No. 93-405A

GST-26

316-1143