



Plat of Survey

of


Lots 12, 13, 14 and 15 of Block 44 of the Fourth Map of Interlaken,

a subdivision located in the Northeast 1/4 and the Northwest 1/4 of Section 11, Town 3 North, Range 16 East, Town of Sugar Creek, Walworth County, Wisconsin.

Surveyed for: **Coldwell Banker, Beardsley & Associates**
102 North Wisconsin Street
Elkhorn, Wisconsin. 53121

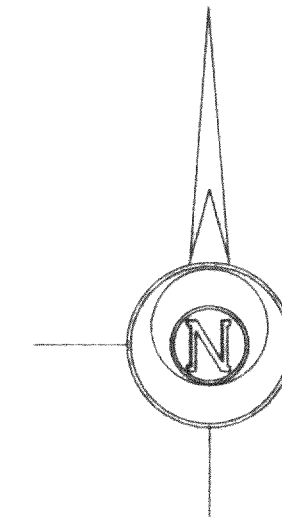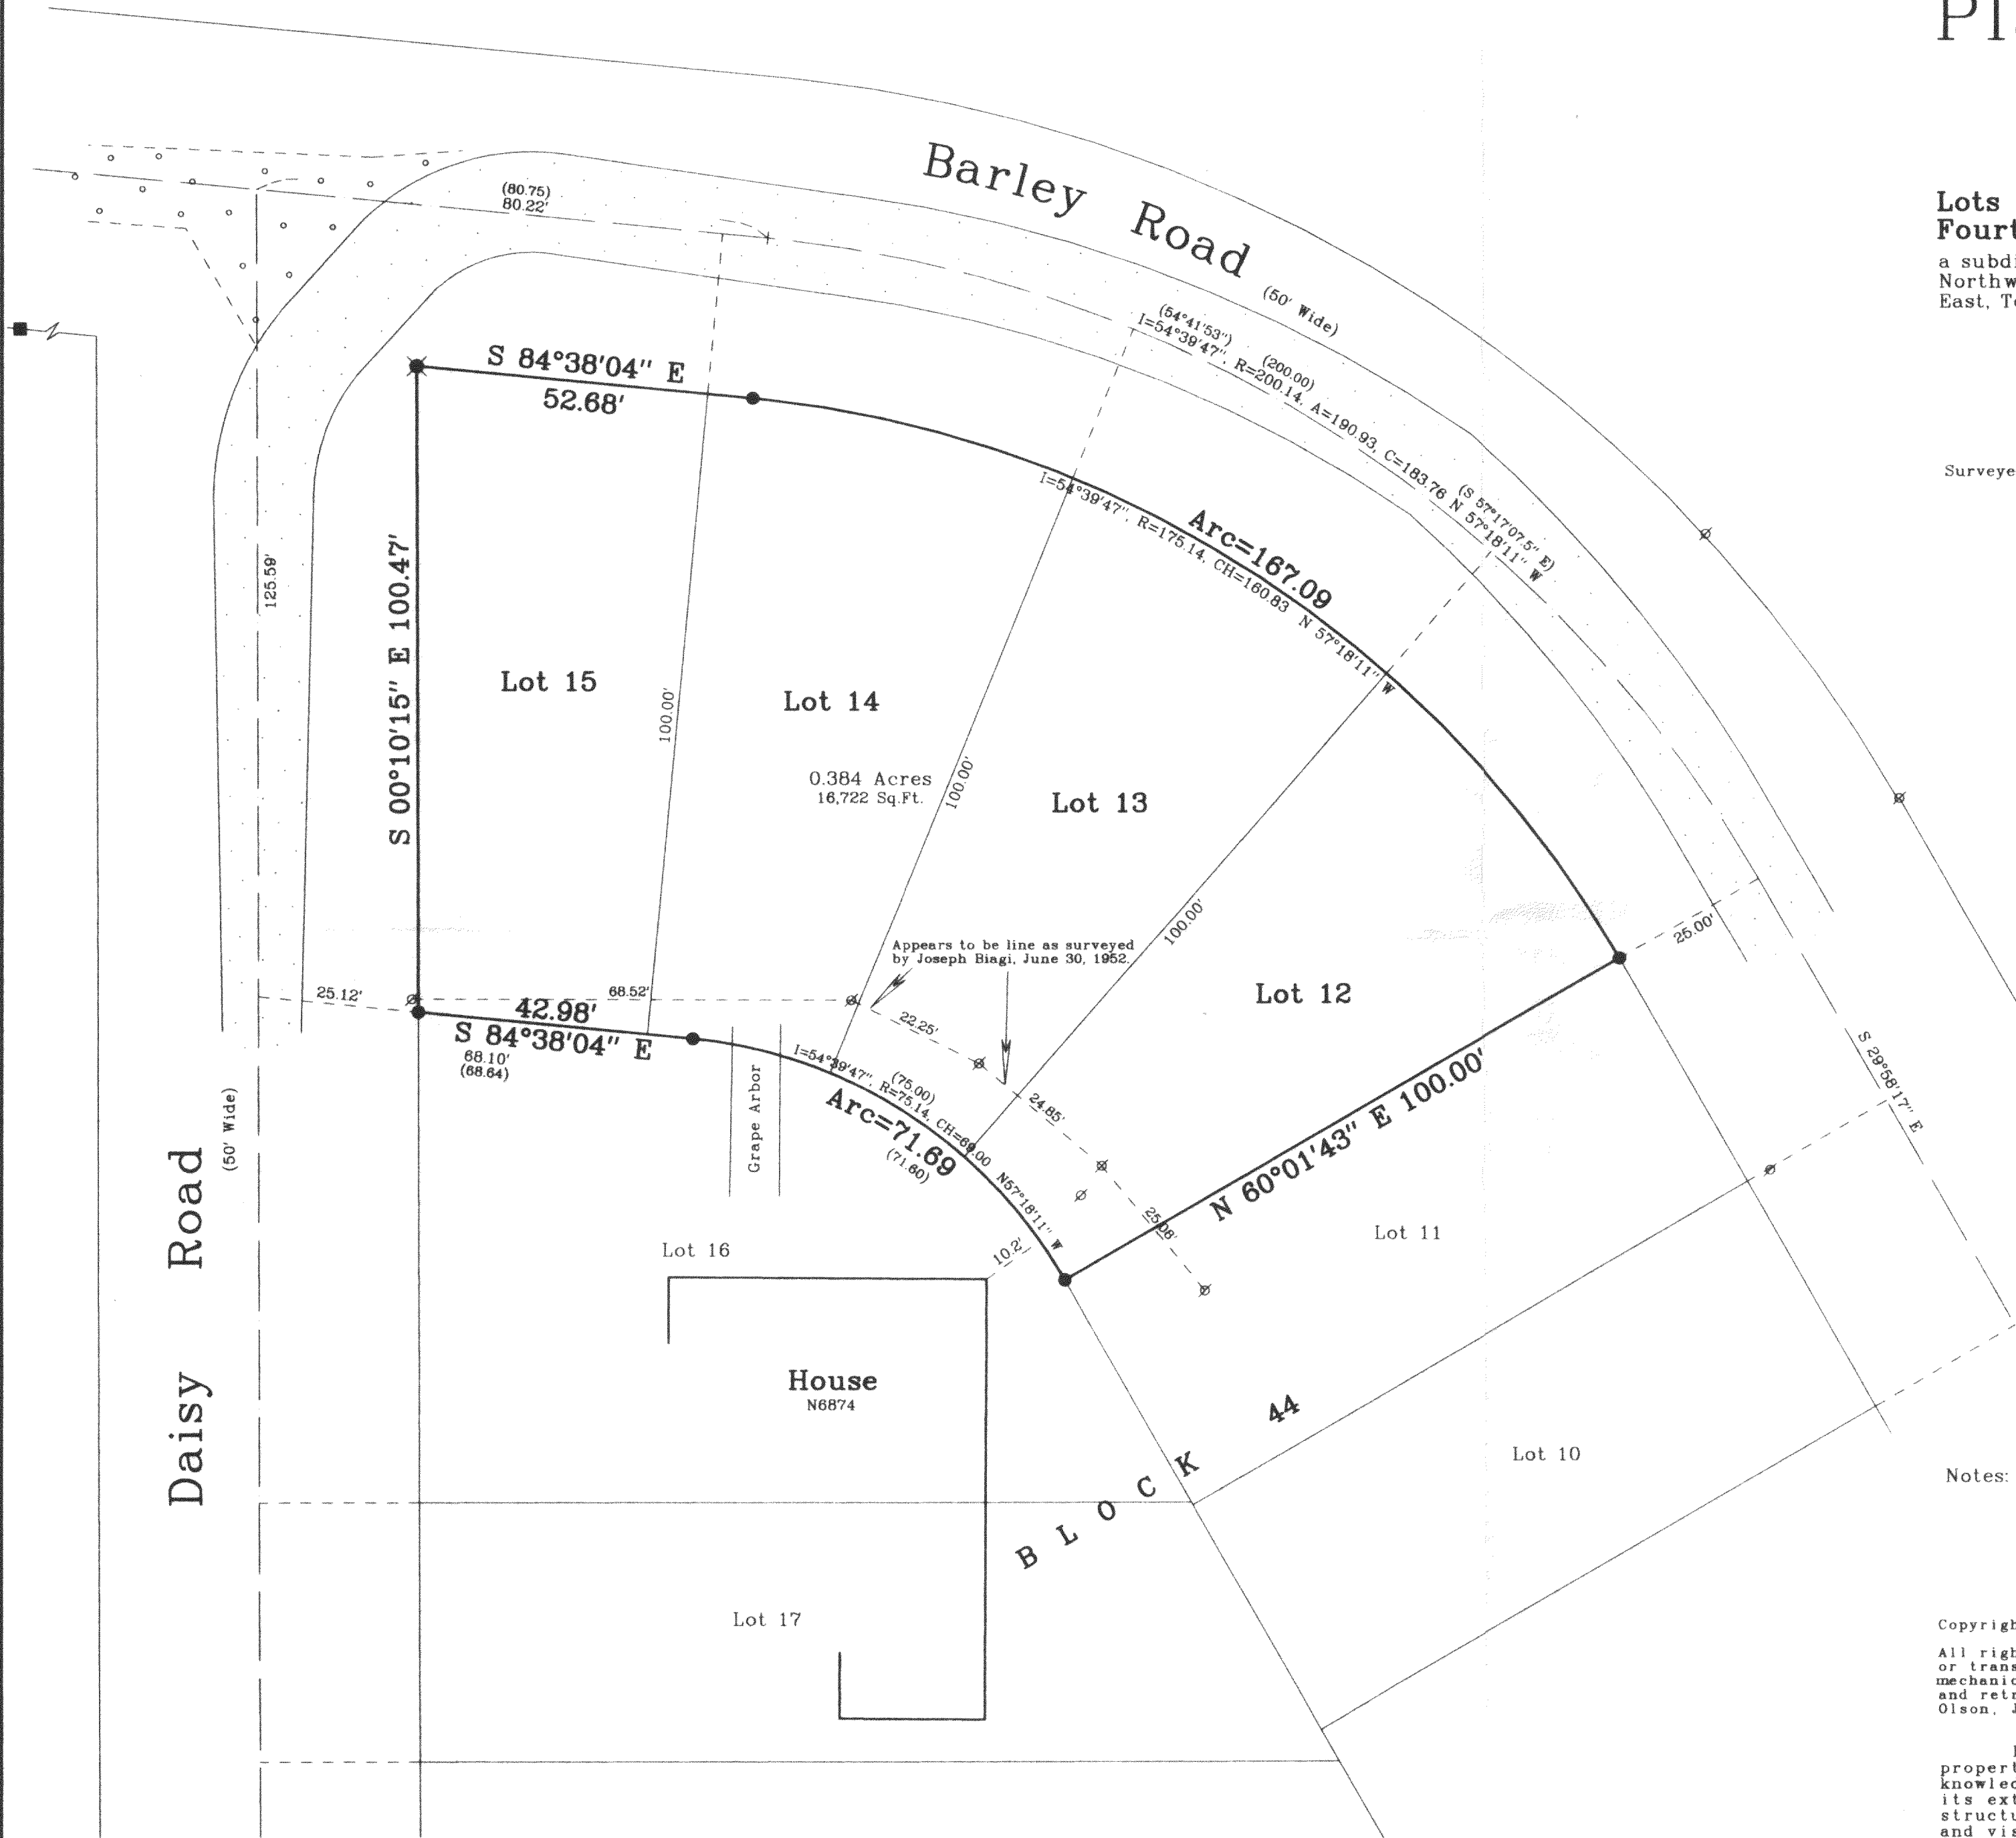

Bearings referenced to the subdivision plat.

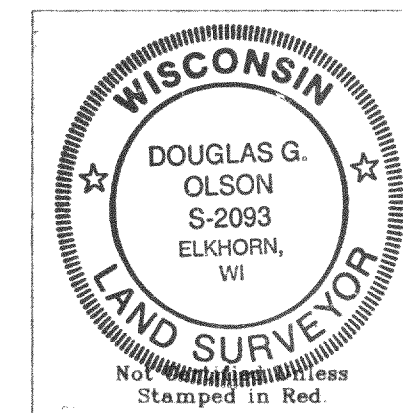

- Notes: 1) This survey plat is not certified unless signed and sealed in red ink.
- 2) This survey is subject to Wisconsin lien laws. This Plat of Survey is the notice of intent to file lien. Lien waiver required.

Copyright © 1999 by Jensen & Olson Land Surveying, LLC.


All rights reserved. No part of this survey plat may be reproduced or transmitted in any form by any means - graphic, electronic, or mechanical, including photocopying, tracing, or information storage and retrieval systems - without permission in writing from Douglas G. Olson, Jensen & Olson Land Surveying, LLC.

I hereby certify that I have surveyed the above described property and the map hereon is correct to the best of my professional knowledge and belief and shows the size and location of the property, its exterior boundaries, the location and dimensions of all visible structures thereon, boundary fences, apparent easements and roadways and visible encroachments, if any.

This survey is made for the exclusive use of the present owners of property, and also those who purchase, mortgage or guarantee title thereto, within one year from the date hereof.

Douglas G. Olson
Wisconsin Registered Land Surveyor - 2093

Survey Date: Dec. 2, 1999.
Revisions:

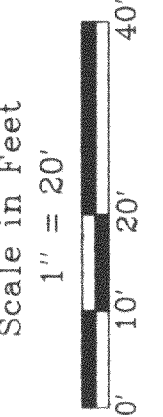

Jensen & Olson Land Surveying, LLC
45 South Wisconsin Street
Elkhorn, Wisconsin. 53121
Telephone (262) 723-3434
Facsimile (262) 723-8044

Legend

- Found Concrete Monument
- Found Iron Pipe
- Set Iron Rod, 1 3/16" dia.
- Set Iron Rod, 3/4" dia.
- Recorded Information
- Asphalt Surface
- Gravel Surface

Sheet 1 of 1 Sheets
Job Reference Number
1999.124

1999.124

GI-406

67-287
67-390

316-1197