


PLAT OF SURVEY

THE SOUTHERLY 1/2 OF LOT 14 AND
ALL OF LOTS 15,16,17, AND 24 AND
THE SOUTHEASTERLY 1/3 OF LOT 25
OF BLOCK 39 OF THE THIRD MAP OF
INTERLAKEN SUBDIVISION, TOWN OF
SUGAR CREEK, WALWORTH COUNTY,
WISCONSIN.


OWNER: DONITA M. PONTEL
N6704 TIPPECANOE TRAIL
ELKHORN, WI. 53121

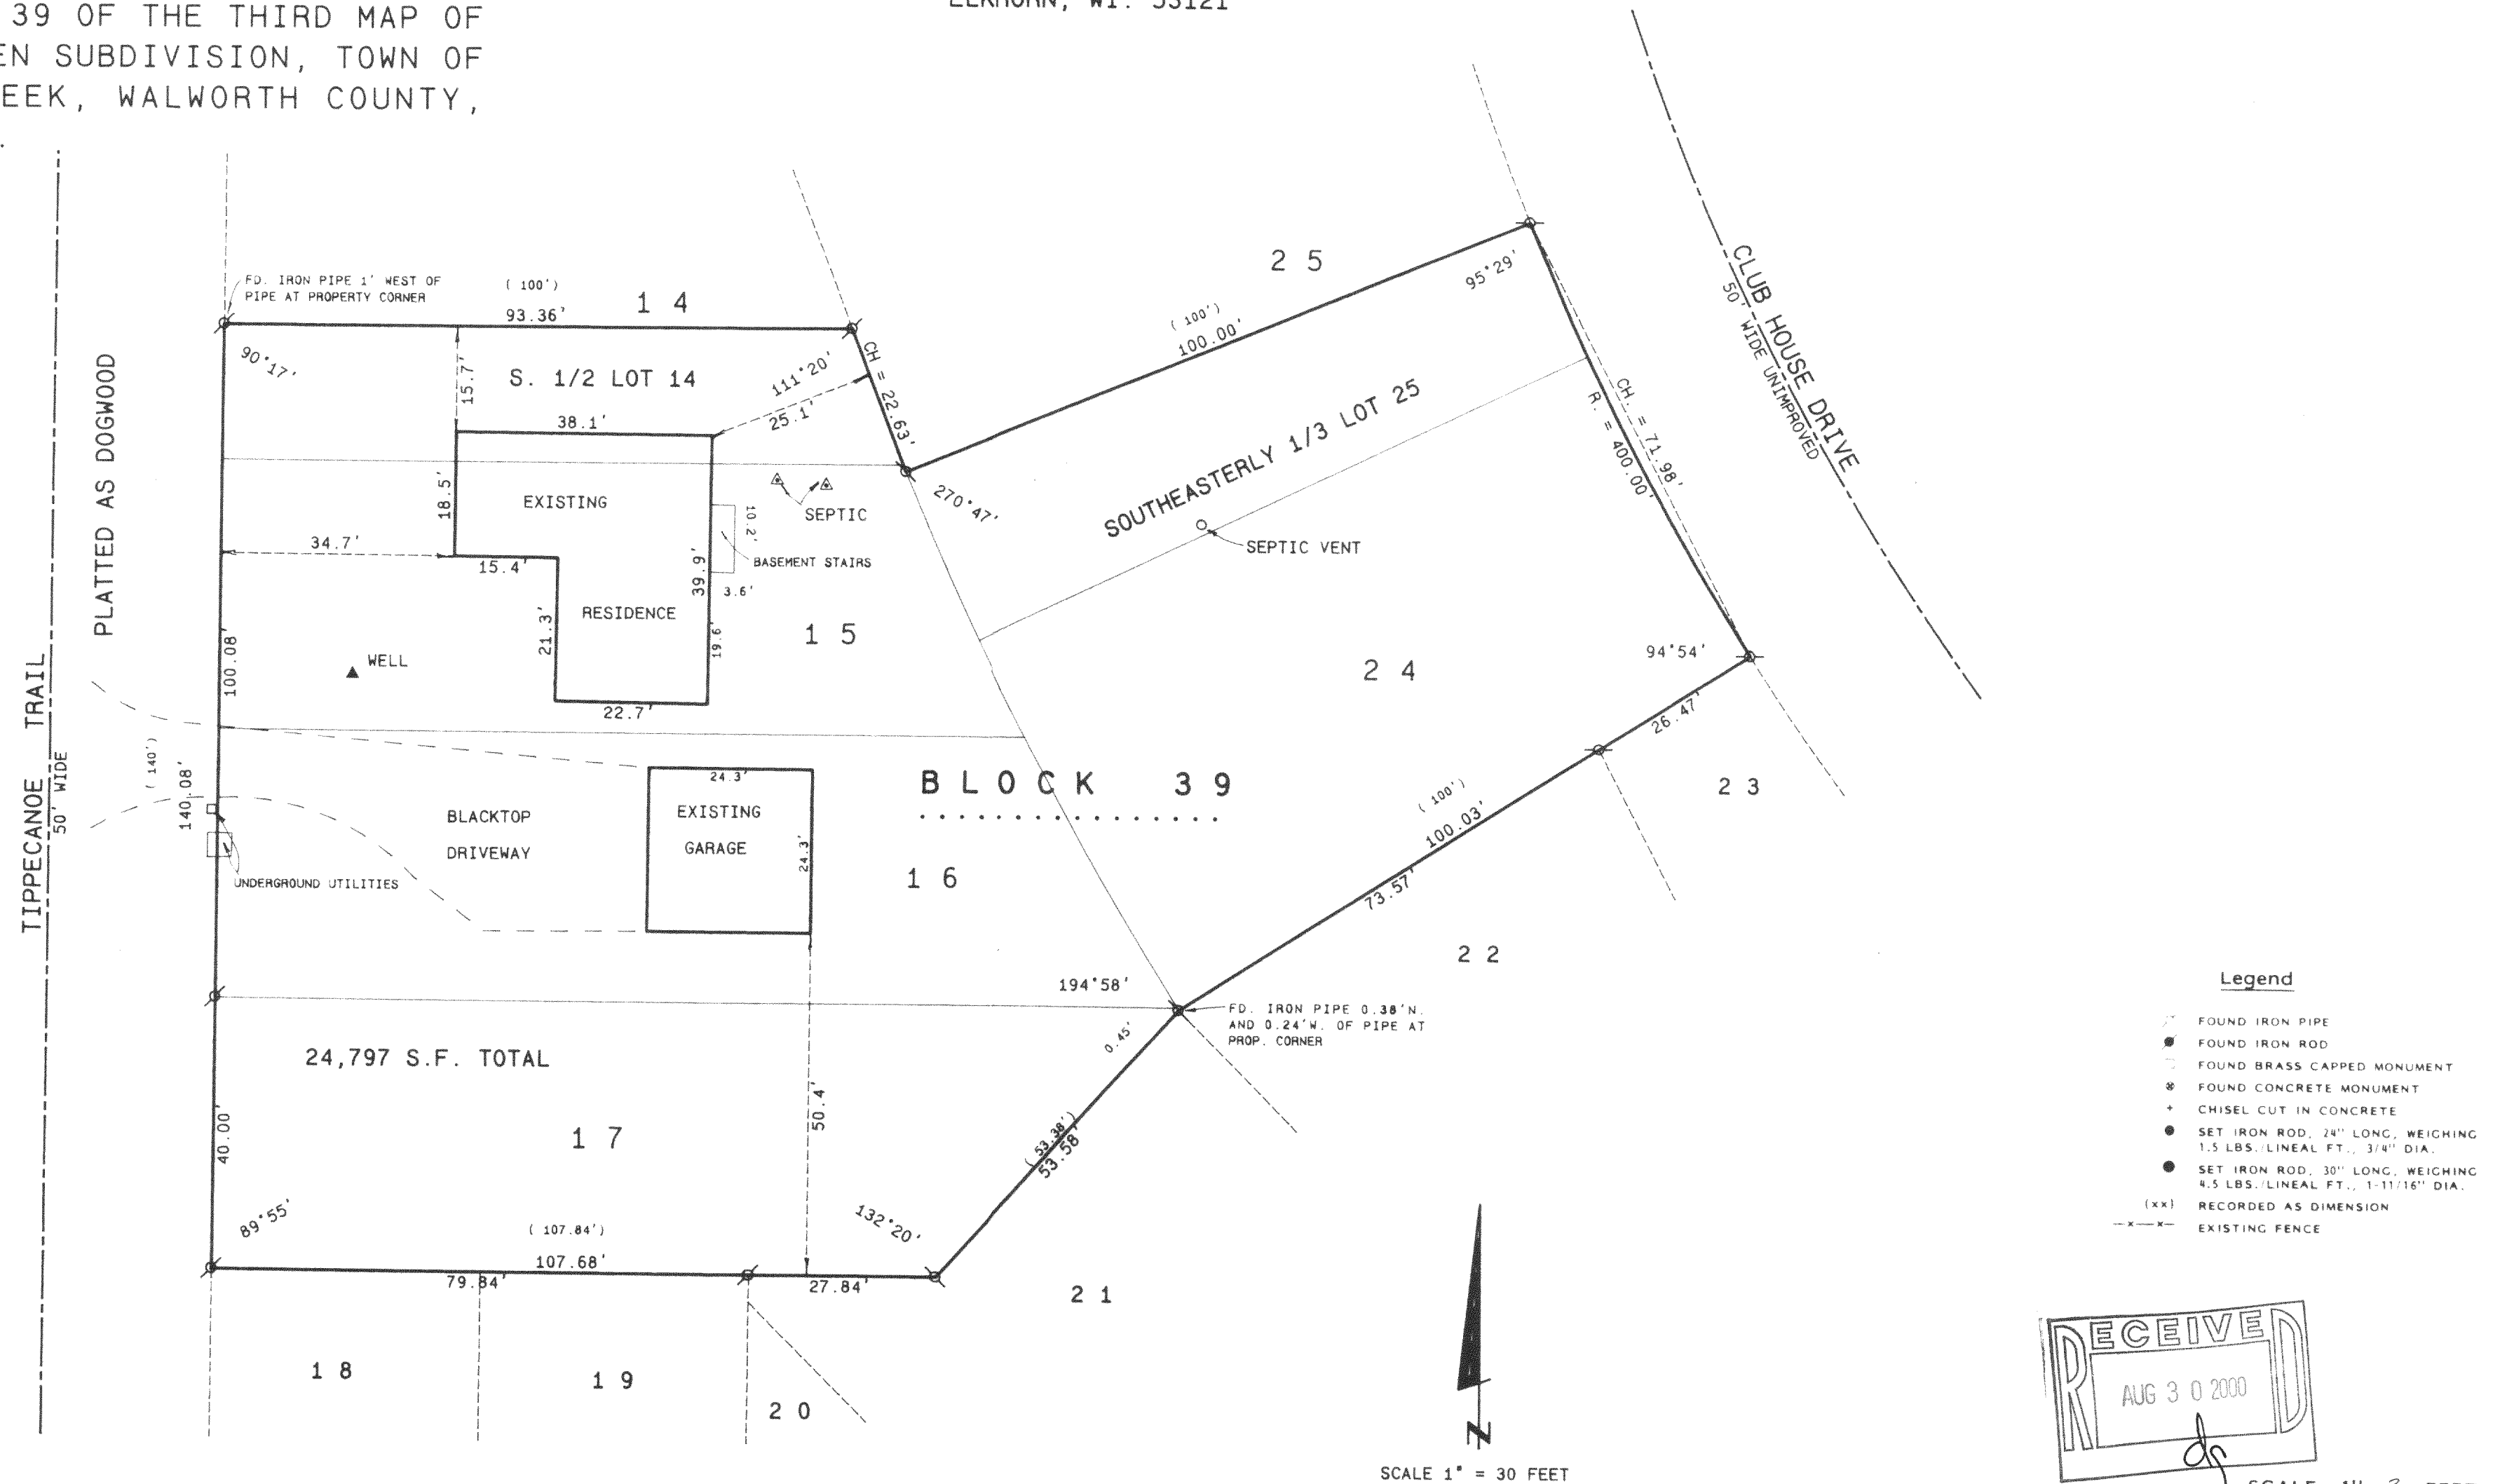


NOTES:

THIS SURVEY RETRACES A PREVIOUS PLAT OF SURVEY
PREPARED BY ROBT. BAERENWALD DATED FEB. 4, 1992 AS
JOB NO. 3347.

THE LOT DIMENSIONS ARE SHOWN TO THE RIGHT-OF-WAY
LINES FOR THIS PLAT, THE RECORDED PLAT SHOWS
DIMENSIONS TO THE CENTERLINE OF ROADS.

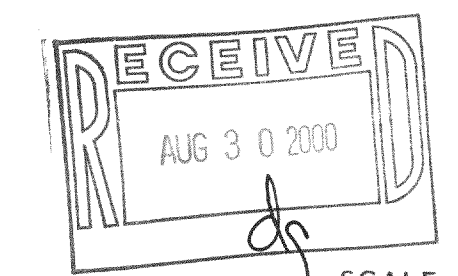

SCALE: 1" = 30 FEET

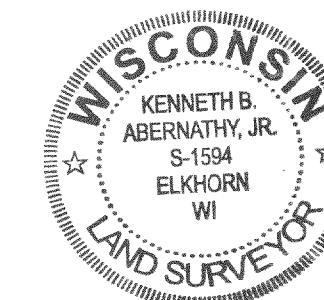

"I hereby certify that the above described property has been surveyed
by me or under my direction and that the above map is a true
representation thereof and shows the size and location of the property, its
exterior boundaries, the location of all visible structures and dimensions of
all principal buildings thereon, boundary fences, apparent easements,
roadways and visible encroachments, if any."
"This survey is made for the use of the present owners of the property,
and also those who purchase, mortgage, or guarantee the title thereto within
one year from date hereof."

Kenneth B. Abernathy Jr.
KENNETH B. ABERNATHY, JR.
WISCONSIN REGISTERED LAND SURVEYOR,
S-1594

Date: 6-23-00 Job No. 00604

316-1232