



PLAT OF SURVEY

J.K. SURVEYING INC.
7561 336TH AVE.
BURLINGTON WI 53105
262-537-4274

OF

LOTS 8, 9, 10 AND 11, BLOCK 28 INTERLAKEN, A SUBDIVISION LOCATED IN SECTION 11, TOWN 3 NORTH, RANGE 16 EAST, TOWN OF SUGAR CREEK, WALWORTH COUNTY, WISCONSIN.

PREPARED FOR : ABE GOLDSMITH

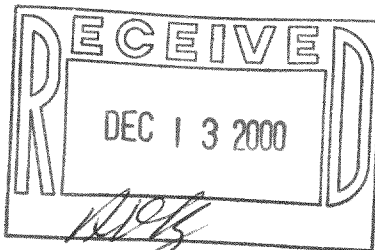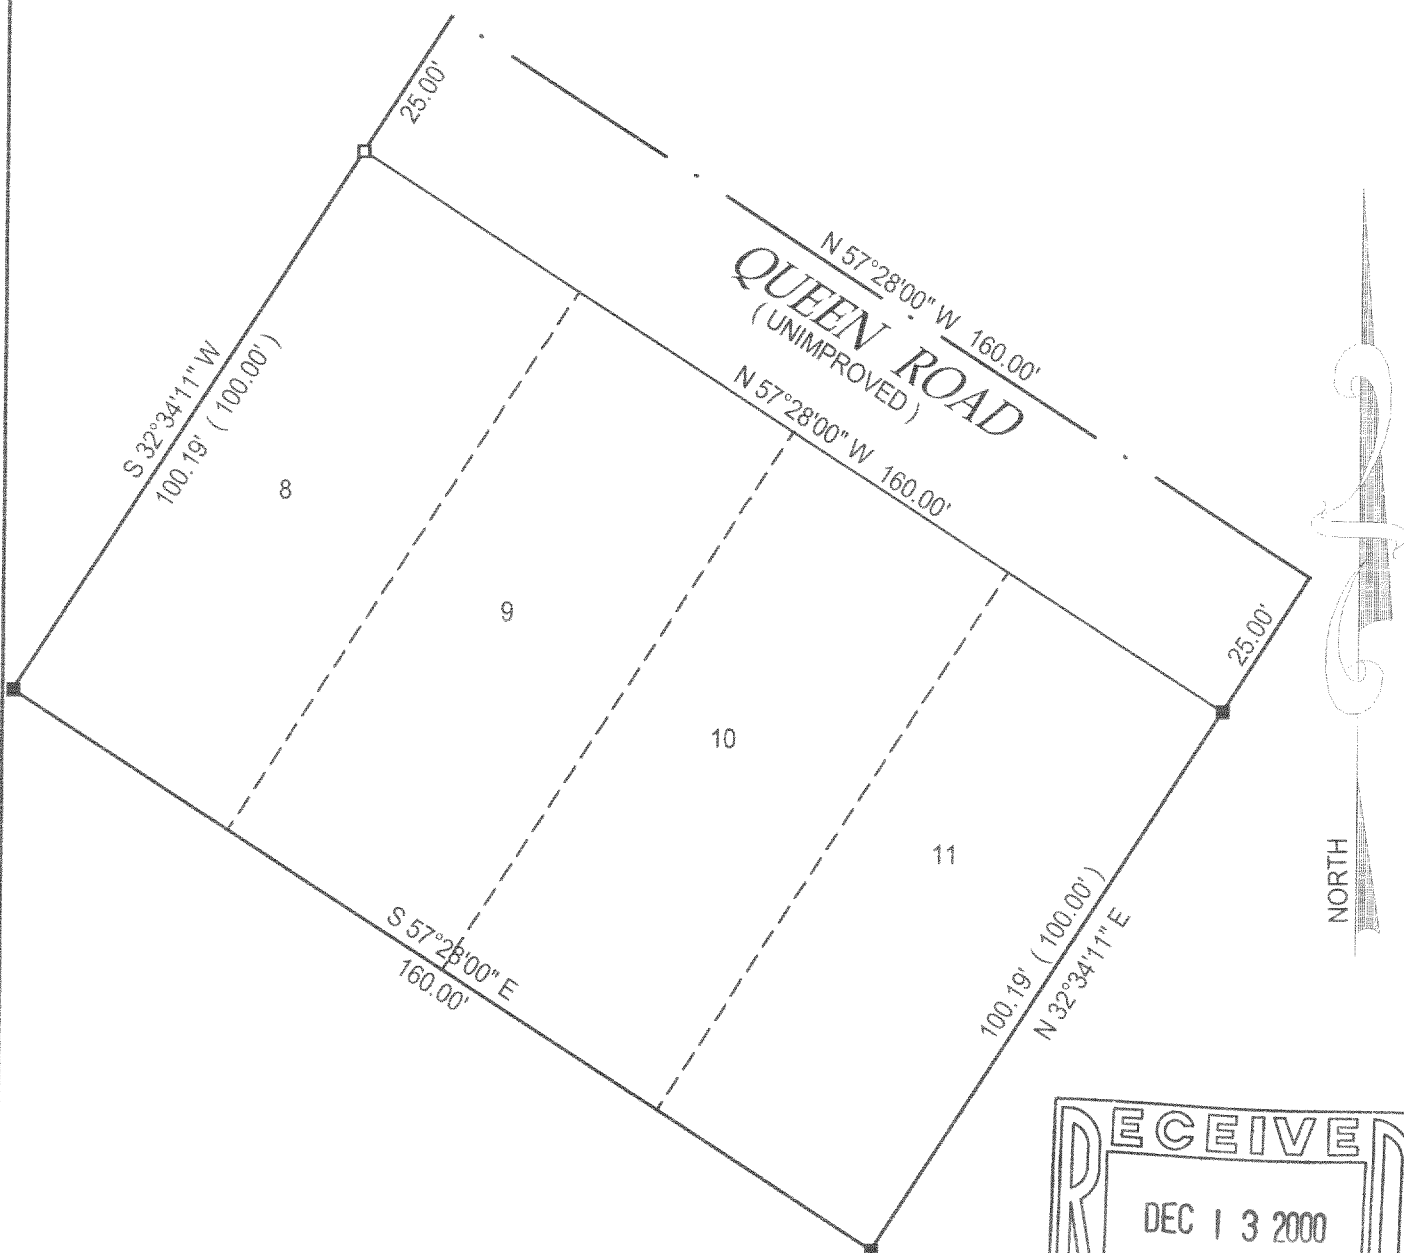

() = recorded as

■ = set iron bar

□ = found iron bar

○ = found iron pipe

● = set iron pipe

COMPARE LEGAL DESCRIPTION ABOVE AND DRAWING WITH DEED. FOR BUILDING RESTRICTIONS AND EASEMENTS NOT SHOWN, REFER TO DEED, ABSTRACT SOURCES AND LOCAL MUNICIPAL CODES. NOTIFY THE SURVEYOR IMMEDIATELY OF ANY DISCREPANCY.

"I hereby certify that I have surveyed the above described property and that the above map is a true representation thereof and shows the size and location of all visible structures, apparent easements and encroachments if any."

This survey is made for the present owners of the property, and those who purchase, mortgage, or guarantee the title thereto, within one year from the date hereof.

JOB# 00-510

SCALE: 1"=30'

TAX KEY #
PART OF GI-272A

DATED THIS 2 TH DAY OF October 20 00

JEFFREY L KIMPS S - 2436
Wisconsin Registered Land Surveyor
(original if signed in red)



GI-272

316-1249