
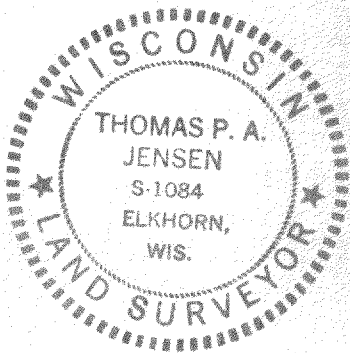


PLAT OF SURVEY

OF

BASEMENT LOCATION ON LOT 2 OF CERTIFIED
SURVEY NUMBER 88, LOCATED IN SECTION 21,
T3N R16E, WALKWORTH COUNTY, WISCONSIN.

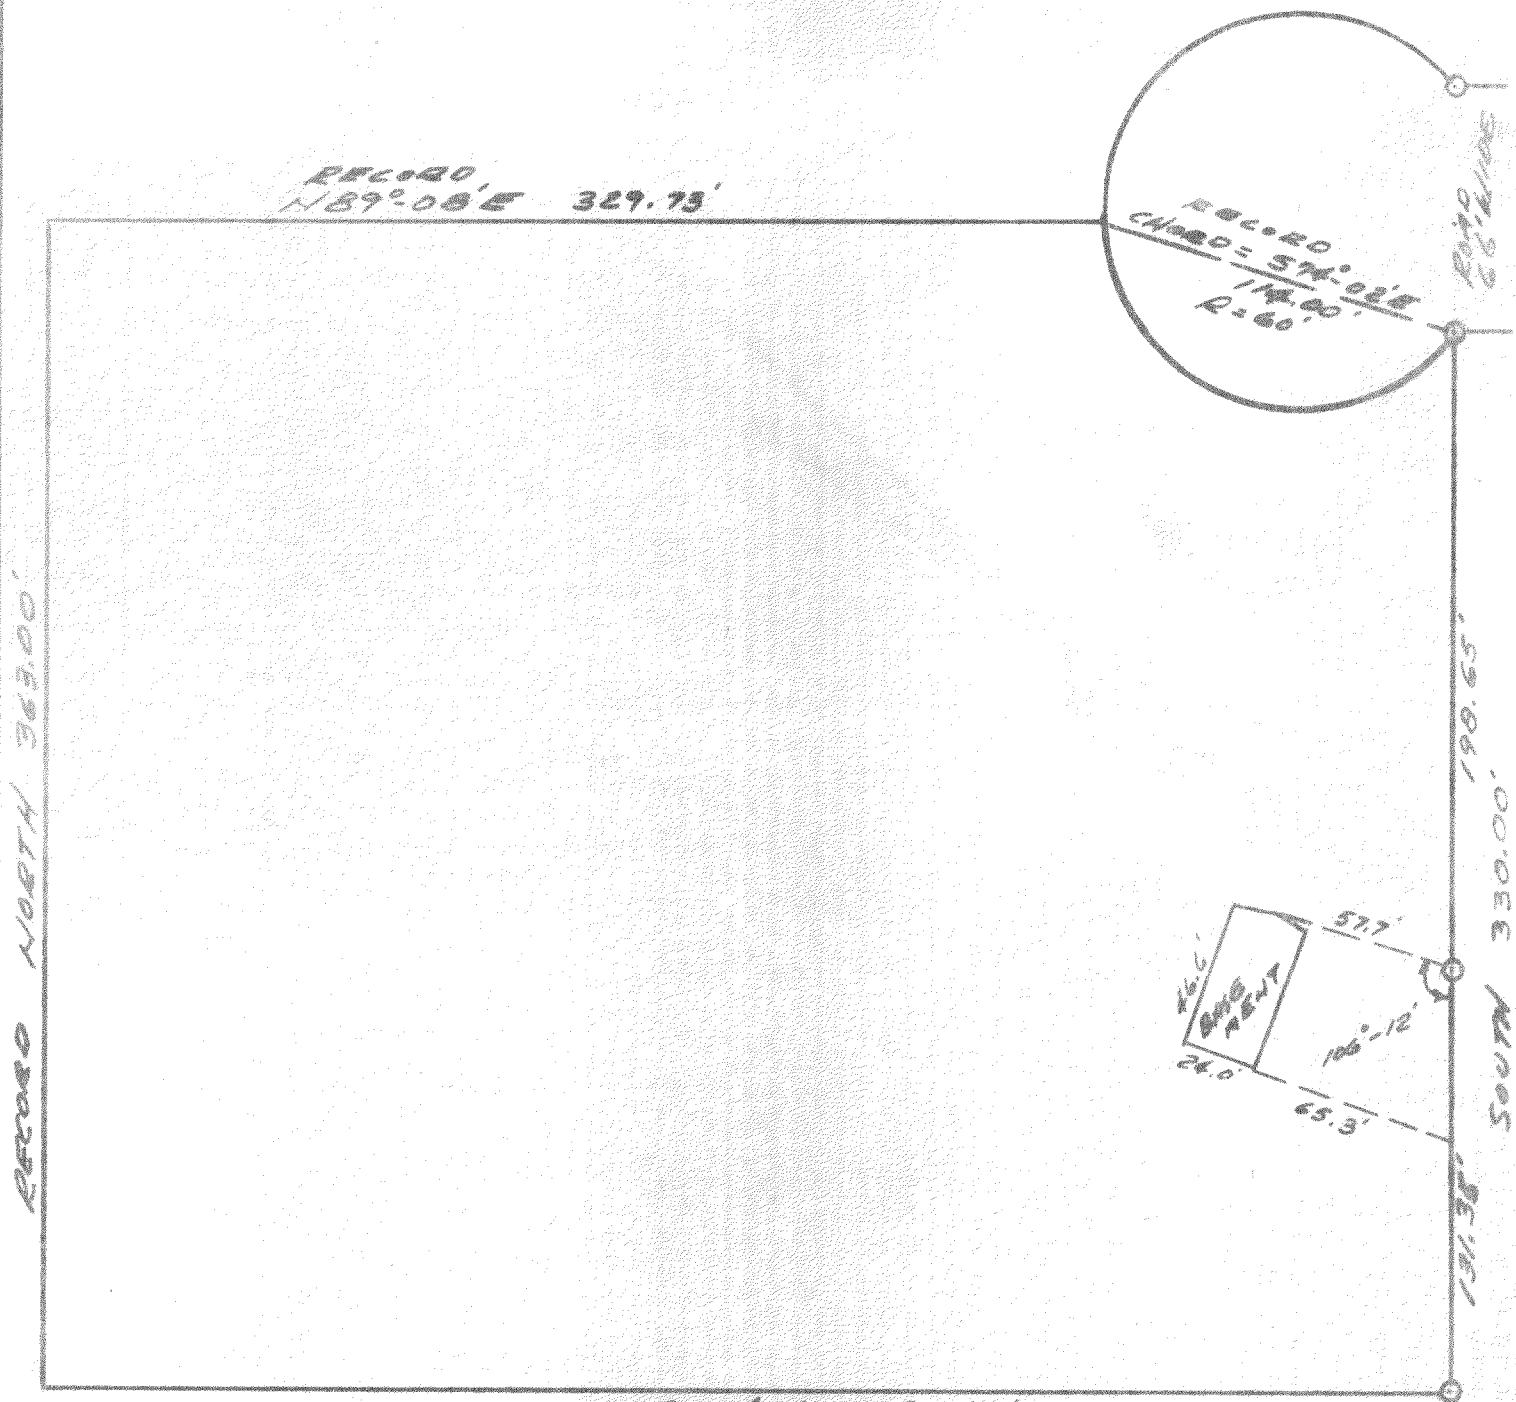

SURVEY AND PLAT BY
JENSEN & JOHNSON, INC.
CIVIL ENGINEERS AND SURVEYORS

Elkhorn, Wisconsin

LEGEND

- — Iron Pipe FOUND
 - — Concrete Monument
- Scale 1" = 60'

WE CERTIFY: That we have surveyed the above described property and that the plat shown hereon is an accurate survey and a true representation thereof and correctly shows the exterior boundary lines and all divisions of said property, AND ALL BUILDINGS HEREON.

Date SEPT. 6, 1973

Thomas P. A. Jensen

Wisconsin Registered Land Surveyor, No. S-1084

Lot 2, Cert. Survey 88

316-126