


PREPARED FOR: LEO MORITZ
15733 S LARAMIE AVE
OAK FOREST IL
60452

PLAT OF SURVEY


- OF -

J.K. SURVEYING INC.
N3705 WILLOWBEND LANE
LAKE GENEVA, WI, 53147
262-248-3697

LOTS 4,5,6,7, & 8 OF BLOCK 3, NORTH LAKE EVERGREEN BEACH SUBDIVISION,
ACCORDING TO THE RECORDED PLAT THEREOF IN VOLUME 9 OF PLATS,
PAGES 46 AND 47, TOWN OF SUGARCREEK, WALWORTH COUNTY, WISCONSIN

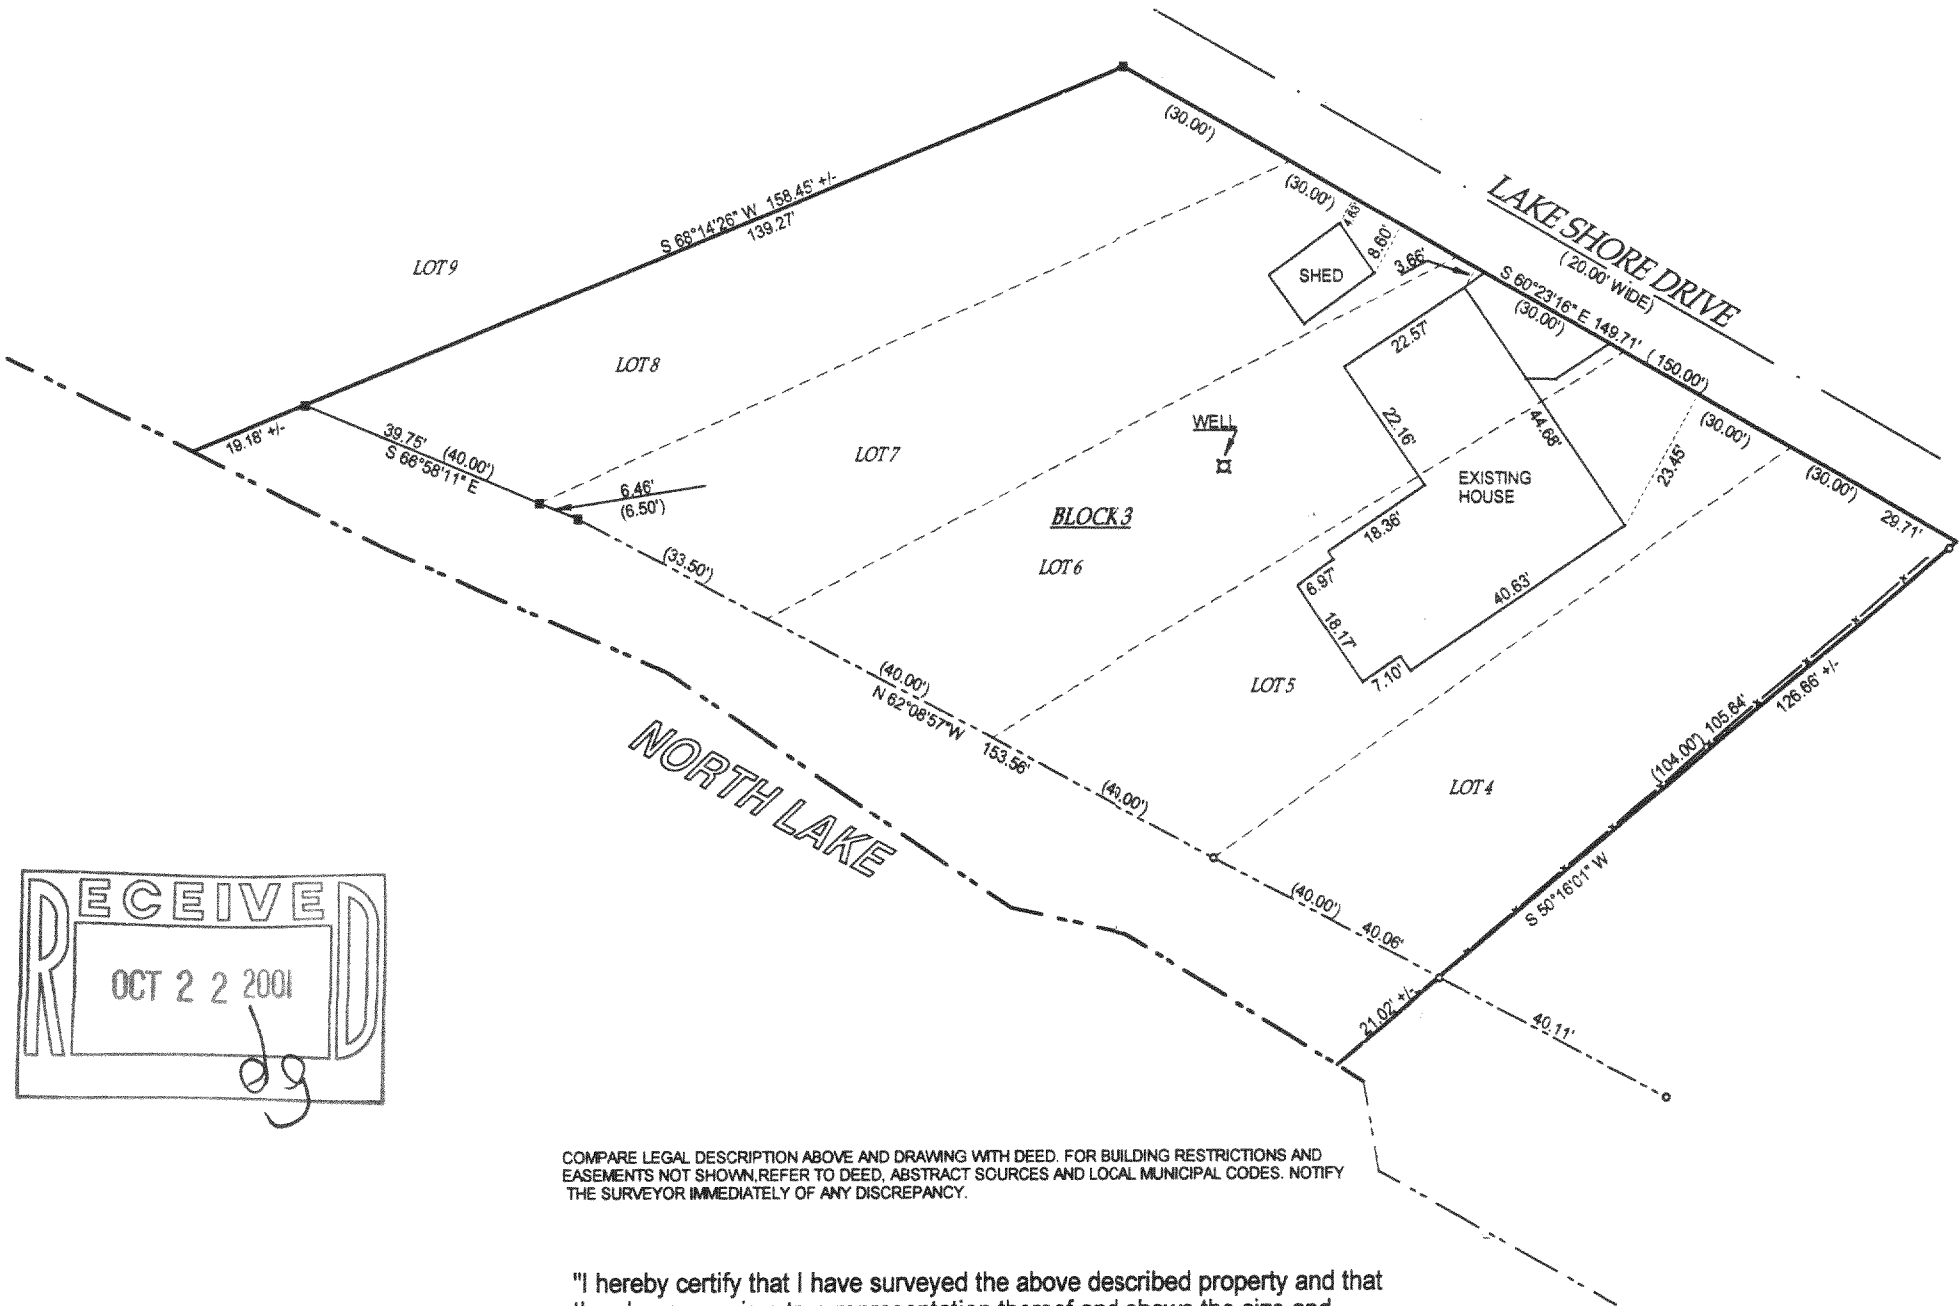

- () = recorded as
- = found iron bar
- = found iron pipe
- = set iron pipe
- = set iron bar

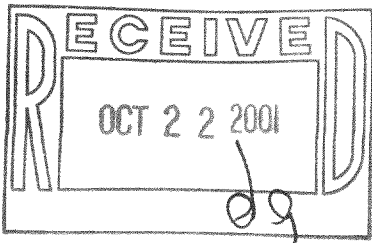

SCALE 1" = 30'

JOB # 01-032E

TAX ID # 3-16-GNLE-11

COMPARE LEGAL DESCRIPTION ABOVE AND DRAWING WITH DEED. FOR BUILDING RESTRICTIONS AND EASEMENTS NOT SHOWN, REFER TO DEED, ABSTRACT SOURCES AND LOCAL MUNICIPAL CODES. NOTIFY THE SURVEYOR IMMEDIATELY OF ANY DISCREPANCY.

"I hereby certify that I have surveyed the above described property and that the above map is a true representation thereof and shows the size and location of all visible structures, apparent easements and encroachments if any."

This survey is made for the present owners of the property, and those who purchase, mortgage, or guarantee the title thereto, within one year from the date hereof. DATED THIS 26 TH, DAY OF APRIL 20 01.



John P. Krott
JOHN KROTT S - 2258
Wisconsin Registered Land Surveyor
(original if signed in red)

GNLE-11

316-1322