
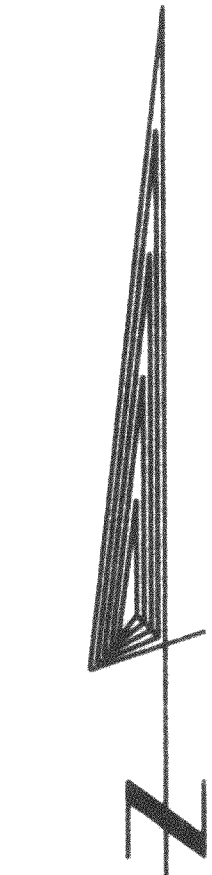


PLAT OF SURVEY

The Northeastly 1/2 of Lot 22, and all of
Lots 23, 24, and 25 in Block 33 of Interlaken
Subdivision, Town of Sugar Creek, according to the
recorded plat thereof.

OWNERS:
RENATA & SLAWOMIR RYBICKI
W2678 KNIEP ROAD
ELKHORN, WI 53121

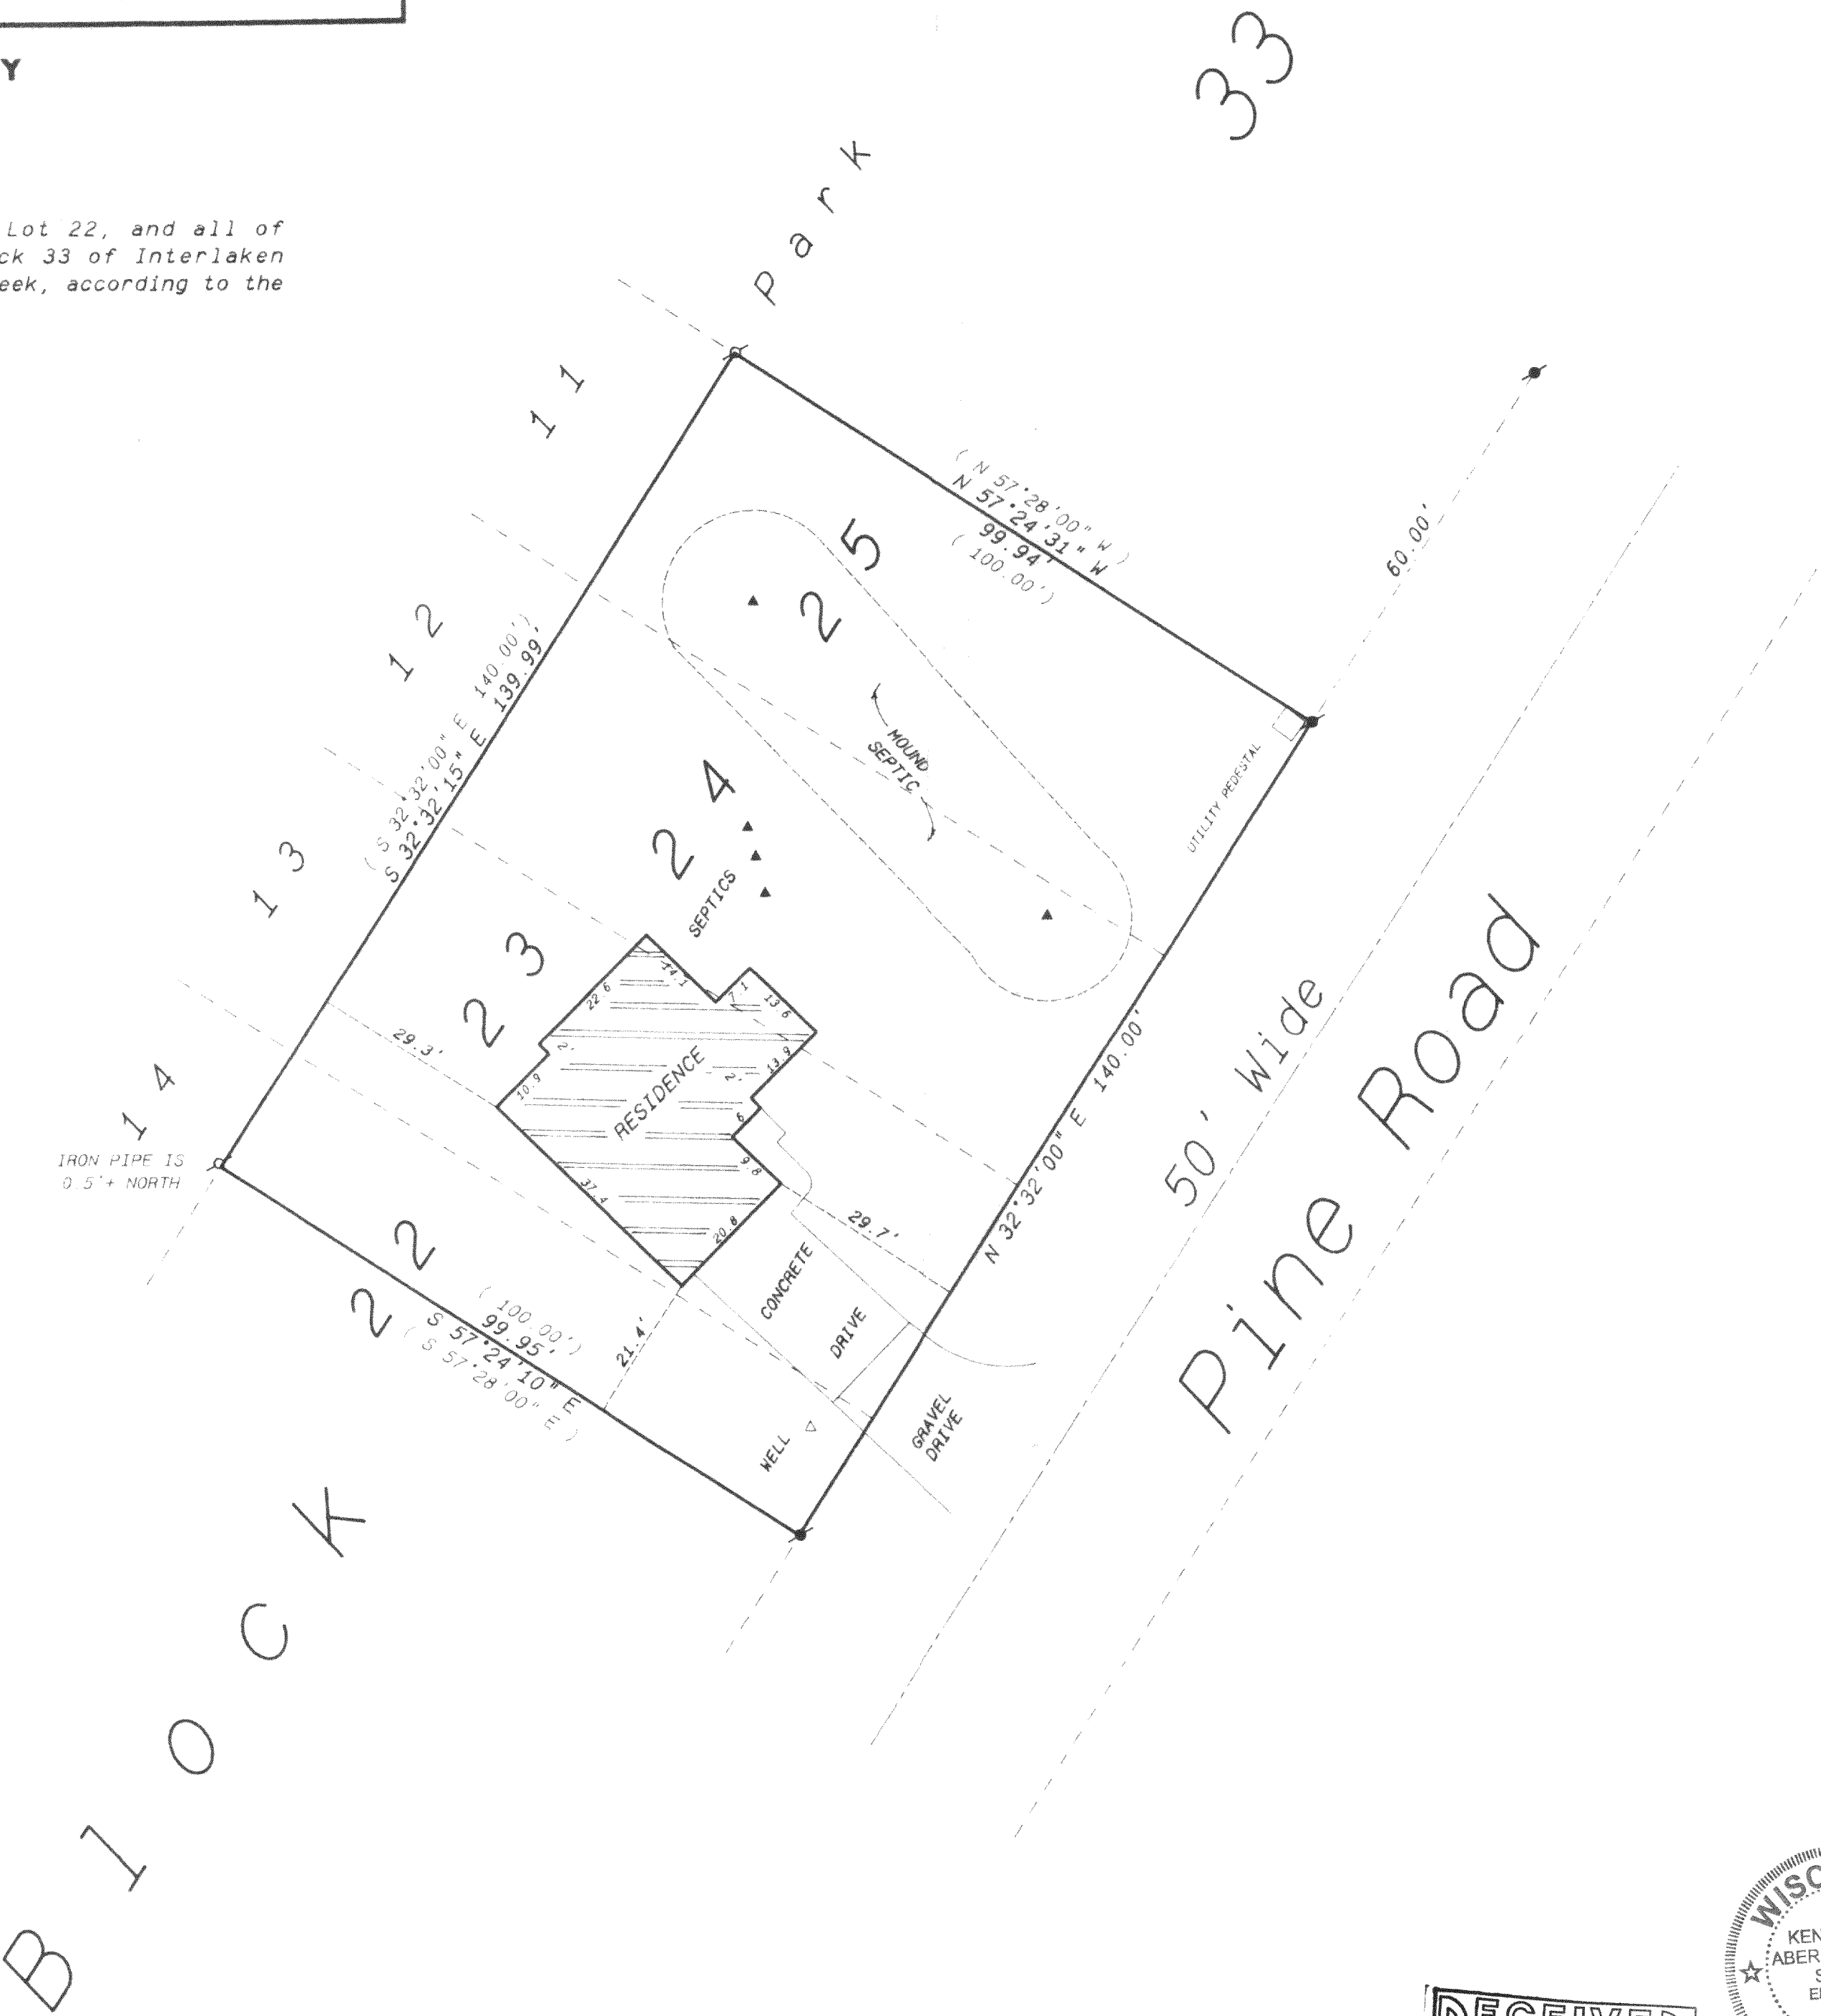

SCALE: 1 INCH = 20 FEET


- Legend
- FOUND IRON PIPE
 - FOUND IRON ROD
 - FOUND BRASS CAPPED MONUMENT
 - ✱ FOUND CONCRETE MONUMENT
 - ✱ CHISEL CUT IN CONCRETE
 - SET IRON ROD, 24" LONG, WEIGHING 1.5 LBS., LINEAL FT., 3/4" DIA.
 - SET IRON ROD, 30" LONG, WEIGHING 4.5 LBS., LINEAL FT., 1 1/16" DIA.
 - (XX) RECORDED AS DIMENSION
 - - - - - EXISTING FENCE

SCALE: 1" = 20 FEET

I hereby certify that the above described property has been surveyed by me or under my direction and that the above map is a true representation thereof and shows the size and location of the property, its exterior boundaries, the location of all visible structures and dimensions of all principal buildings thereon, boundary lines, adjacent easements, setbacks and other encroachments, if any.

This survey is made for the use of the present owners of the property, and a certificate of purchase, mortgage or guarantee the title thereto within one year from date hereof.

Kenneth B. Abernathy, Jr.
KENNETH B. ABERNATHY, JR.
WISCONSIN REGISTERED LAND SURVEYOR,
S-1594
Date: July 20, 2001 Job No. 96.921

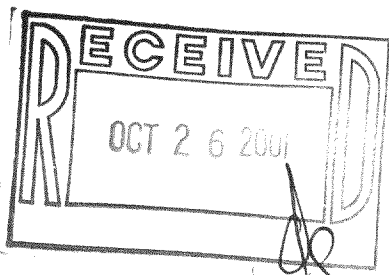

GI-291

316-1333