


ABELL
SURVEYING & MAPPING

1140 SEQUOIA STREET • DELAVAN, WISCONSIN 53115
262-728-6737

NORTHEAST CORNER
BLOCK 104

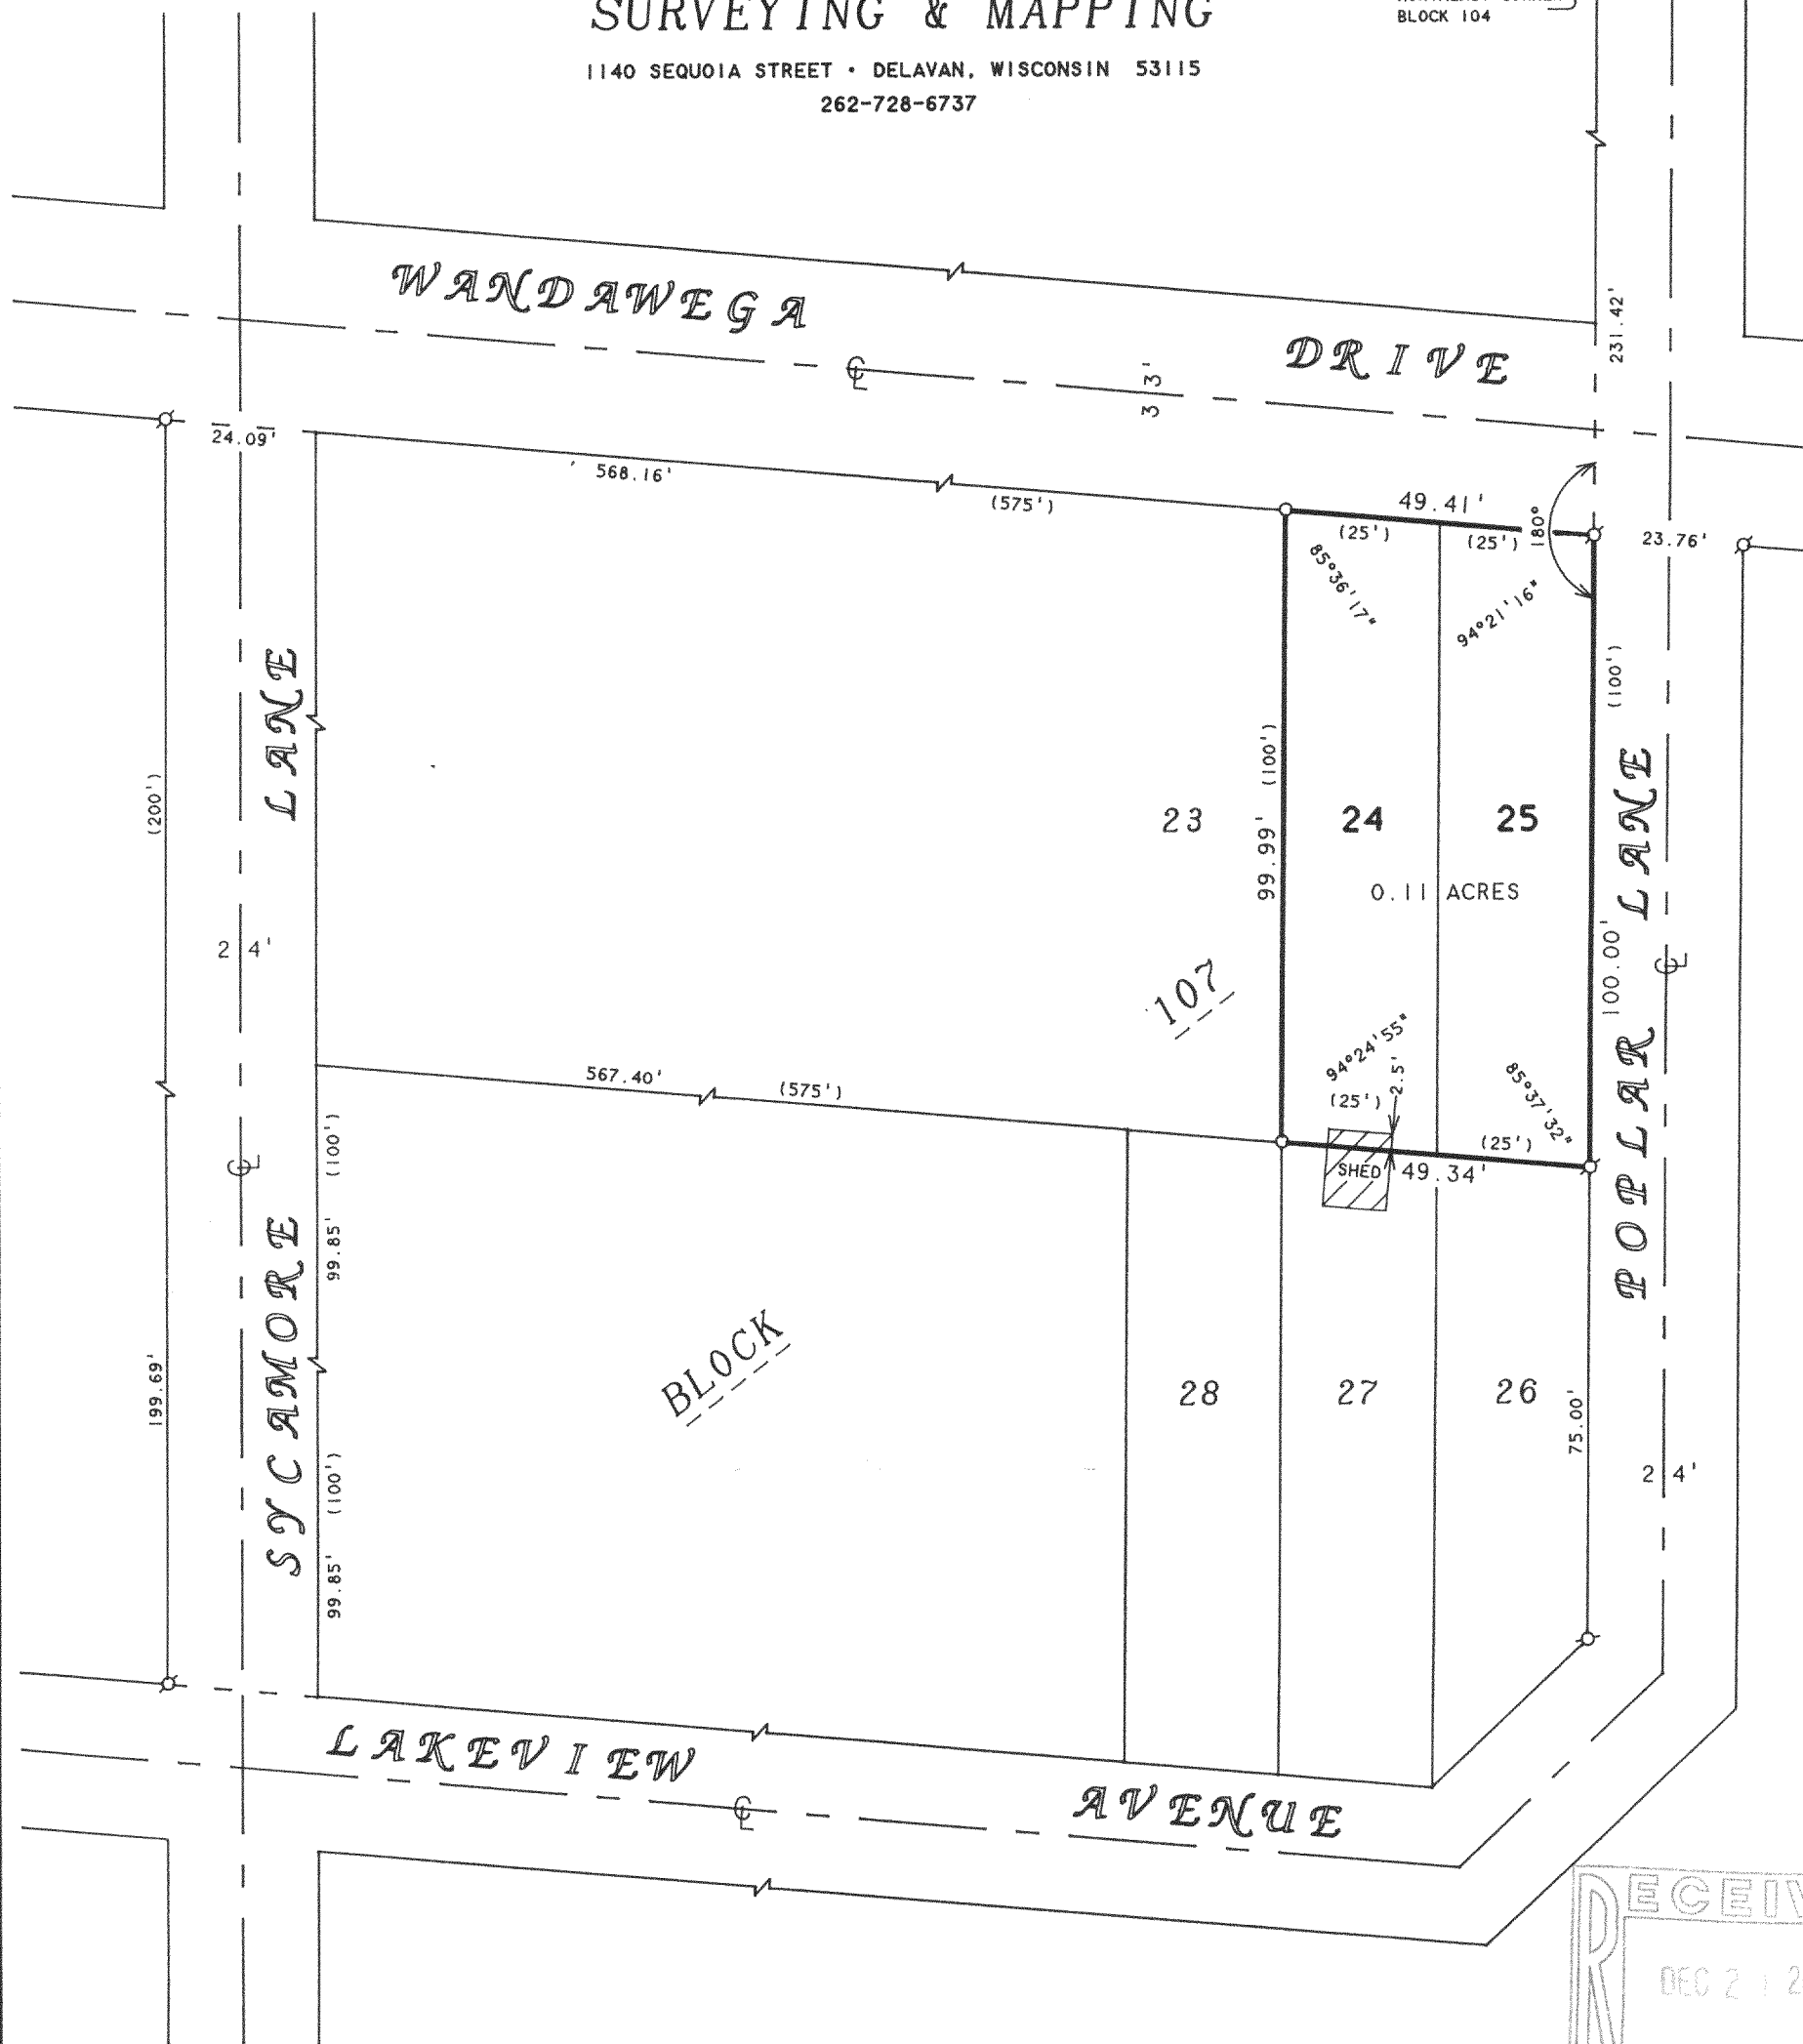

PLAT OF SURVEY OF

LOTS 24-25, BLOCK 107, LAKE WANDAWEGA SUBDIVISION,
LOCATED IN T3N, R16E, WALWORTH COUNTY, WISCONSIN.

ORDERED BY: BETH JOHNSON
W5404 LAKEVIEW DRIVE
ELKHORN, WI 53121

I, DAVID F. ABELL, DO HEREBY CERTIFY THAT I HAVE SURVEYED THE PROPERTY HEREON
DESCRIBED ACCORDING TO THE OFFICIAL RECORDS AND THAT THE PLAT HEREON IS A
CORRECT REPRESENTATION OF THE PROPERTY LINES TO THE BEST OF MY KNOWLEDGE AND
BELIEF.

David F. Abell

DAVID F. ABELL
WISCONSIN REGISTERED LAND SURVEYOR, S-1596

July 26, 2001

DATE: July 26, 2001 JOB NUMBER - 00044A
NOTE: THIS IS NOT A CERTIFIED COPY UNLESS SEALED.

N



SCALE 1"=30'

LEGEND

- Ø - IRON PIPE FOUND
- - 1" DIA. IRON PIPE SET
- () - RECORDED AS

GLW-2901

316-1339