


HAROLD H. KOLB
REGISTERED PROFESSIONAL LAND SURVEYOR
LAKE GENEVA, WISCONSIN

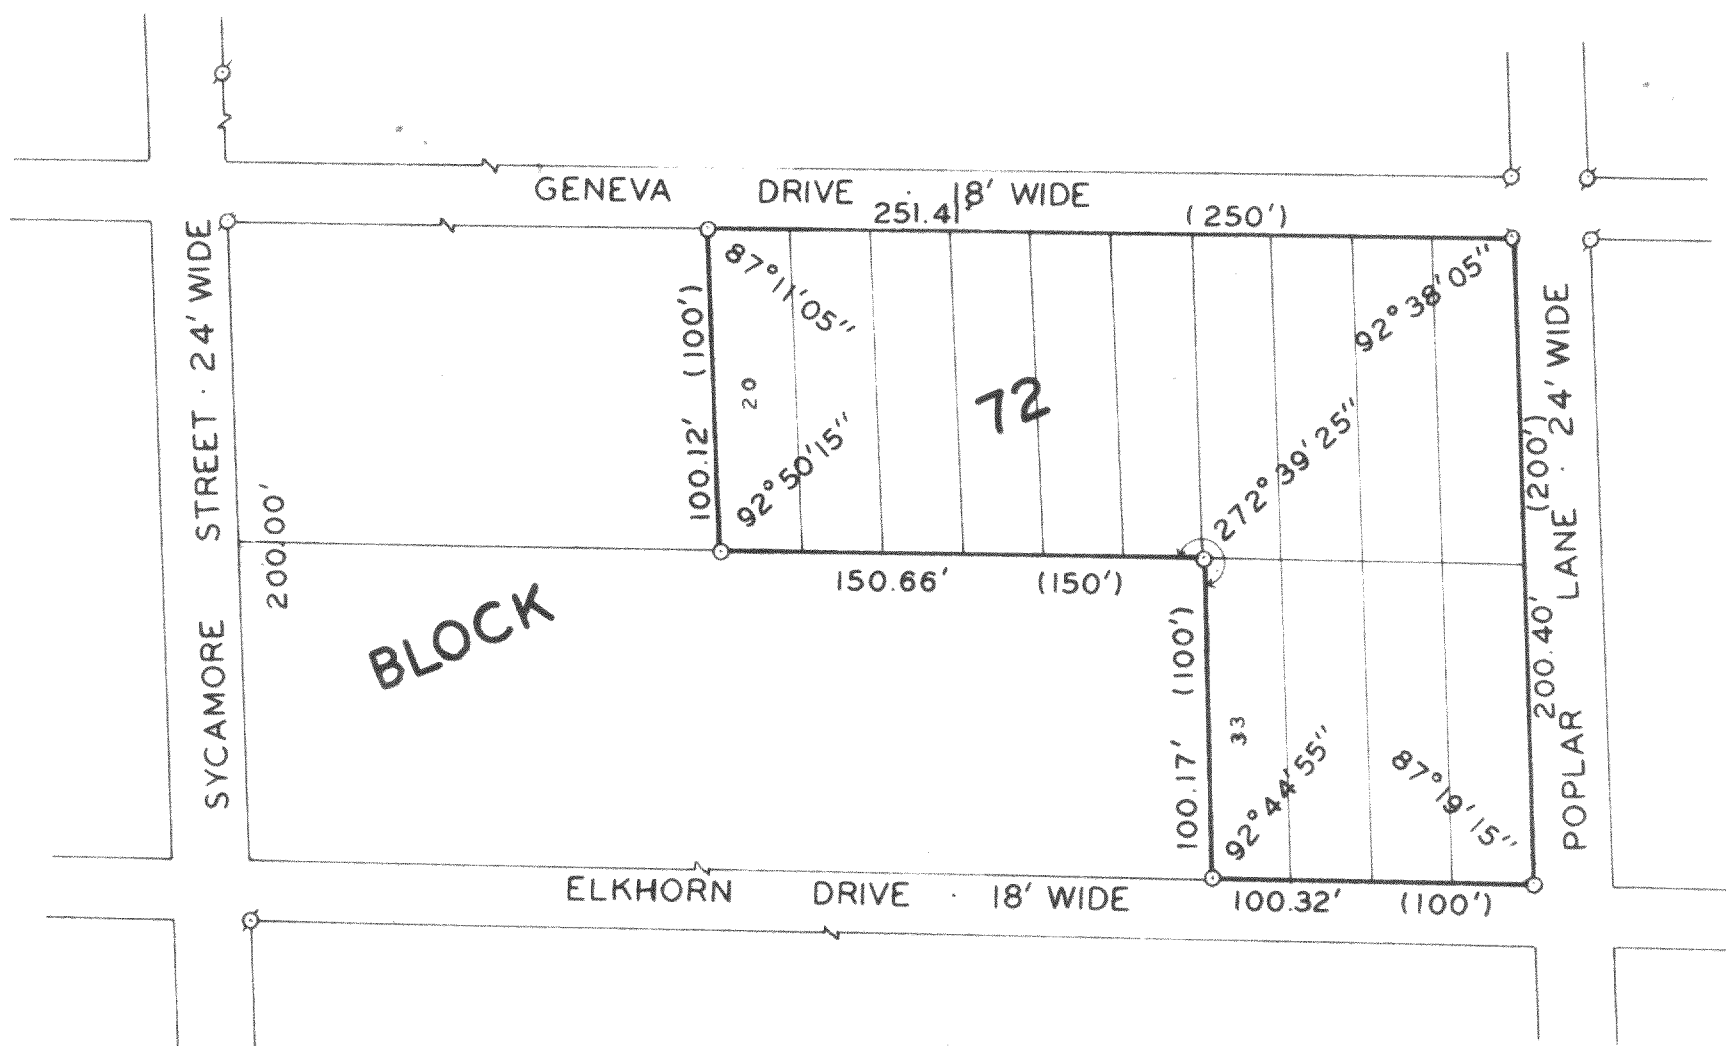


PLAT OF SURVEY OF

Lots 20-33, Block 72, Lake Wandawega Sub-
division, T 3 N, R 16 E, Walworth County,
Wisconsin.

NOTE: Distances shown are proportional to
the over-run found between the block corners.

OWNER: Edward Durka

Accuracy: Distances $\pm 0.01'$
Angles $\pm 05''$
Error of closure- less than 1/3000

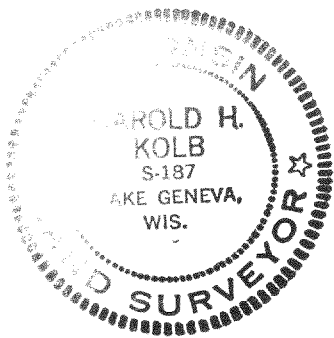

SCALE - 1" = 60'

LEGEND

- ⊗ - IRON PIPE FOUND
- - IRON PIPE PLACED
- - CONCRETE MONUMENT
- x - SPIKE
- () - AS PLATTED

I, HAROLD H. KOLB, DO HEREBY CERTIFY THAT I HAVE
SURVEYED THE PROPERTY HEREON DESCRIBED ACCORDING
TO THE OFFICIAL RECORDS, AND THAT THE PLAT HEREON
IS A CORRECT REPRESENTATION OF THE LOT LINES.

Harold H. Kolb

HAROLD H. KOLB
WISCONSIN REGISTERED LAND SURVEYOR, S-187
DATE July 25, 1974

GLW-121 + GLW-122

316-139