


ABELL SURVEYING & MAPPING

1140 SEQUOIA STREET • DELAVAN, WISCONSIN 53115
414-728-6737

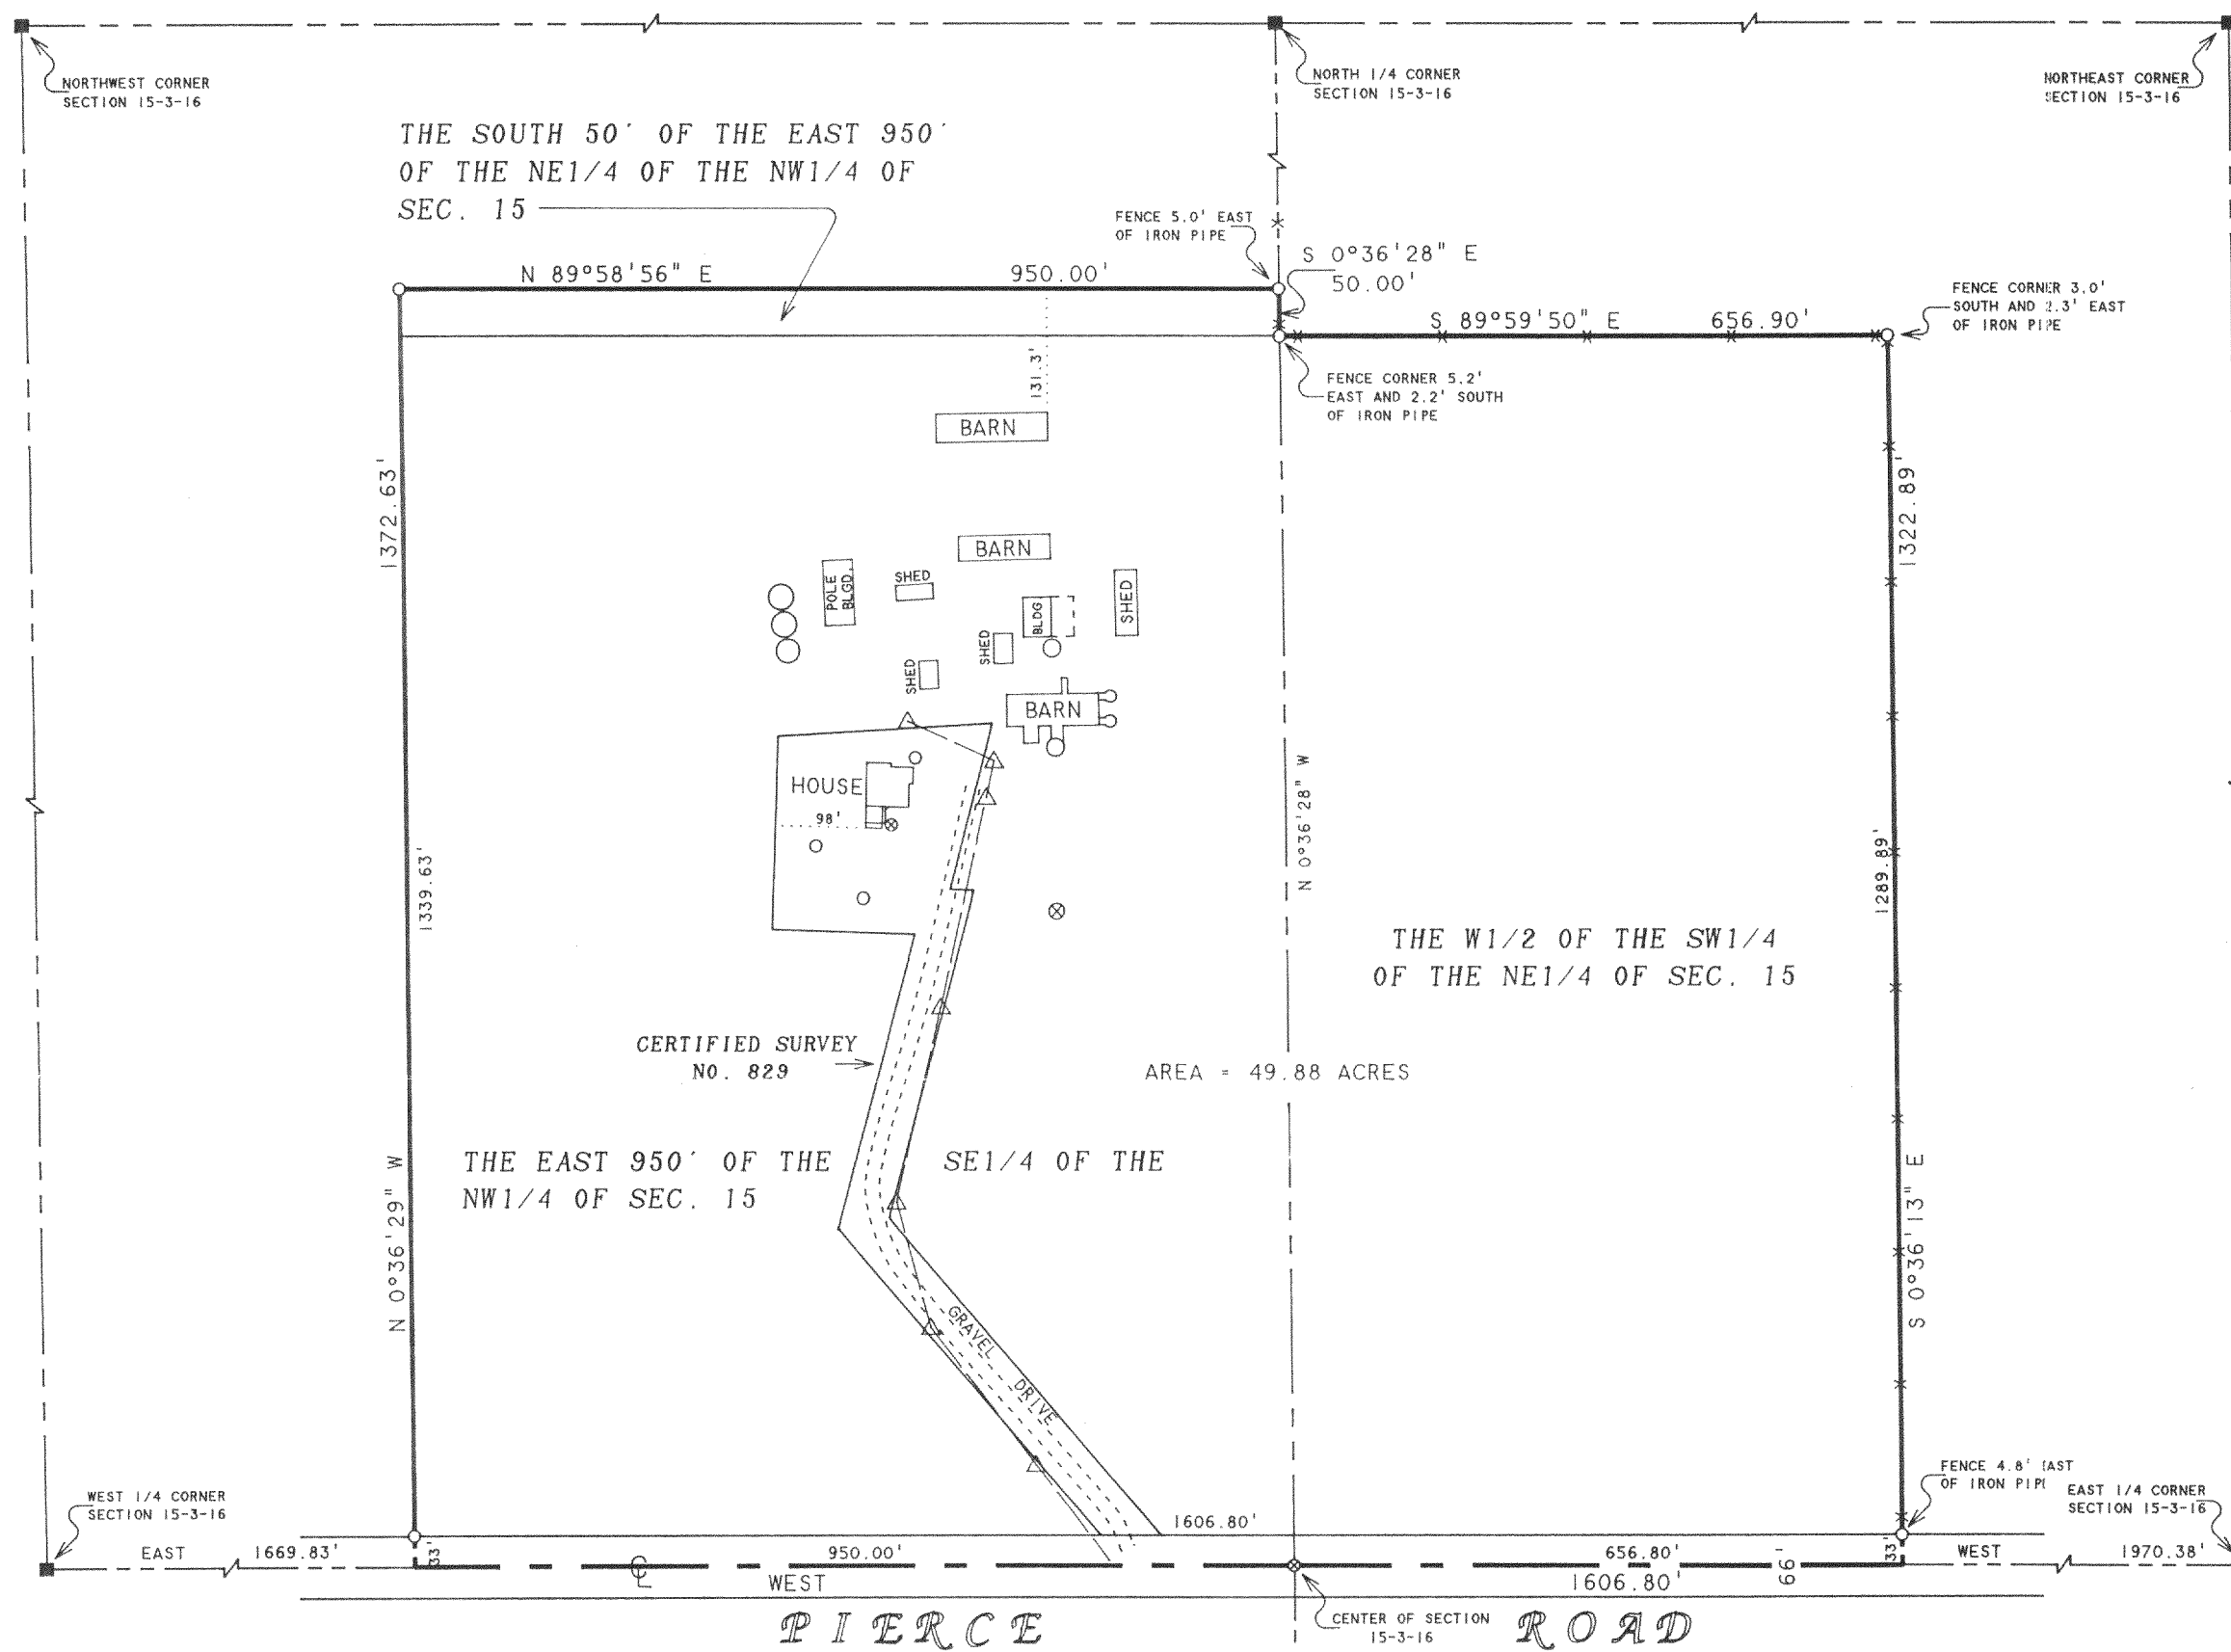

N

SCALE 1"=200'


LEGEND

- - CONCRETE MONUMENT FOUND
- - IRON PIPE SET
- ⊙ - PK NAIL SET
- △ - UTILITY POLE
- - UTILITY PED.
- ✕ - WIRE FENCE
- - OVERHEAD UTILITY LINES

PLAT OF SURVEY OF


A PARCEL OF LAND LOCATED IN THE NORTHEAST 1/4 AND IN THE NORTHWEST 1/4 OF SECTION 15, T3N,R16E, WALWORTH COUNTY, WISCONSIN AND DESCRIBED AS FOLLOWS:

THE WEST 1/2 OF THE SOUTHWEST 1/4 OF THE NORTHEAST 1/4 OF SECTION 15, THE EAST 950 FEET OF THE SOUTHEAST 1/4 OF THE NORTHWEST 1/4 OF SECTION 15 AND THE SOUTH 50 FEET OF THE EAST 950 FEET OF THE NORTHEAST 1/4 OF THE NORTHWEST 1/4 OF SECTION 15 AND ALSO INCLUDING LOT 1 OF CERTIFIED SURVEY NO. 829, ALL LOCATED IN T3N,R16E, WALWORTH COUNTY, WISCONSIN, CONTAINING 49.88 ACRES.

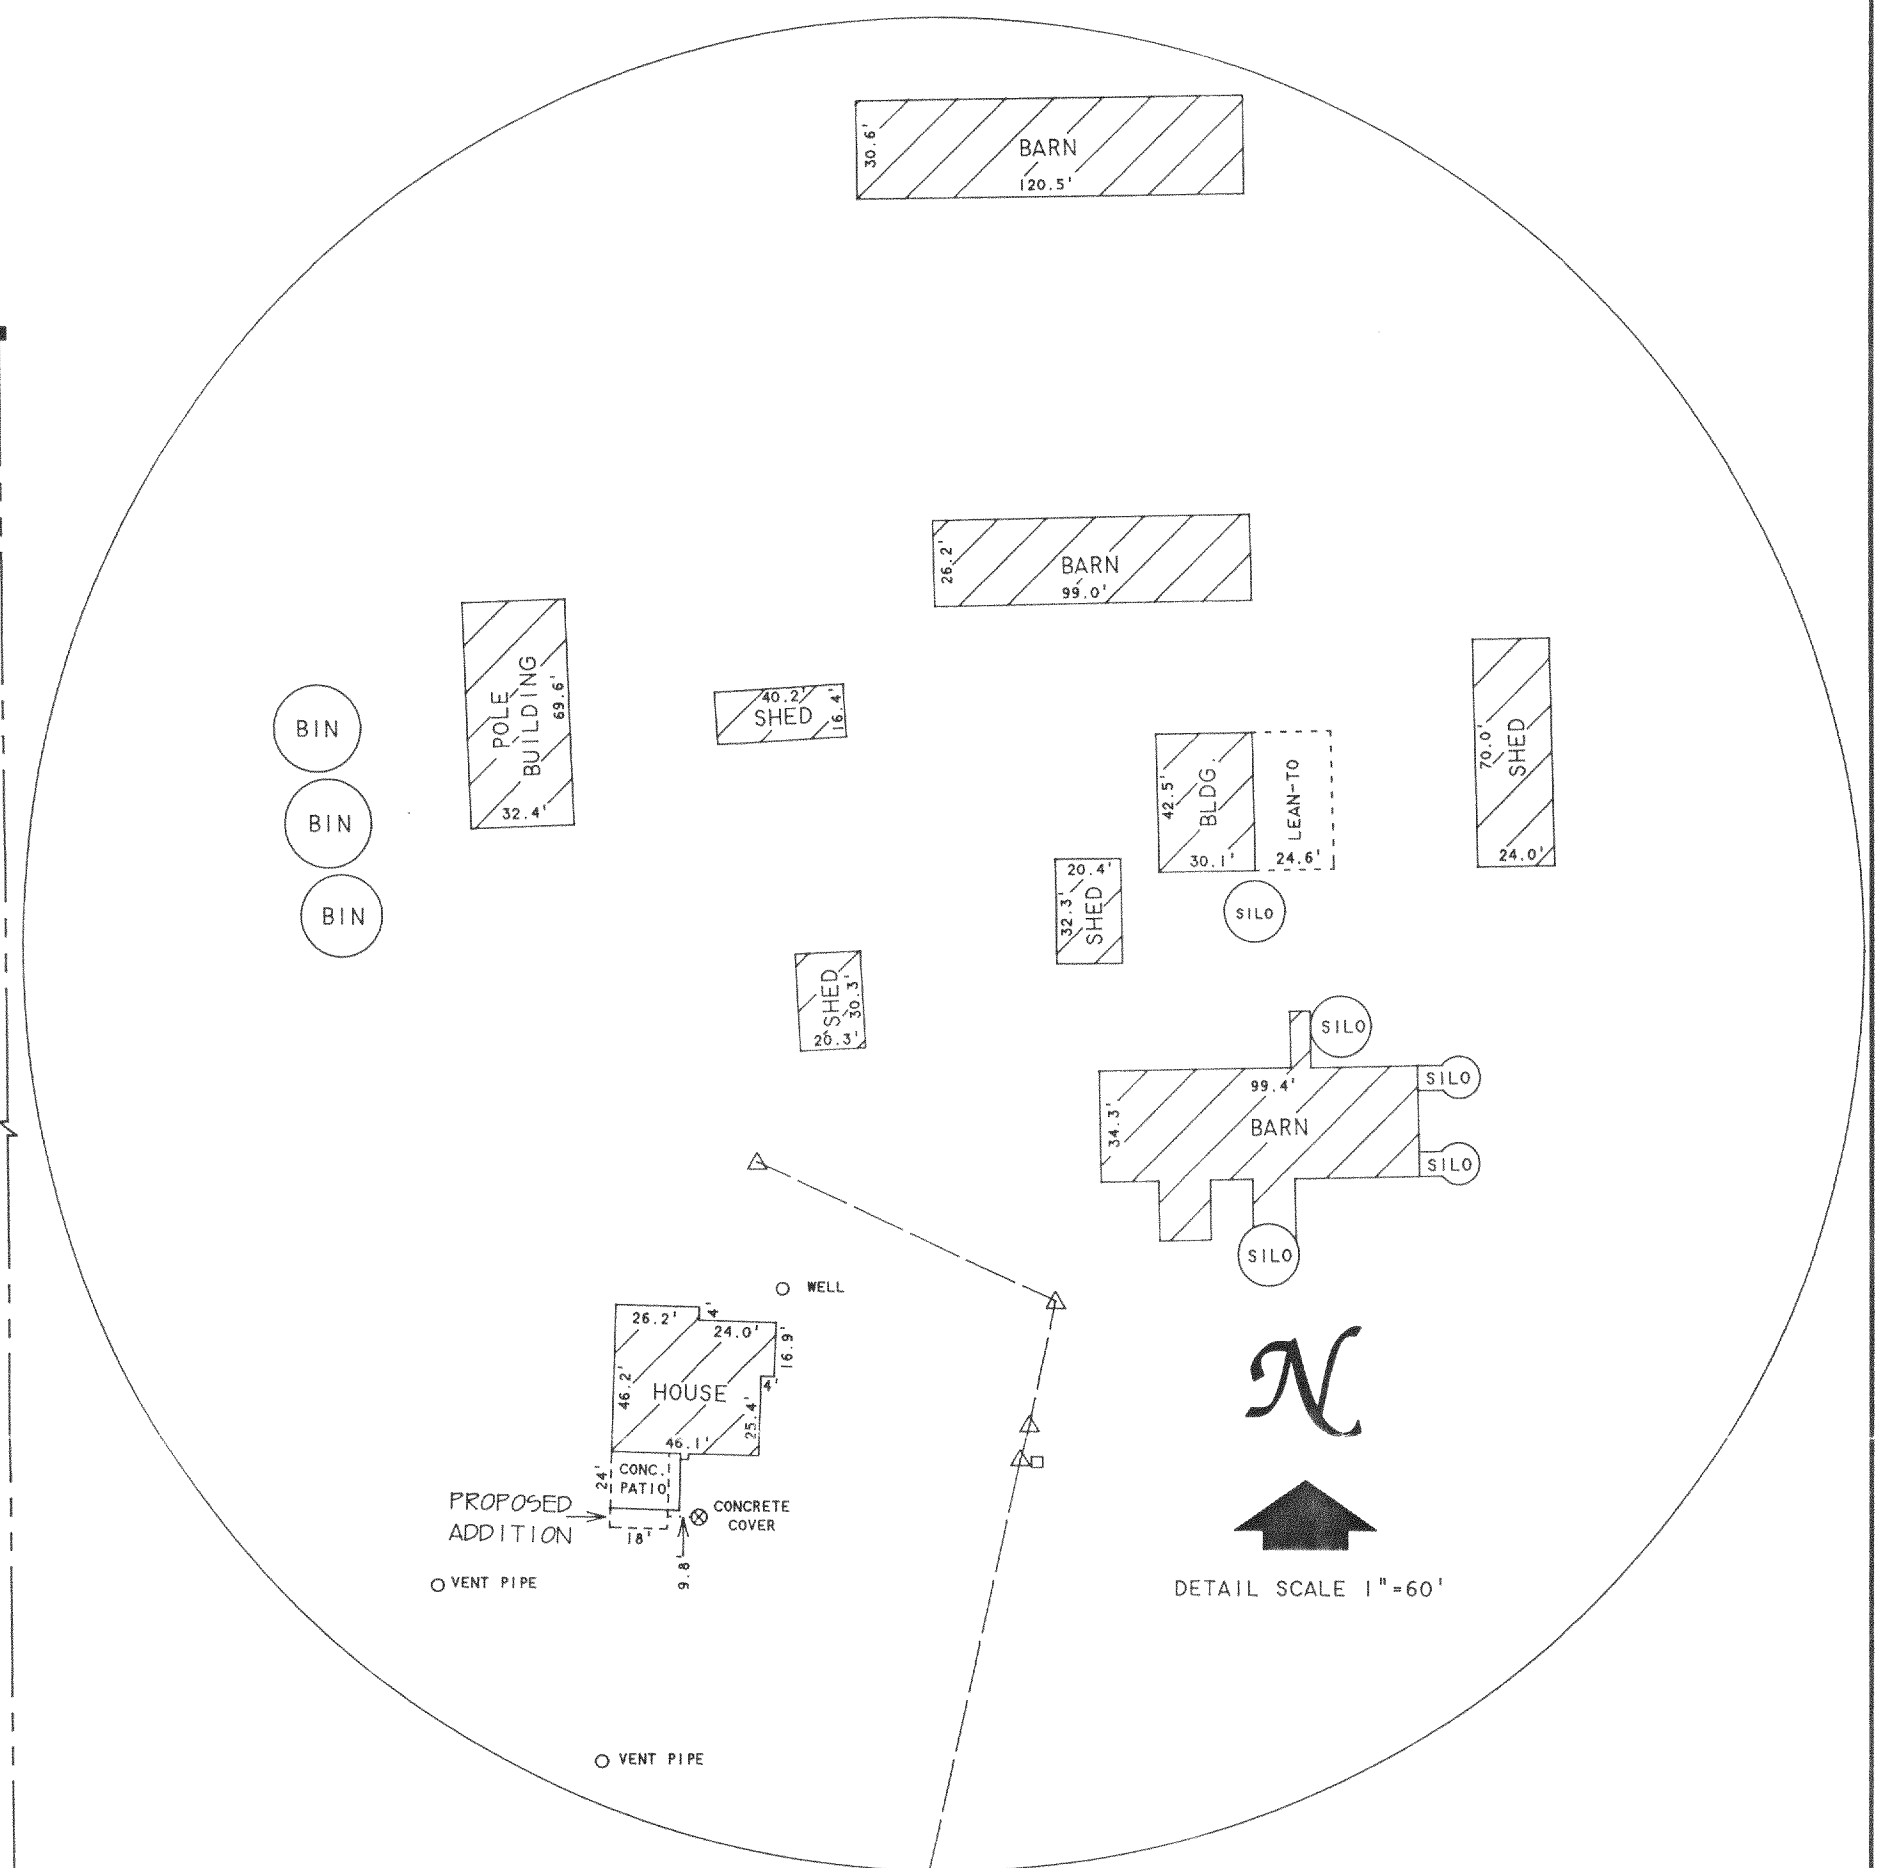

NOTE: BEARINGS ARE REFERENCED TO EXISTING SURVEY RECORDS.

ORDERED BY: SWEET & REDDY
114 N. CHURCH STREET
ELKHORN, WI 53121

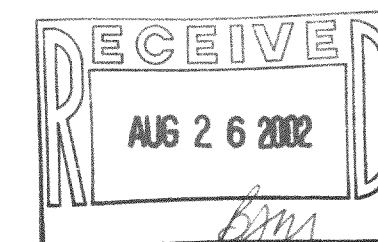

I HEREBY CERTIFY THAT I HAVE SURVEYED THE ABOVE DESCRIBED PROPERTY AND THAT THE ABOVE MAP IS A TRUE REPRESENTATION THEREOF AND SHOWS THE SIZE AND LOCATION OF THE PROPERTY, ITS EXTERIOR BOUNDARIES, THE LOCATION OF ALL VISIBLE STRUCTURES AND DIMENSIONS OF ALL PRINCIPAL BUILDINGS THEREON, BOUNDARY FENCES, APPARENT EASEMENTS, ROADWAYS AND VISIBLE ENCROACHMENTS, IF ANY, TO THE BEST OF MY KNOWLEDGE AND BELIEF.

THIS SURVEY IS MADE FOR THE USE OF THE PRESENT OWNERS OF THE PROPERTY, AND ALSO THOSE WHO PURCHASE, MORTGAGE, OR GUARANTEE THE TITLE THERETO WITHIN ONE (1) YEAR FROM DATE HEREON.

David F. Abell

DAVID F. ABELL
WISCONSIN REGISTERED LAND SURVEYOR, S-1596

REVISED DATE: MAY 8, 2002
REVISED TO SHOW PROPOSED HOUSE ADDITION
AND LOCATION OF CONCRETE COVER.

ORDERED BY: DESCHNER BUILDING CONTRACTORS
3338 N. SHORE DRIVE
DELAVAN, WI 53115

May 6, 1997

DATE: May 6, 1997
NOTE: THIS IS NOT A CERTIFIED COPY UNLESS SEALED.

JOB NUMBER - 96060A

316-1399

GA-829-1 + GSC15-4A