


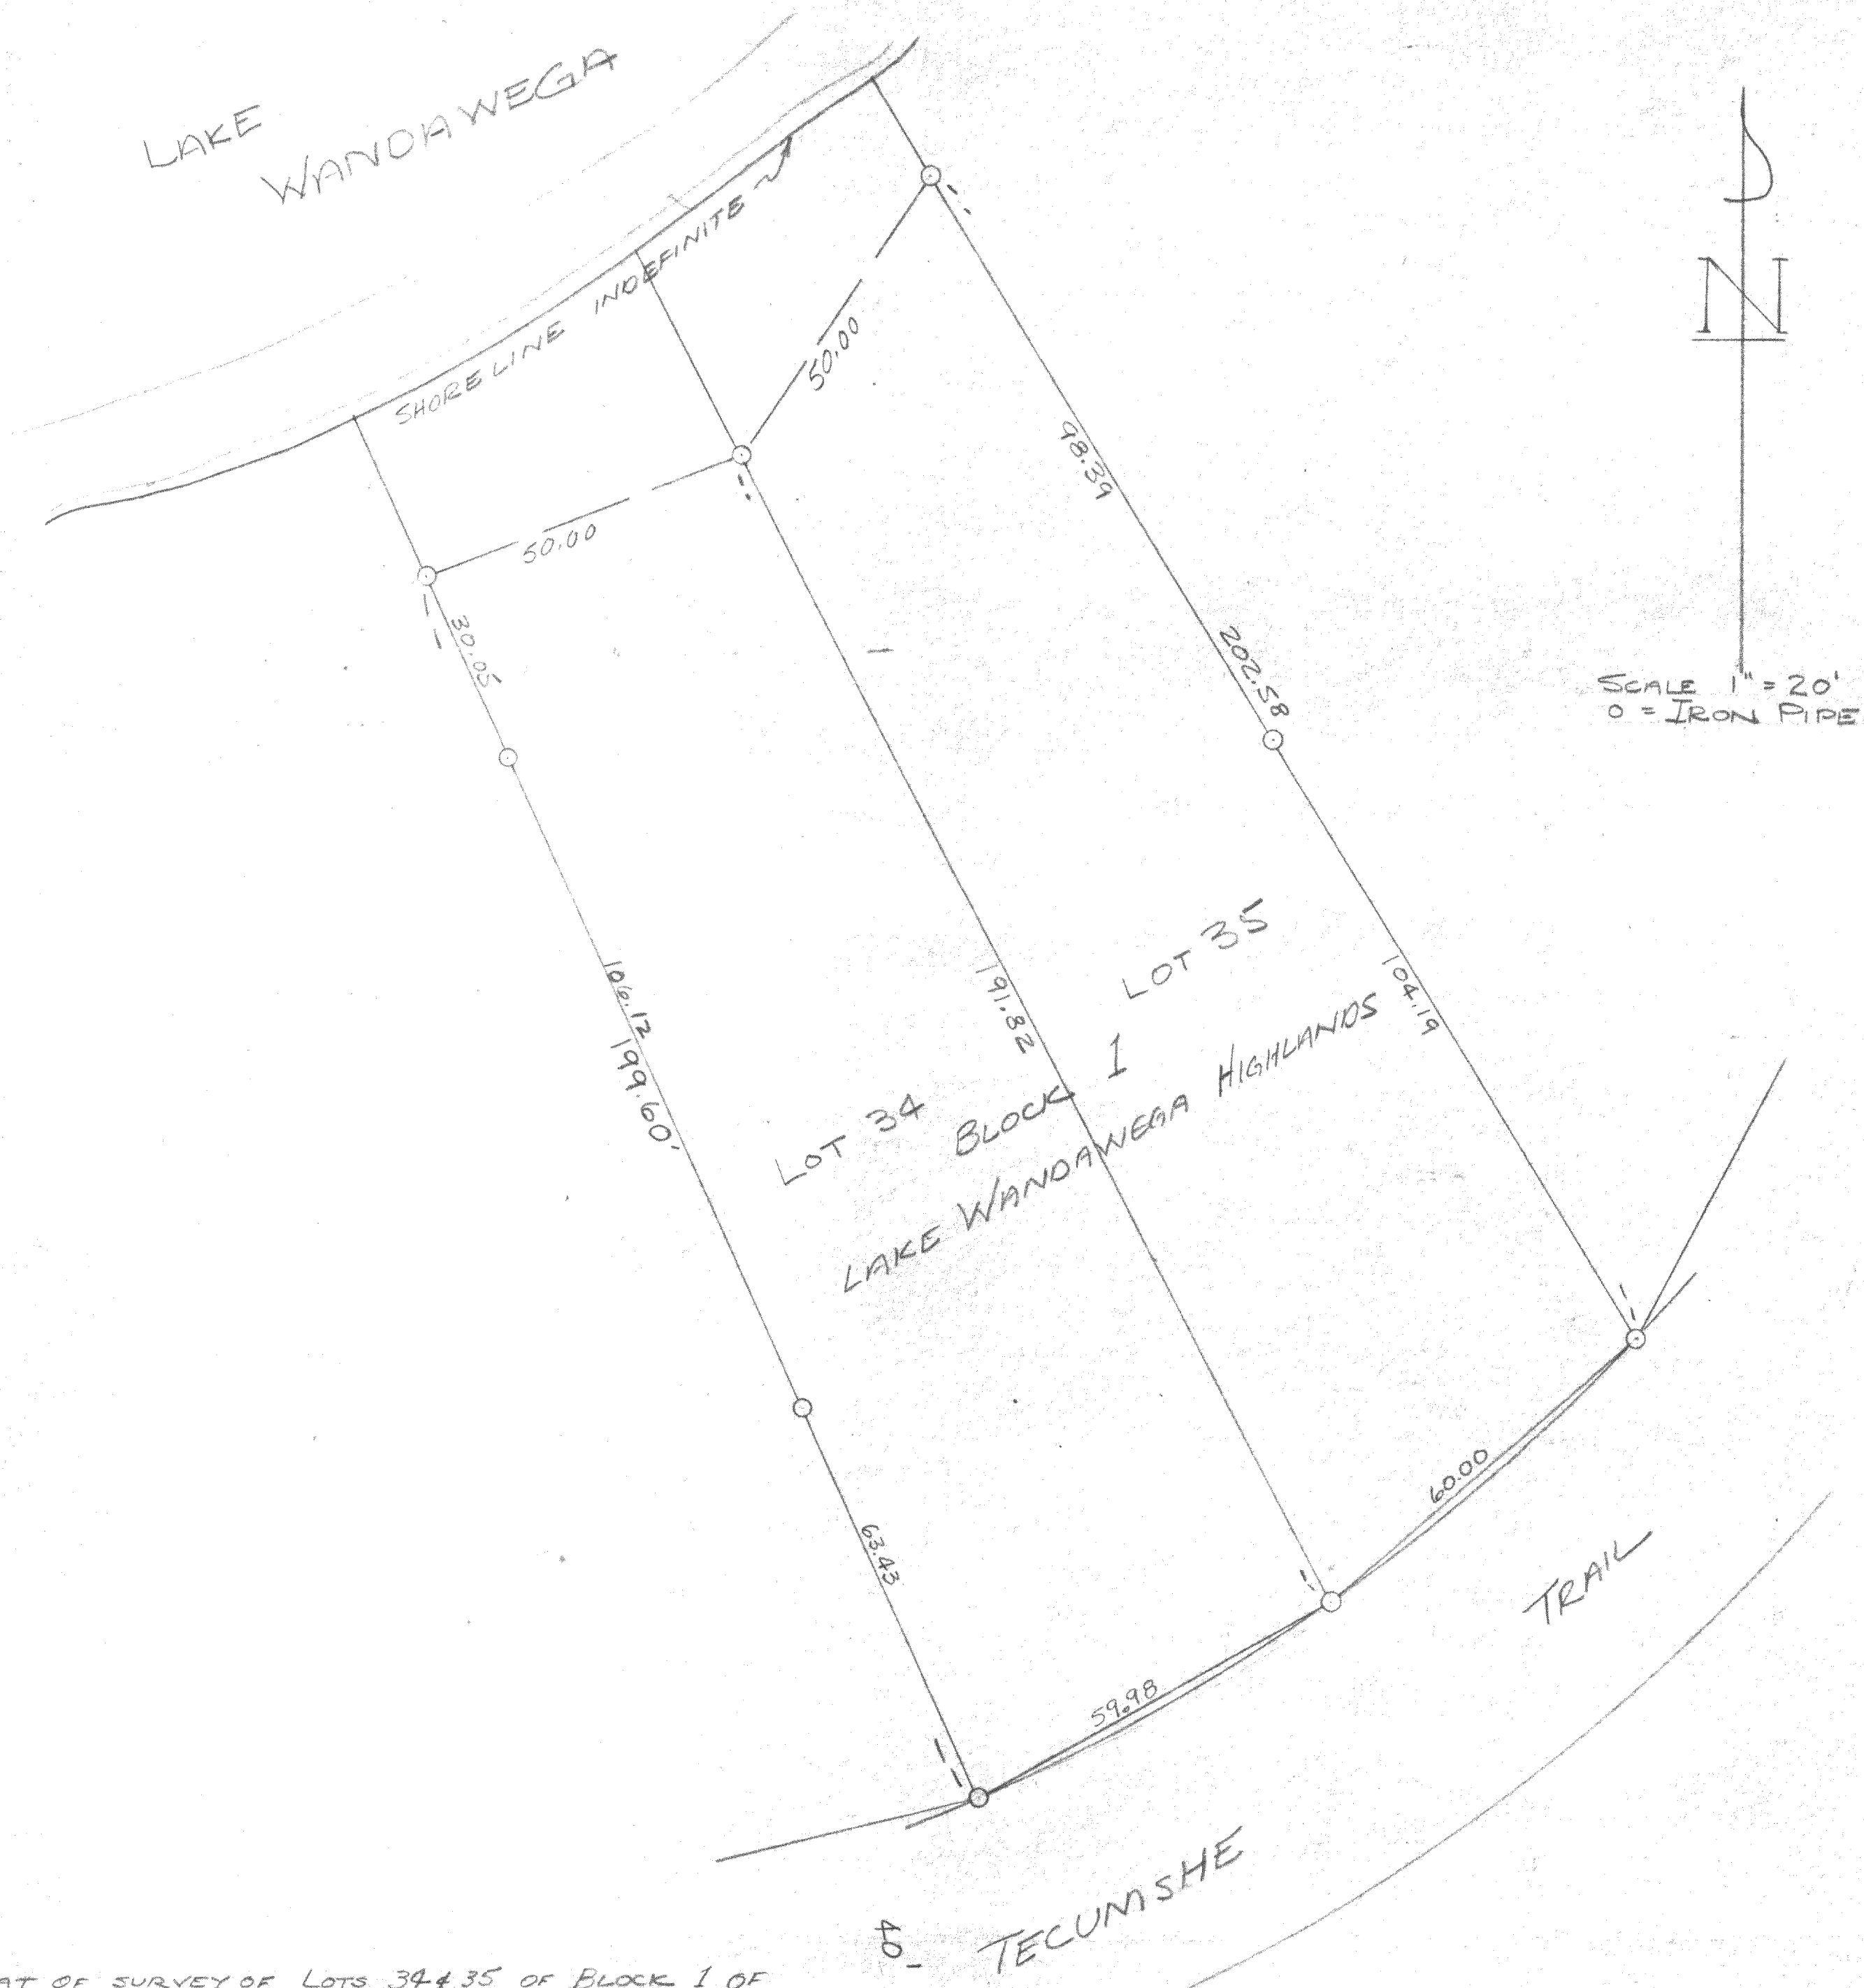

PLAT OF SURVEY OF LOTS 34 & 35 OF BLOCK 1 OF
LAKE WANDAWEGA HIGHLANDS LOCATED IN SECTIONS
11 & 12 OF T3N R16E, WALWORTH COUNTY, WIS.

MAY 1950
GWH-17

Floyd L. Jensen
COUNTY SURVEYOR

8- TECUMSHE

GWH-17

316-14.1