



PLAT OF SURVEY

LOT 14, POPLAR RIDGE SUBDIVISION, A REDIVISION OF LOTS 45-47 BLOCK 68 AND LOTS 25 AND 26 BLOCK 74 LAKE WANDAWEGA SUBDIVISION, BEING A PART OF GOVERNMENT LOT 1 OF SECTION 1 AND PART OF GOVERNMENT LOT 1 SECTION 2, ALL IN TOWN 3 NORTH RANGE 16 EAST OF THE FOURTH PRINCIPAL MERIDIAN, TOWN OF SUGAR CREEK, CALWORTH COUNTY, WISCONSIN.


SURVEYED FOR: BIELINSKI BROS. BUILDERS/JOHN AND JESS FUGATE WISNEWSKI

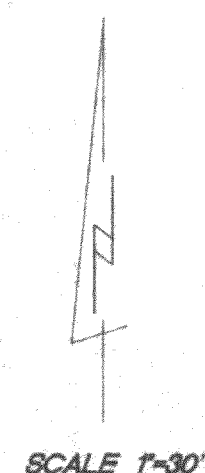

- SET 1" IRON PIPE
- FOUND 3/4" REBAR

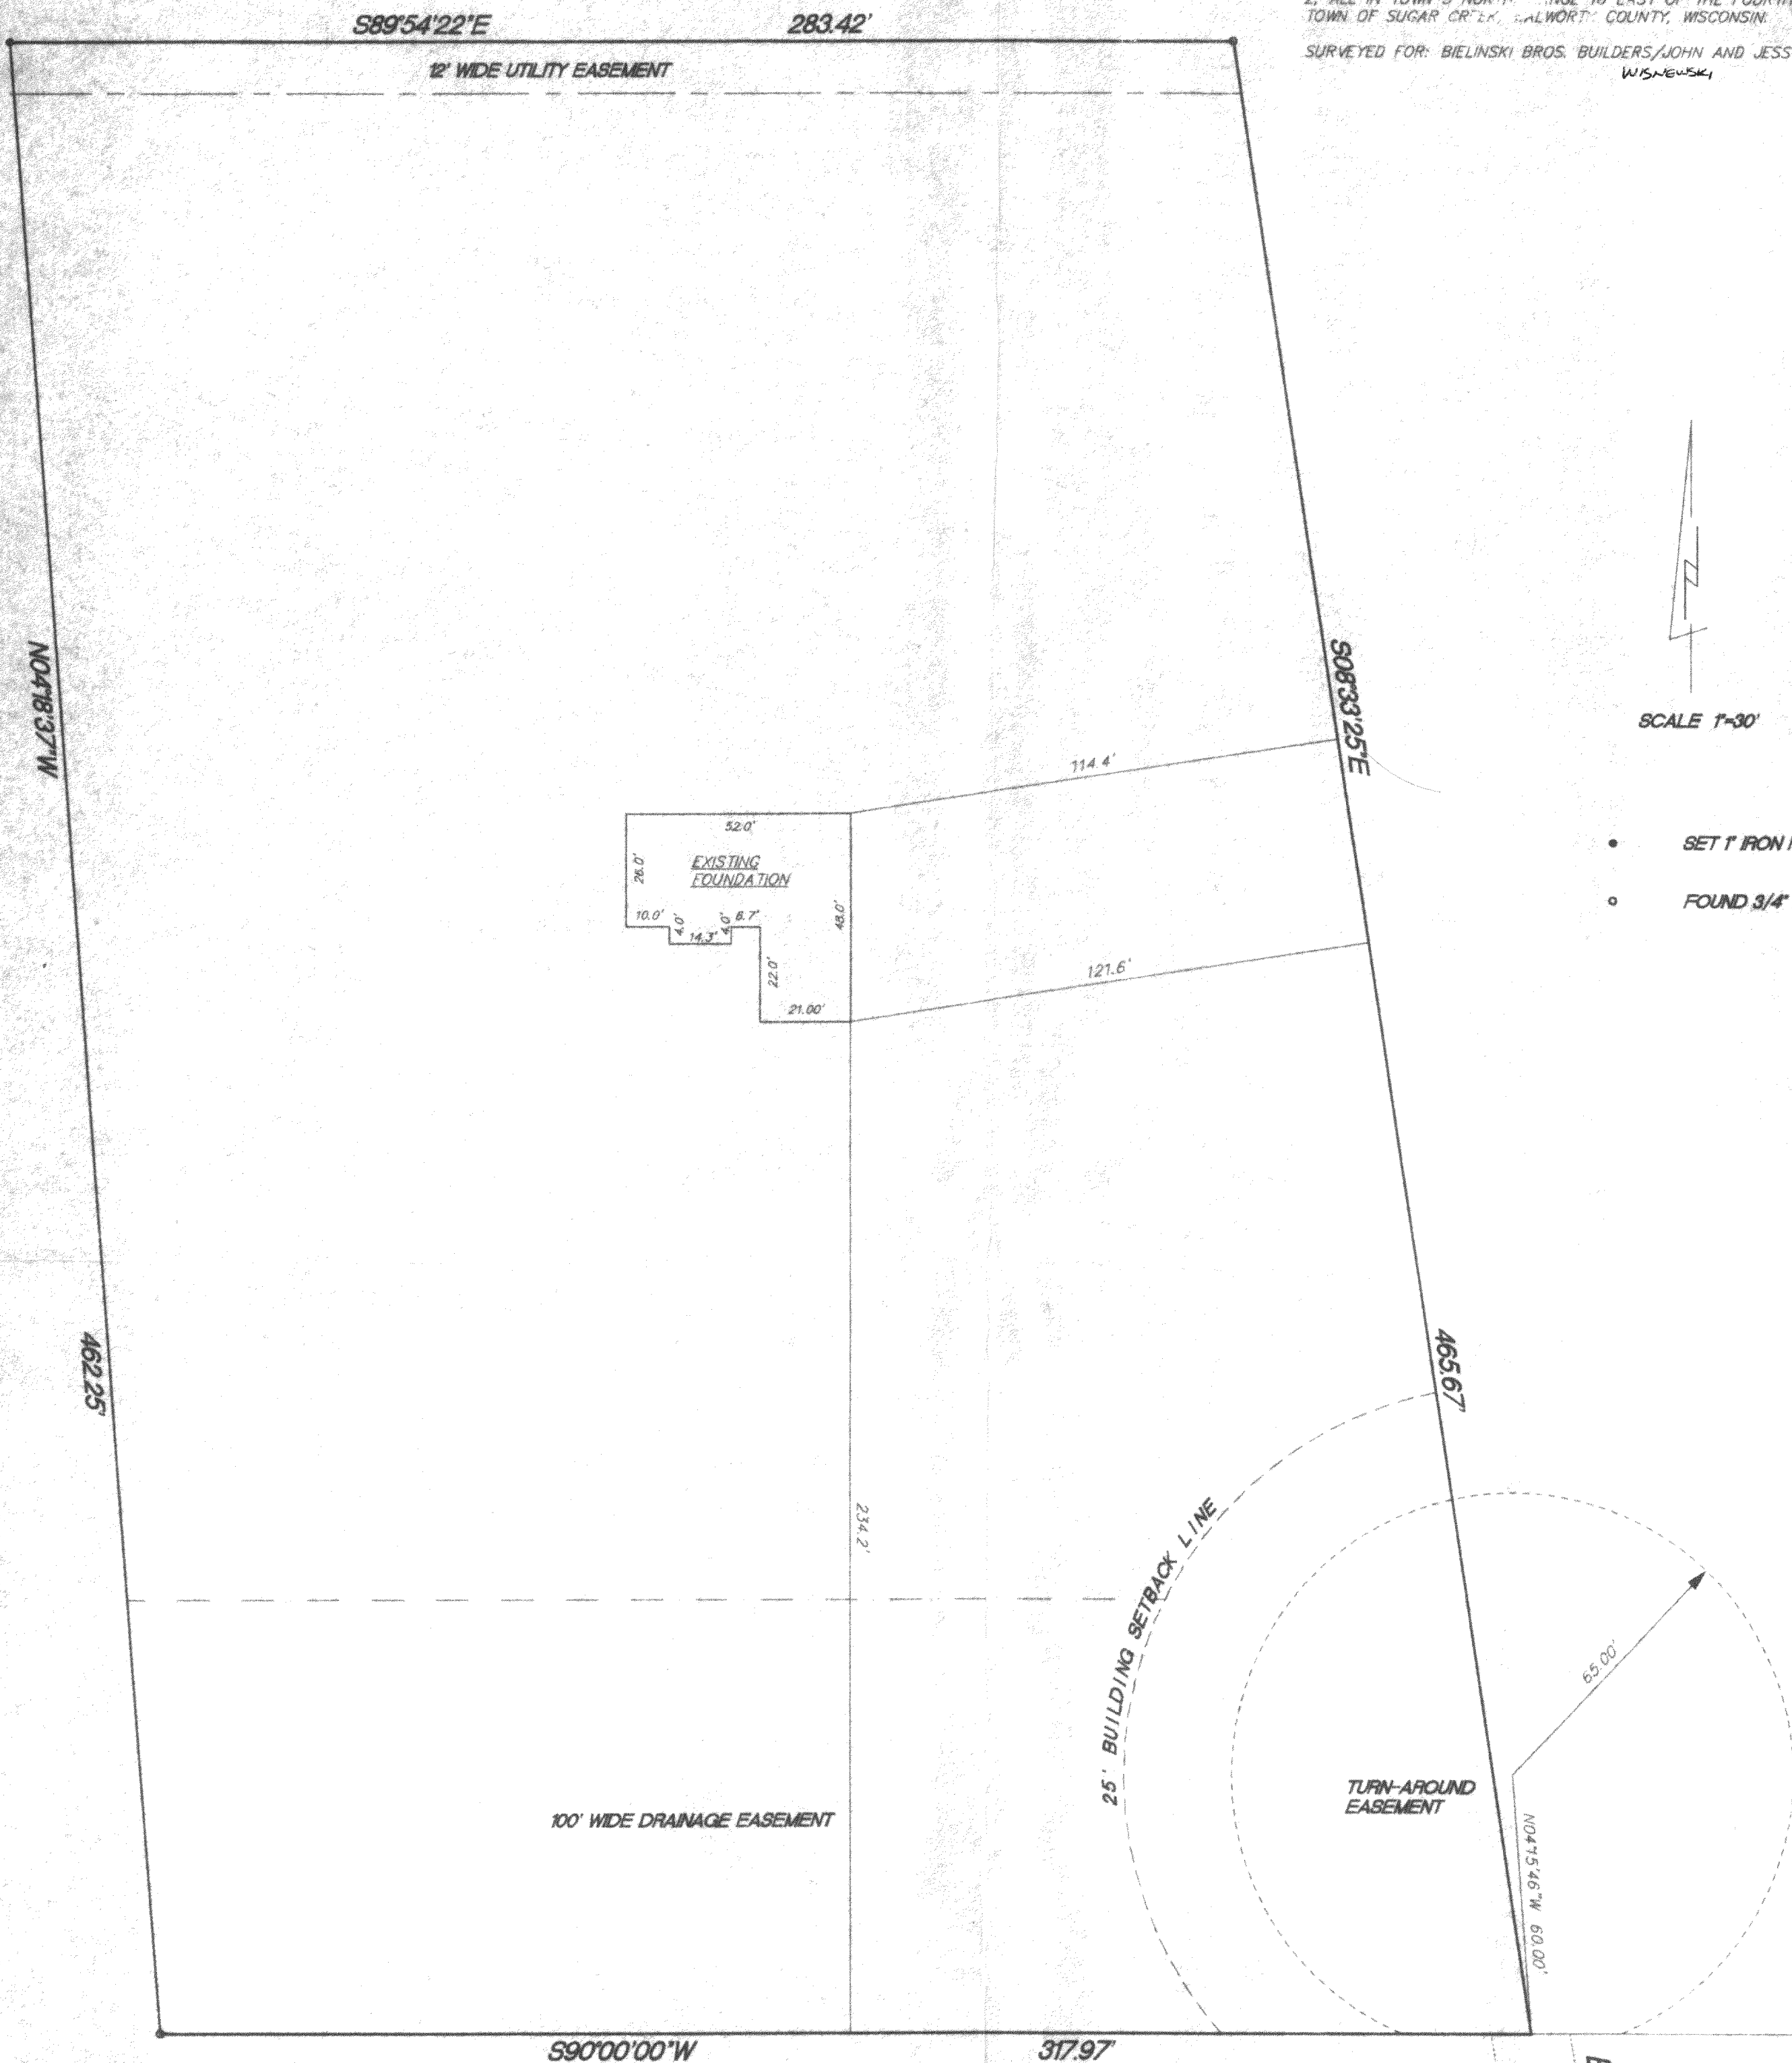

MONUMENTATION WAS WAIVED BY CLIENT IN ACORDANCE WITH A-E7.01(2) OF THE WISCONSIN ADMINISTRATIVE CODE.

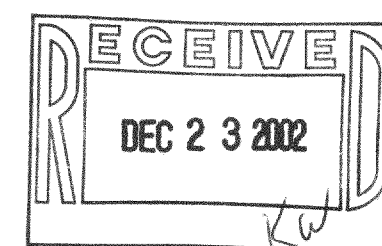

I hereby certify that I have surveyed the above property and that the above map is a true representation thereof and shows the size and location of the property exterior boundaries, the location of all visible structures and dimensions of all principal buildings thereon, boundary fences, apparent easements, roadways and encroachments if any. This survey is made for the use of the present owners of the property, and also those who purchase, mortgage or guarantee the title thereto within one year from date hereof.			
REV. 12/5/02 10/28/02 DATE		TEP/DW FIELD WORK BY	
TEP DRAWN BY		02167 JOB NUMBER	

Kettle Moraine Surveying Inc.
P.O. Box 357
Eagle WI. 53119
(262)594-3484

THIS IS NOT AN ORIGINAL SURVEY UNLESS THE SEAL IS HERE.

✓ GPR-14

316-1449