
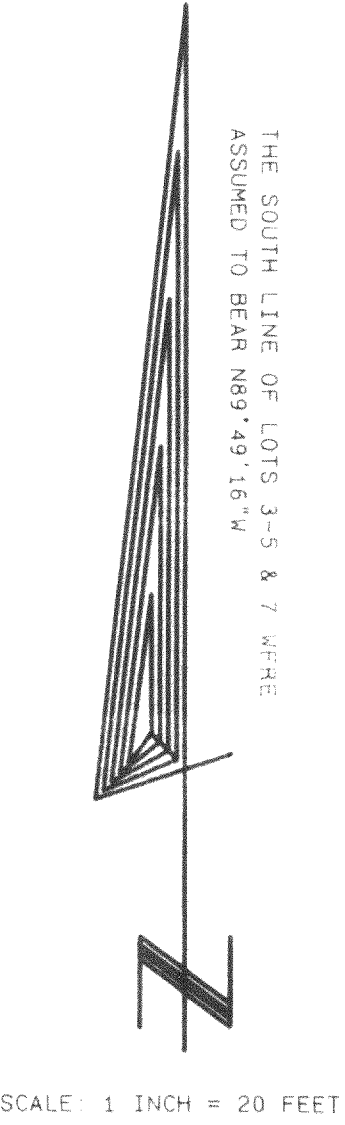



PLAT OF SURVEY

A PLAT OF LOTS 4-12, BLOCK 38, THIRD MAP
OF INTERLAKEN, TOWN 3 NORTH, RANGE 16
EAST, SUGAR CREEK TOWNSHIP, WALWORTH
COUNTY, WISCONSIN.

OWNERS: DAVID C. ROBERS
NORMA J. ROBERS
N6738 WALNUT ROAD
ELKHORN, WI. 53121

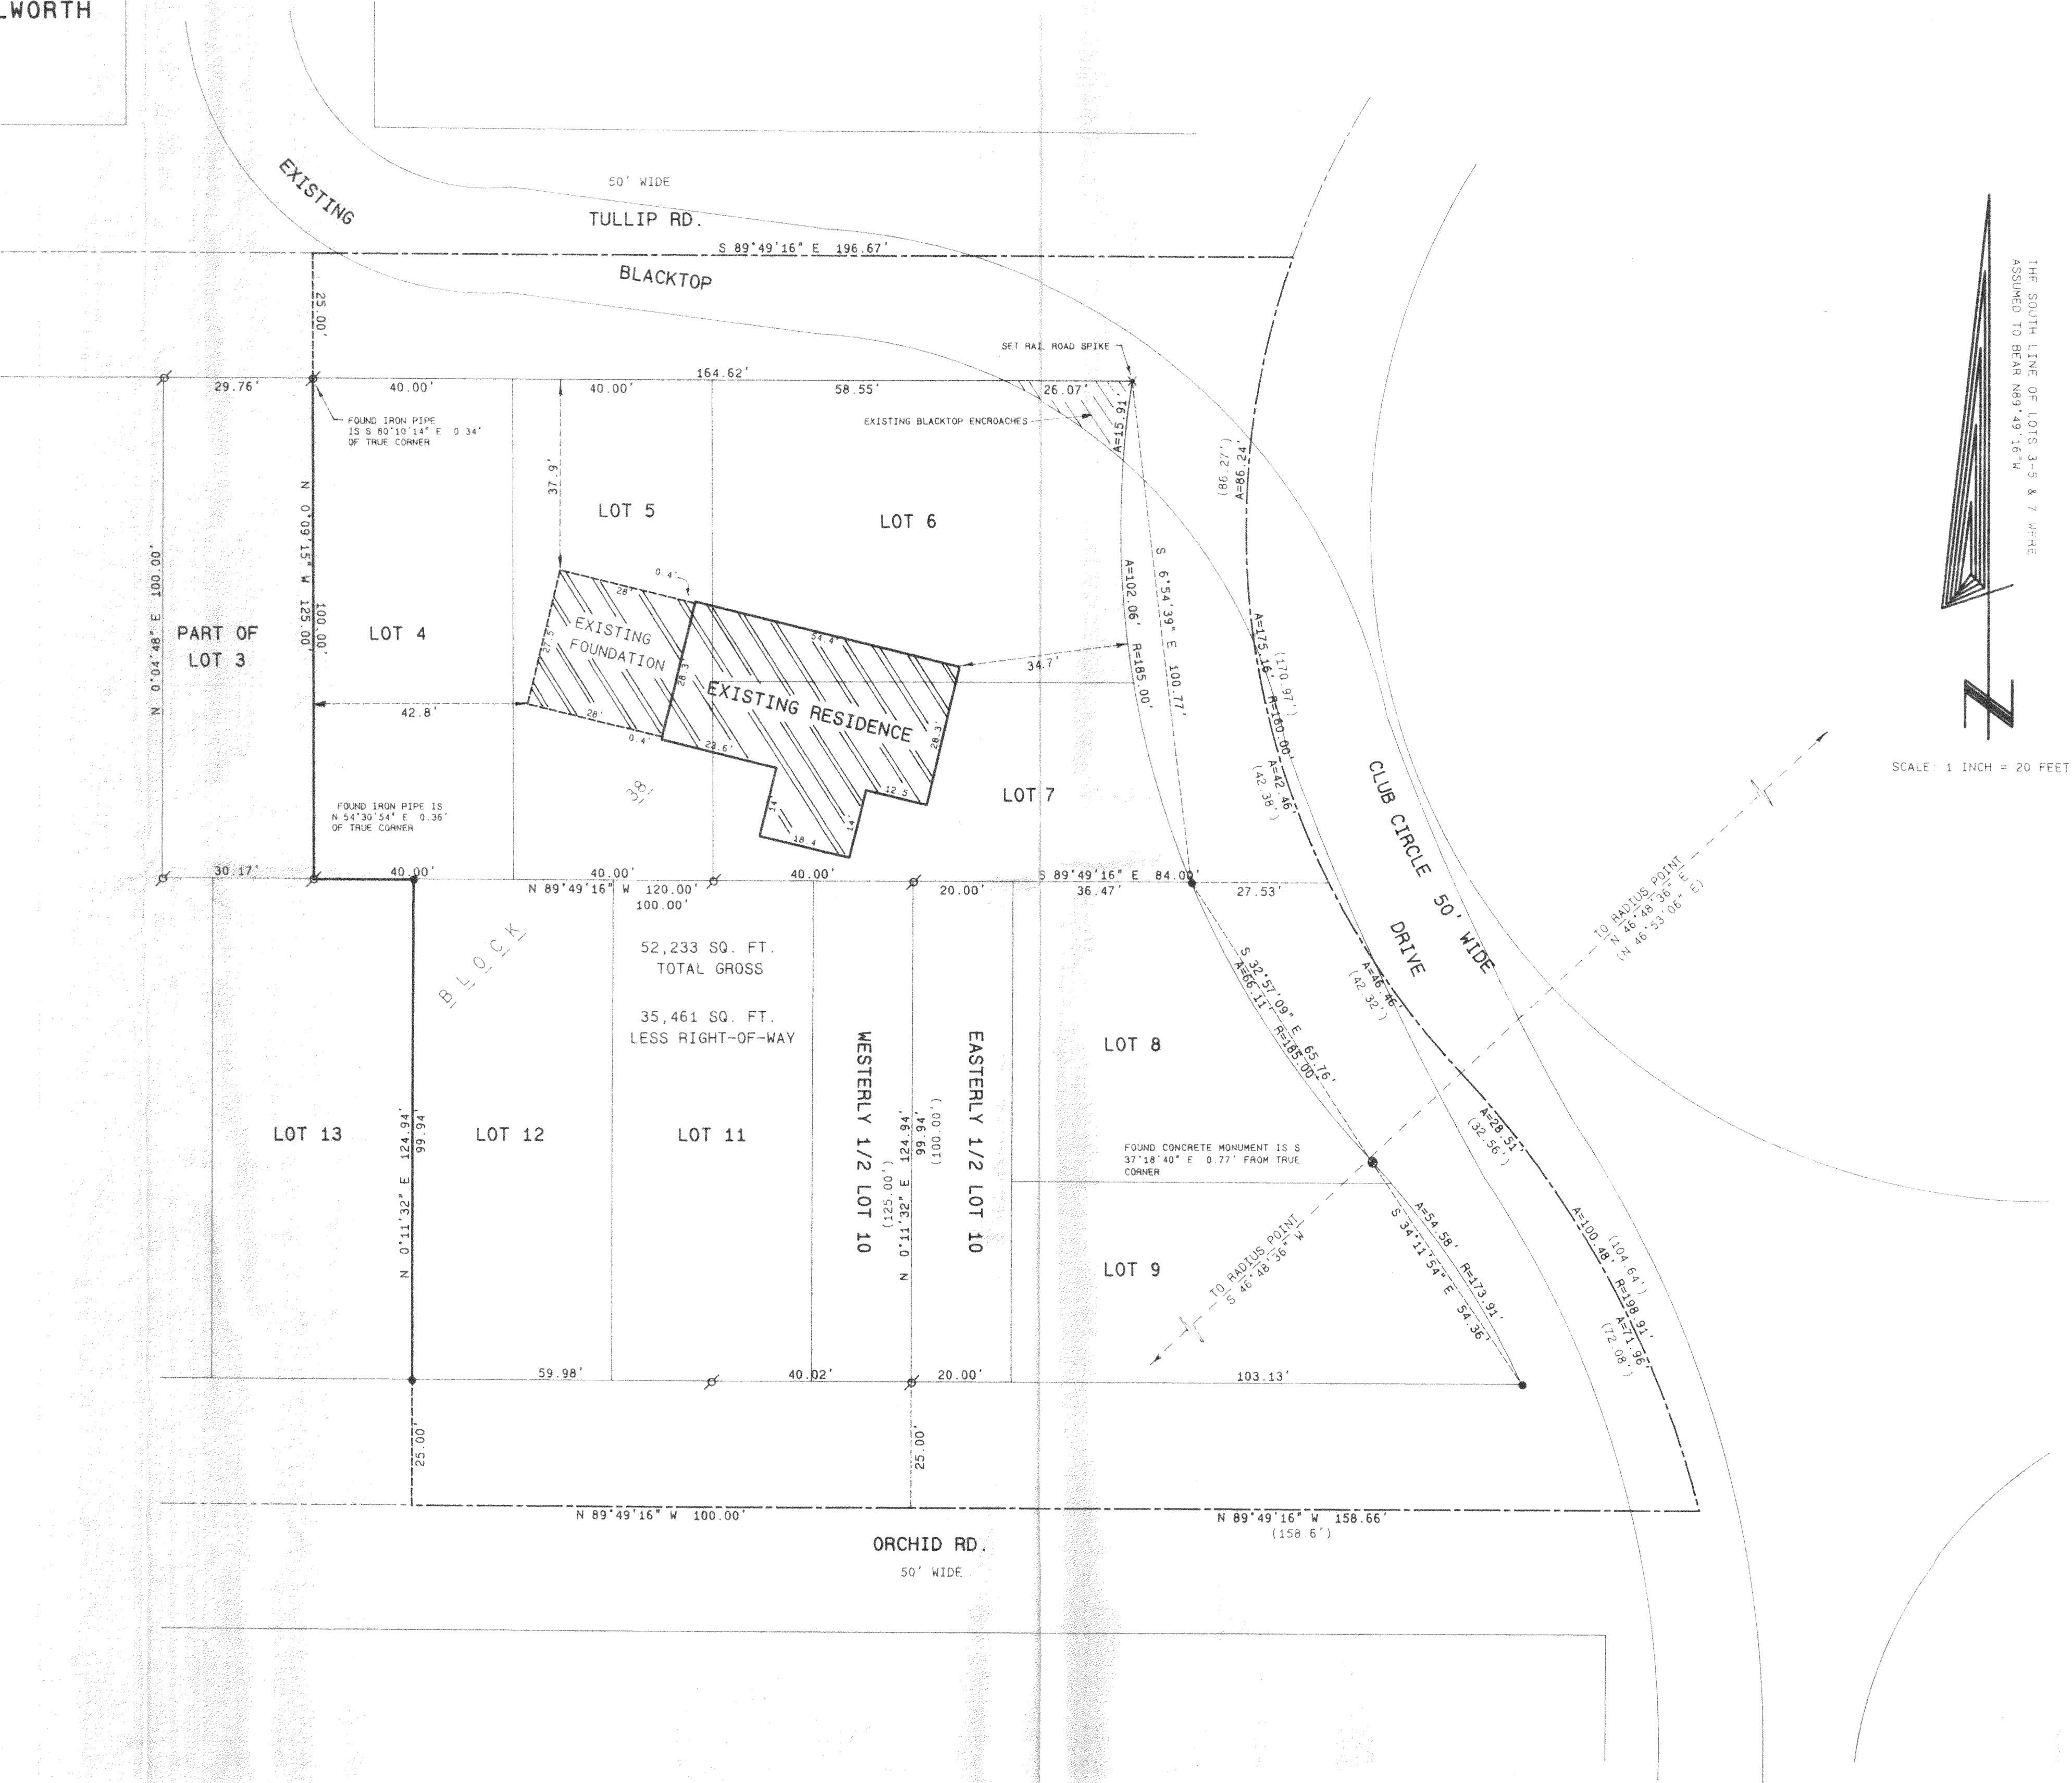

- Legend
- FOUND IRON PIPE
 - FOUND IRON ROD
 - FOUND BRASS CAPPED MONUMENT
 - FOUND CONCRETE MONUMENT
 - CHISEL CUT IN CONCRETE
 - SET IRON ROD, 24" LONG, WEIGHING 1.5 LBS. LINEAL FT., 3/4" DIA.
 - SET IRON ROD, 30" LONG, WEIGHING 4.5 LBS. LINEAL FT., 1-11/16" DIA.
 - RECORDED AS DIMENSION
 - EXISTING FENCE

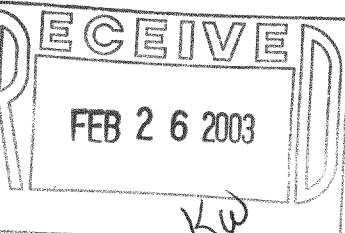

SCALE: 1" = 20 FEET

REVISED APRIL 5, 1999

REVISED DEC. 13, 2002 TO SHOW EXISTING RESIDENCE

I hereby certify that the above described property has been surveyed by me or under my direction and that the above map is a true representation thereof and shows the size and location of the property, its exterior boundaries, the location of all visible structures and dimensions of all principal buildings thereon, boundary fences, apparent encroachments, roadways and visible encroachments, if any. This survey is made for the use of the present owners of the property, and also those who purchase, mortgage, or guarantee the title thereto within one year from date hereof.

Kenneth B. Abernathy, Jr.
KENNETH B. ABERNATHY, JR.
WISCONSIN REGISTERED LAND SURVEYOR,
S-1594
Date: 2/16/98 Job No. 97.1011