


Plat of Survey




of

Lot 6 of Block 11 of Cool Hill Park Addition No. 2,
a subdivision located in the Northeast 1/4 of Section 3, Town 3
North, Range 16 East, Town of Sugar Creek, Walworth County,
Wisconsin.

Surveyed for: Keefe Real Estate, Inc.
751 Geneva Parkway
P.O. Box 460
Lake Geneva, Wisconsin. 53147

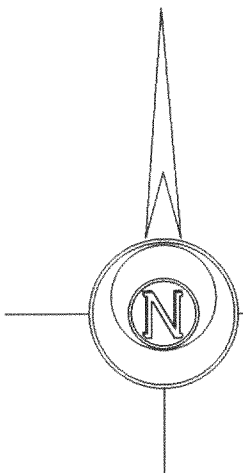

Bearings reference to the plat of
Cool Hill Park Addition No. 2.

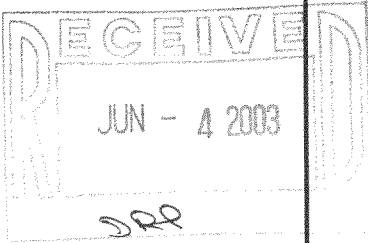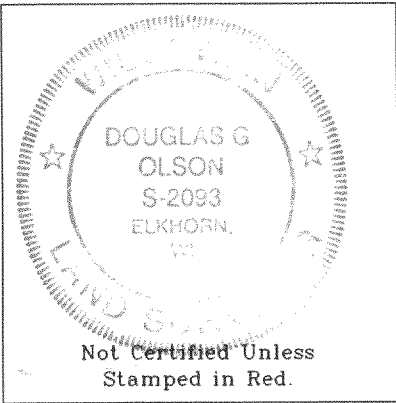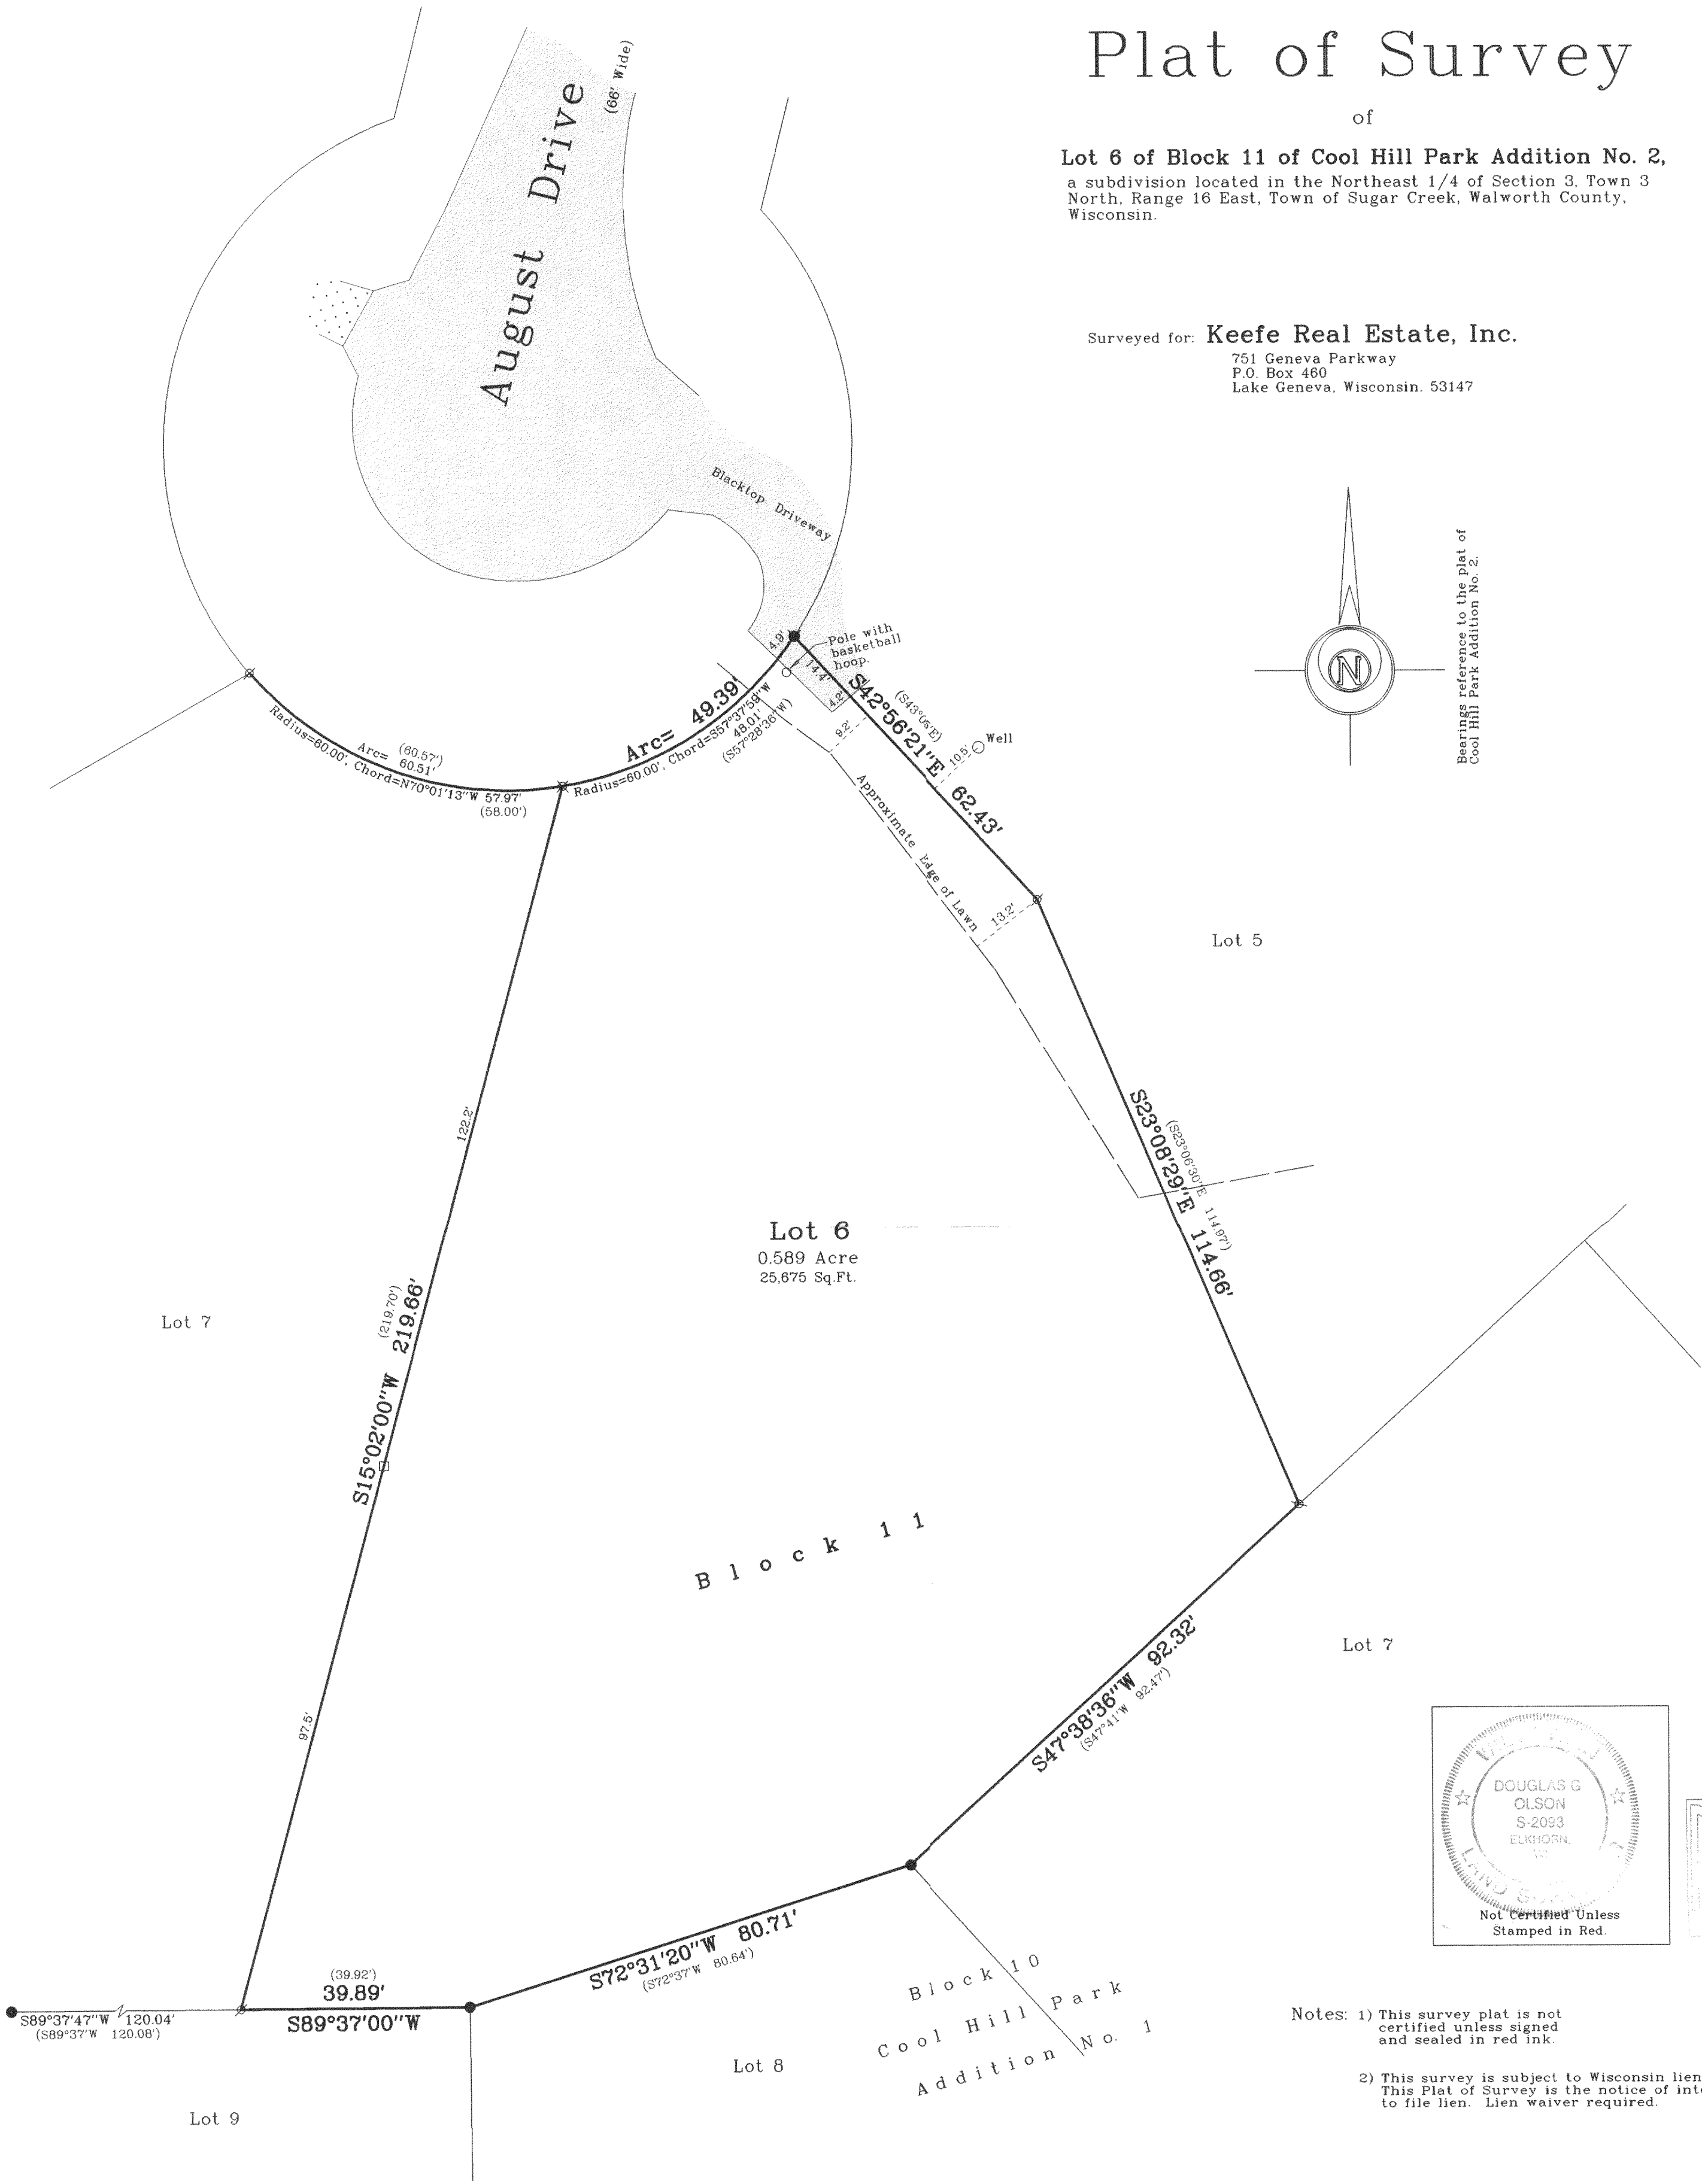


Notes: 1) This survey plat is not
certified unless signed
and sealed in red ink.
2) This survey is subject to Wisconsin lien laws.
This Plat of Survey is the notice of intent
to file lien. Lien waiver required.

I hereby certify that I have surveyed the above described
property and the map hereon is correct to the best of my professional
knowledge and belief and shows the size and location of the property,
its exterior boundaries, the location and dimensions of all visible
structures thereon, boundary fences, apparent easements and roadways
and visible encroachments, if any.
This survey is made for the exclusive use of the present owners
of property, and also those who purchase, mortgage or guarantee title
thereto, within one year from the date hereof.

Douglas G. Olson
Wisconsin Registered Land Surveyor - 2093

Copyright c 2003 by Jensen & Olson Land Surveying, LLC.
All rights reserved. No part of this survey plat may be reproduced
or transmitted in any form by any means - graphic, electronic, or
mechanical, including photocopying, tracing, or information storage
and retrieval systems - without permission in writing from Douglas
G. Olson, Jensen & Olson Land Surveying, LLC.

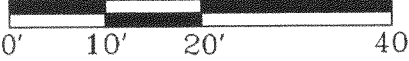2003.008	Sheet 1 of 1 Sheets	Legend ⊗ Found Iron Pipe ● Found Iron Rod () Recorded Information --- Concrete Surface --- Asphalt Surface ■ Set P.K. Nail	 Jensen & Olson Land Surveying, LLC 45 South Wisconsin Street P.O. Box 322 Elkhorn, Wisconsin. 53121 Telephone (262) 723-3434 Facsimile (262) 723-8044	Scale in Feet 1" = 20' 	Survey Date: February 6, 2003. Revisions:
	Job Reference Number 2003.008				