

BOUNDARY & TOPOGRAPHIC SURVEY

LOT 1 OF CERTIFIED SURVEY MAP NO. 119,
ACCORDING TO THE PLAT THEREOF RECORDED
IN VOL. 1 OF CERTIFIED SURVEYS ON PAGE
119 AS DOCUMENT NO. 645264, TOWN OF
SUGAR CREEK, WALWORTH COUNTY, WISCONSIN

AND ALSO A PARCEL OF LAND RECORDED AS A LOT LINE ADJUSTMENT
INTO LOT 1 OF CERTIFIED SURVEY MAP 119, DESCRIBED IN DEED
REC. IN VOL. 643, ON PAGE NO. 6743, AS DOCUMENT NO. 340835.

BOUNDARY
&
TOPOGRAPHIC SURVEY
SARINA'S OF ELKHORN

WORK ORDERED BY:
SARINA'S, INC.
W 5140 HWY A
ELKHORN, WISCONSIN 53121


FARRIS, HANSEN & ASSOCIATES, INC.
Engineering, Architecture, Surveying
7 Ridgeway Court P.O. Box 437
ELKHORN, WISCONSIN 53121
Office: (414) 723-2978
Fax: (414) 723-5886

REVISIONS
05/23/2003
TO SHOW ADD.
IMPROVEMENTS

PROJECT NO.
4272
DATE
04/07/95
SHEET NO.
1 OF 1

ASSIGNED SW LINE LOT 1
N 30° 20' W
PER RECORD PLAT


10 5 0 10 20 30 40 50 60 70 80 90 100
MAP SCALE IN FEET ORIGINAL 1" = 20'

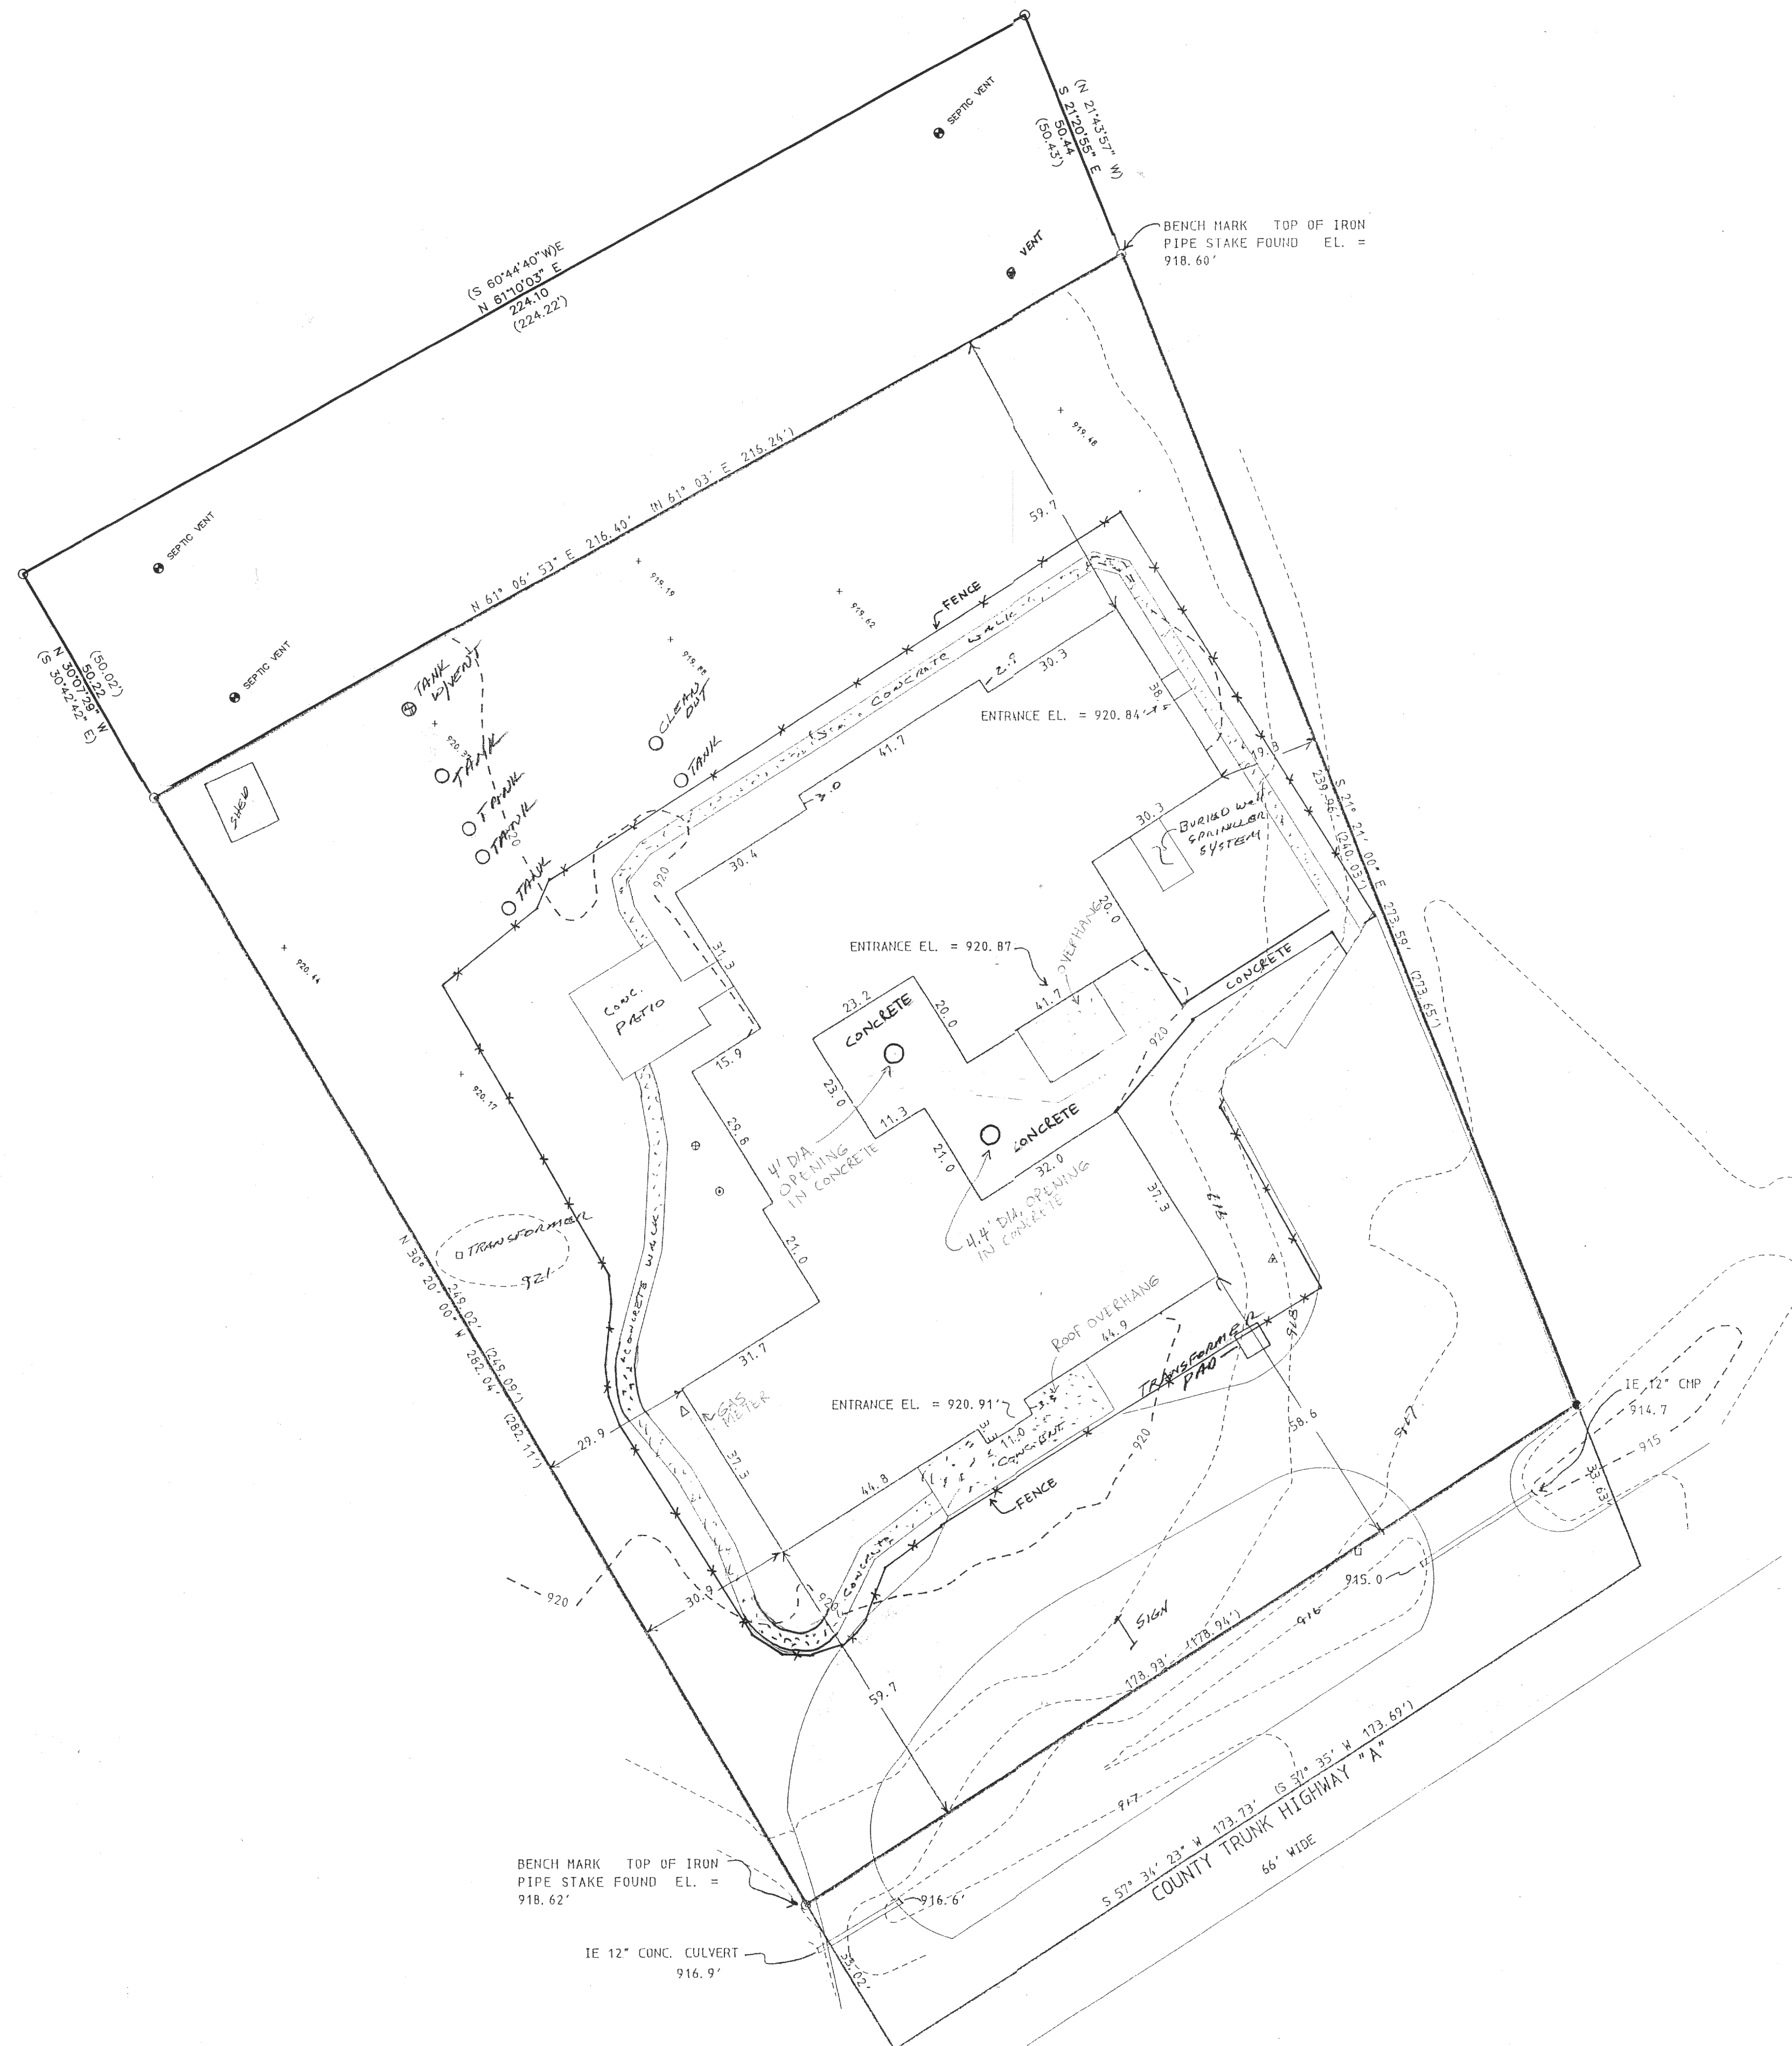

- LEGEND
- = SET IRON REBAR STAKE
 - = FOUND IRON PIPE STAKE
 - = FOUND IRON REBAR STAKE
 - (---) = REFORCED AS
 - ⊕ = VENT PIPE
 - = UTILITY BOX
 - ⊙ = CONCRETE SEPTIC LIU
 - ▽ = WELL

VERTICAL DATUM: U.S.G.S. 1929 AD1.

NOTE: CONTAINS FROM 1995
NOT VERIFIED 2003

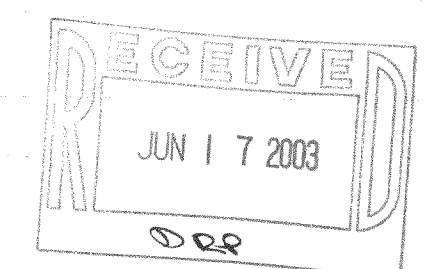

NOTE: COPIES OF THIS MAP TO WHICH THE FOLLOWING CERTIFICATE
WILL APPLY SHOW SURVEYOR'S ORIGINAL SEAL AND SIGNATURE IN
RED INK. COPIES BY ANY OTHER MEANS MAY HAVE ALTERATIONS
WHICH DO NOT REPRESENT THE SURVEYOR'S WORK PRODUCT.

I HEREBY CERTIFY THAT THE ABOVE DESCRIBED PROPERTY HAS BEEN
SURVEYED UNDER MY DIRECTION AND THAT THE ABOVE MAP IS A TRUE
REPRESENTATION THEREOF AND SHOWS THE SIZE AND LOCATION OF
THE PROPERTY AND ITS EXTERIOR BOUNDARIES. THIS SURVEY IS
MADE FOR THE USE OF THE PRESENT OWNERS OF THE PROPERTY, AND
ALSO THOSE WHO PURCHASE, MORTGAGE, OR GUARANTEE THE TITLE
THERE TO WITHIN ONE YEAR FROM THE DATE HEREOF.

DATED: MARCH 1, 2002

PETER S. GORDON R.L.S. 2101

5/27/2003
P. SURVEY

