
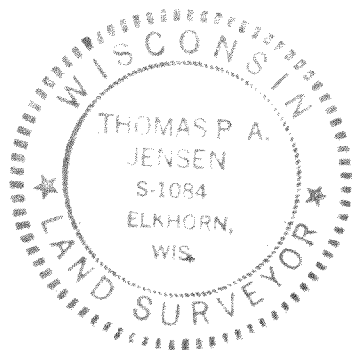


# PLAT OF SURVEY

OF

THE NORTHERLY  $\frac{1}{2}$  OF LOT 37, LOT 38, AND THE  
SOUTHERLY  $\frac{1}{2}$  OF LOT 39, BLOCK 15, INTERLAKEN  
SUBDIVISION, SECTION 11, T3N R16E  
WALWORTH COUNTY, WISCONSIN.

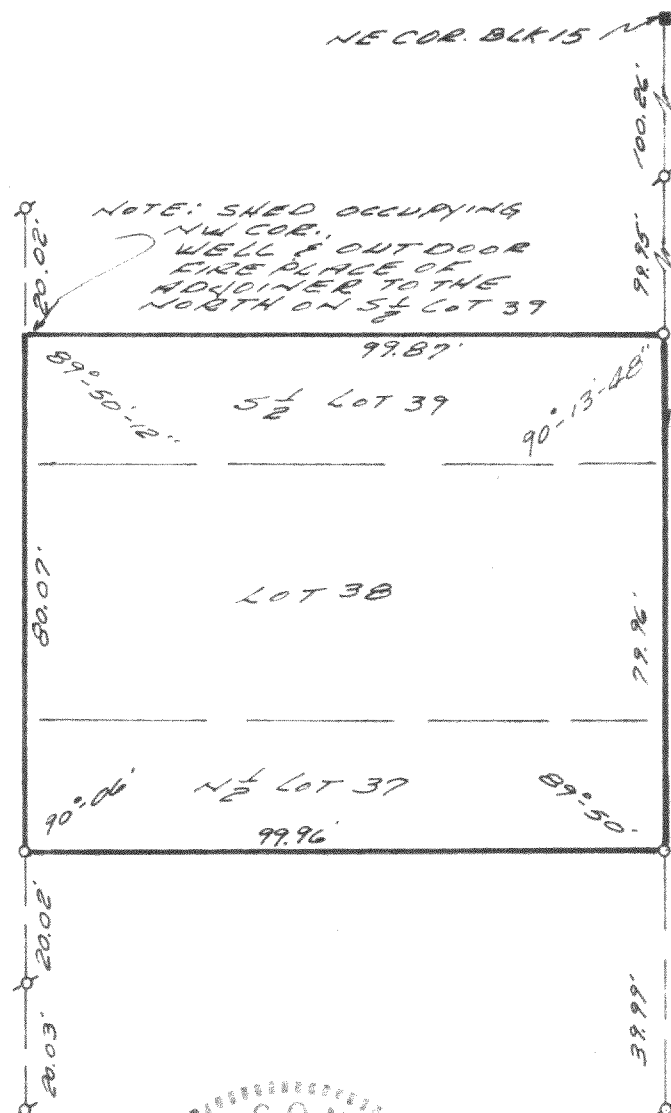

SURVEY AND PLAT BY

**JENSEN & JOHNSON, INC.**

CIVIL ENGINEERS AND SURVEYORS

Elkhorn, Wisconsin

## LEGEND

- — Iron Pipe SET
- — Concrete Monument FOUND
- Scale 1" = 30'
- S — IRON PIPE FOUND

WE CERTIFY: That we have surveyed the above described property and that the plat shown hereon is an accurate survey and a true representation thereof and correctly shows the exterior boundary lines and all divisions of said property.

Date APRIL 19, 1974

Thomas P. A. Jensen

Wisconsin Registered Land Surveyor, No. S-1084

GI-190

316-153