


PREPARED FOR:
HOMESTEAD LAKES REALTY, INC.
520 BROAD ST.
LAKE GENEVA, WI. 53147

PLAT OF SURVEY

- OF -

LOTS 6, 33, AND 34 IN BLOCK 2, LOT 1 IN BLOCK 4 AND LOTS 12-15, INCLUSIVE, IN BLOCK 5
IN BLUE WING ESTATES, TOWN OF SUGAR CREEK, WALWORTH COUNTY, WISCONSIN

J.K. SURVEYING INC.
N3705 WILLOWBEND LANE
LAKE GENEVA, WI, 53147
262-248-3697

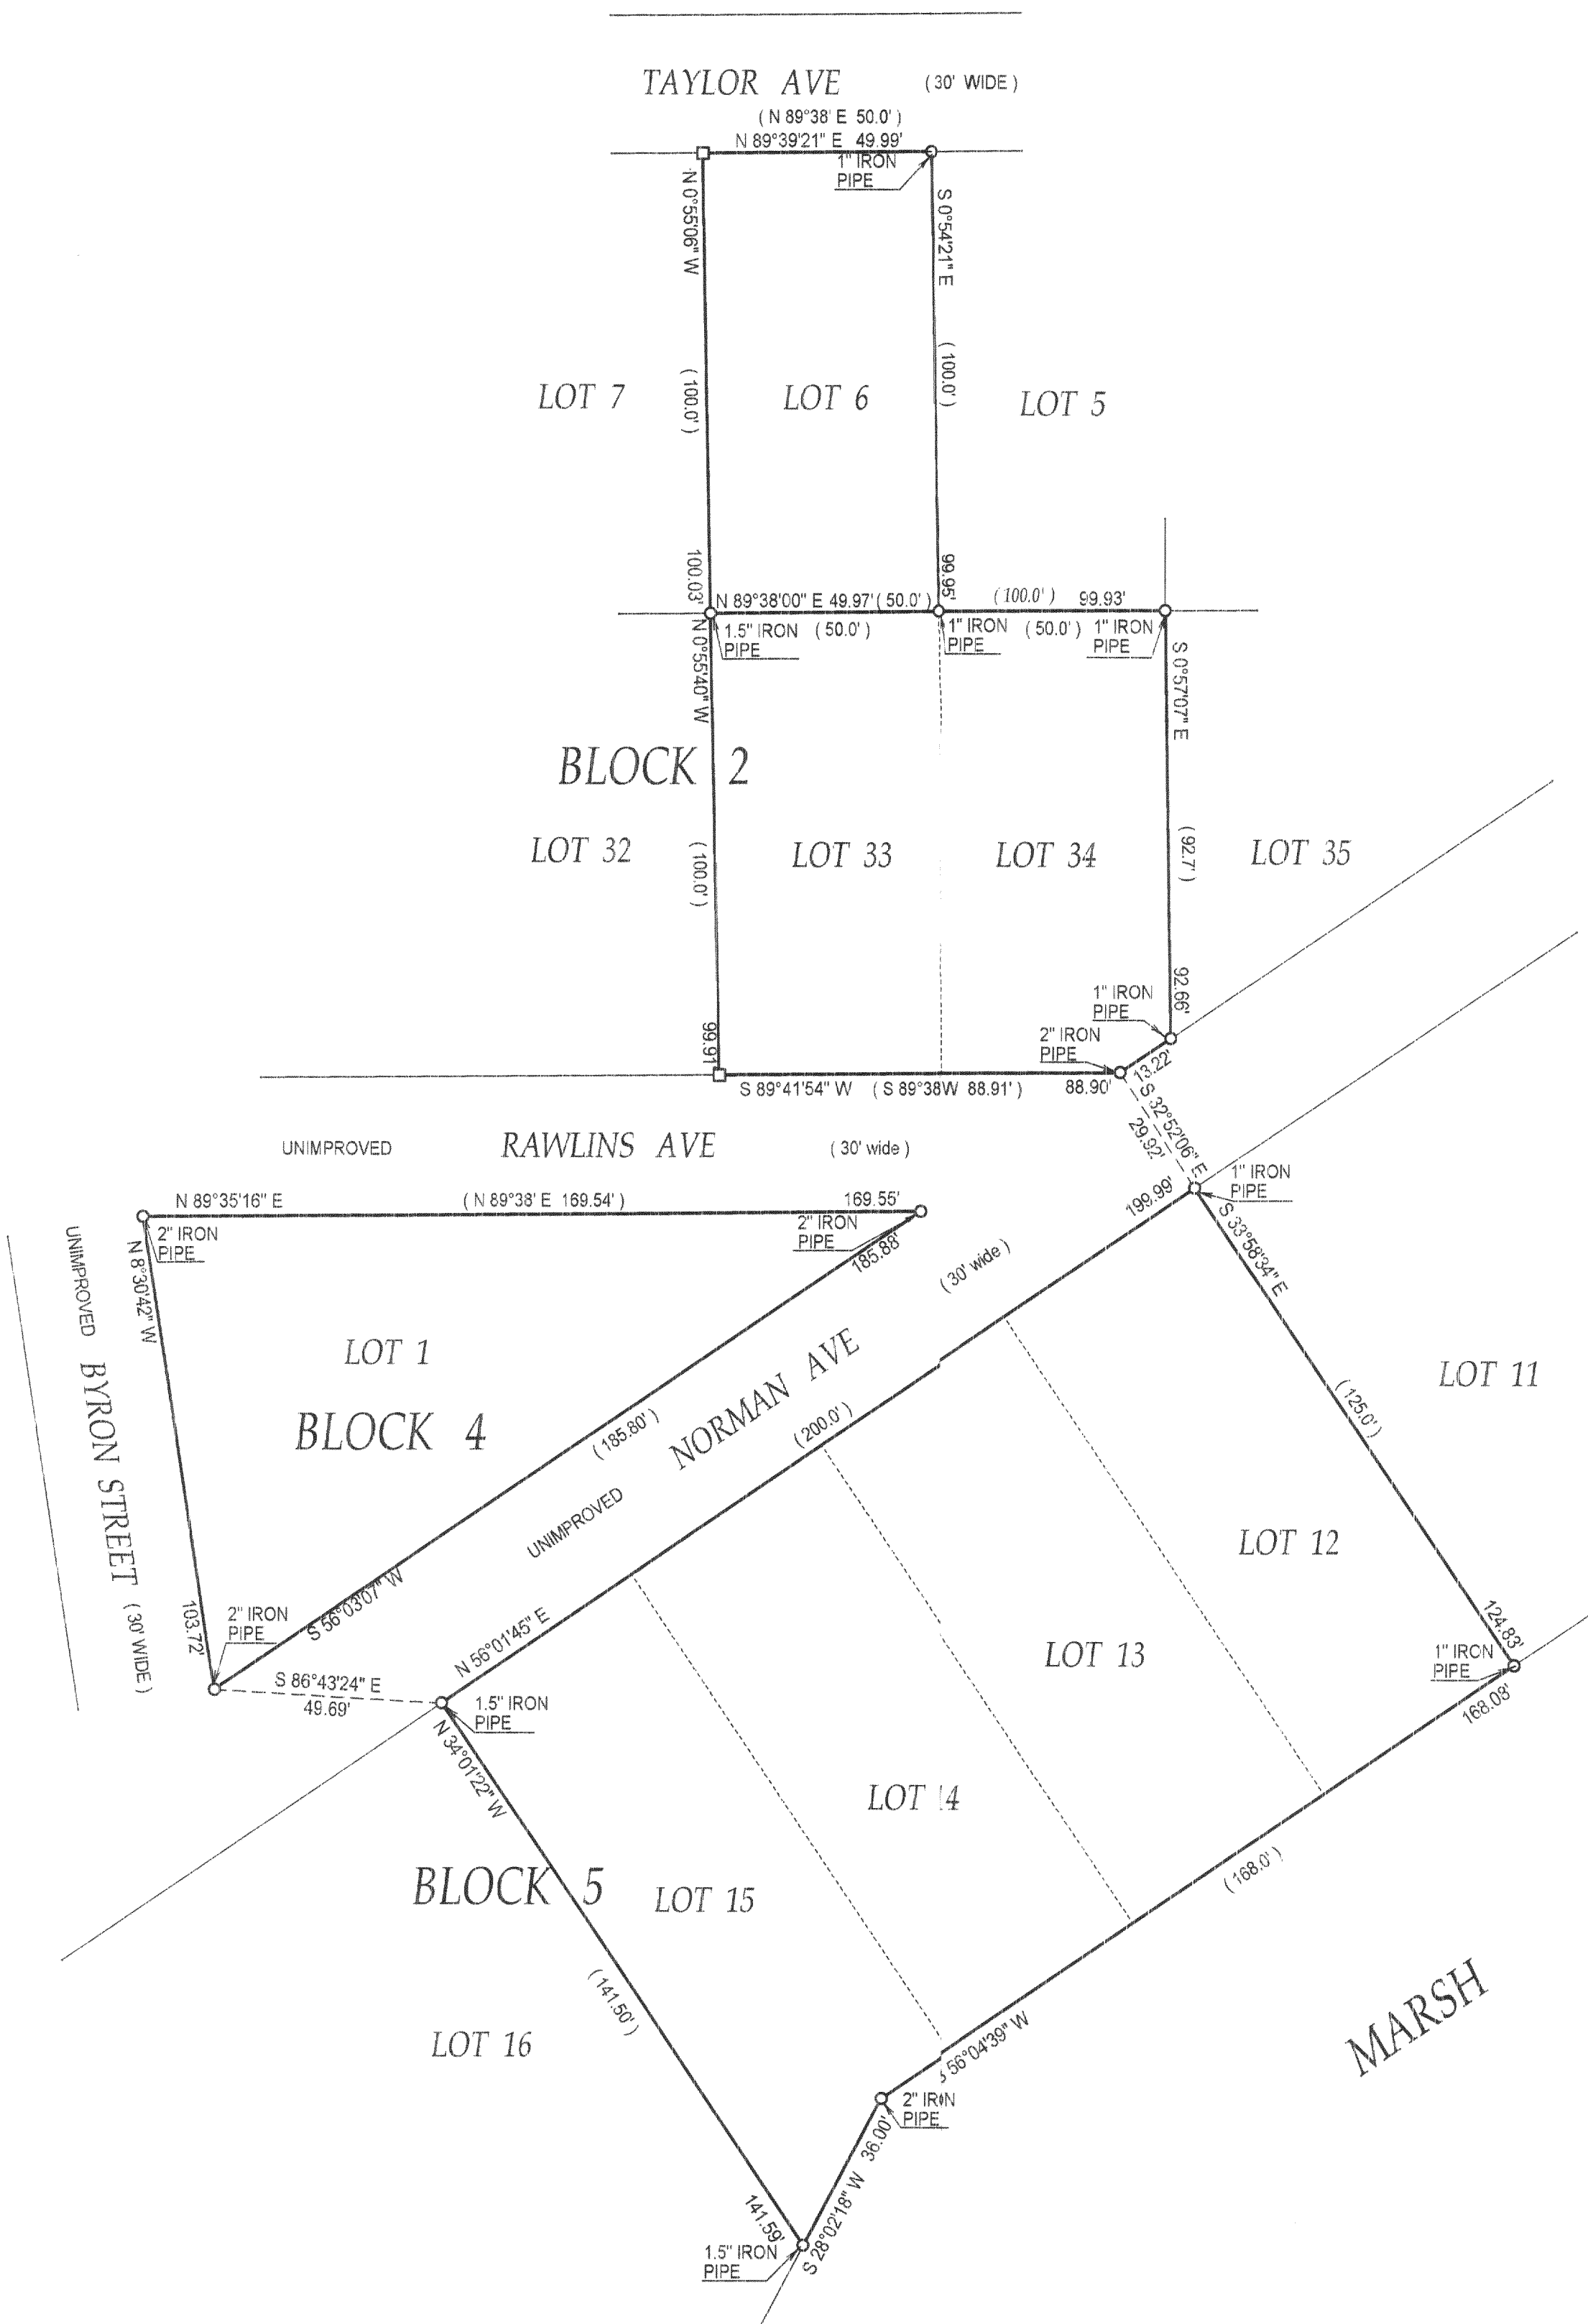

- () = recorded as
- = found iron bar
- = found iron pipe
- = set iron pipe
- = set iron bar

SCALE 1" = 30'


JOB# 03-154

TAX KEY# GBW 00008, GBW 00009,
GBW 00006, AND
GBW 00005B

COMPARE LEGAL DESCRIPTION ABOVE AND DRAWING WITH DEED, FOR BUILDING RESTRICTIONS AND
EASEMENTS NOT SHOWN REFER TO DEED, ABSTRACT CURVES AND LOCAL MUNICIPAL CODES. NOTIFY
THE SURVEYOR IMMEDIATELY OF ANY DISCREPANCY.

"I hereby certify that I have surveyed the above described property and that
the above map is a true representation thereof and shows the size and
location of all visible structures, appurtenant easements and encroachments
if any."
This survey is made for the present owners of the property, and those who
purchase, mortgage, or guarantee the title thereto, within one year from
the date hereof.

DATED THIS 01 TH DAY OF MAY 2003.

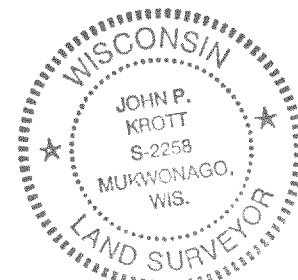

John P. Krott
JOHN KROTT S-2258
Wisconsin Registered Land Surveyor
(original if signed in red)

007-6

022

316-1559