

Plat of Survey

of


Lots 5 and 6 of Block 1 of North Lake Shore Woods,
a subdivision located in the Southeast 1/4 of Section 5, Town 3 North,
Range 16 East, Town of Sugar Creek, Walworth County, Wisconsin.

Surveyed for: **Town of Sugar Creek**
N6641 County Road H
Elkhorn, Wisconsin. 53121

Lake Shore Drive (25' Wide)


Shore Woods Drive

Bearings reference to previous
surveys of record.

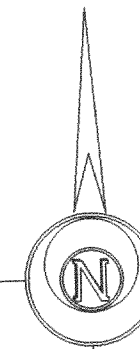

Survey Date: Sept. 25, 2003.

Revisions:

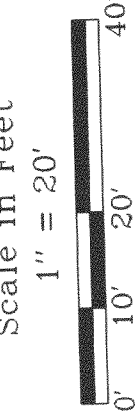

Jensen & Olson Land Surveying, LLC

45 South Wisconsin Street P.O. Box 322
Elkhorn, Wisconsin. 53121
Telephone (262) 723-3434
Facsimile (262) 723-8044

Legend

- Found Concrete Monument
- Found Concrete Pipe
- Found Iron Rod
- Set Iron Rod 3/4" dia.
- Recorded Information
- Concrete Surface
- Asphalt Surface


Sheet 1 of 1 Sheets

Job Reference Number

2003.145

2003.145

316-1587

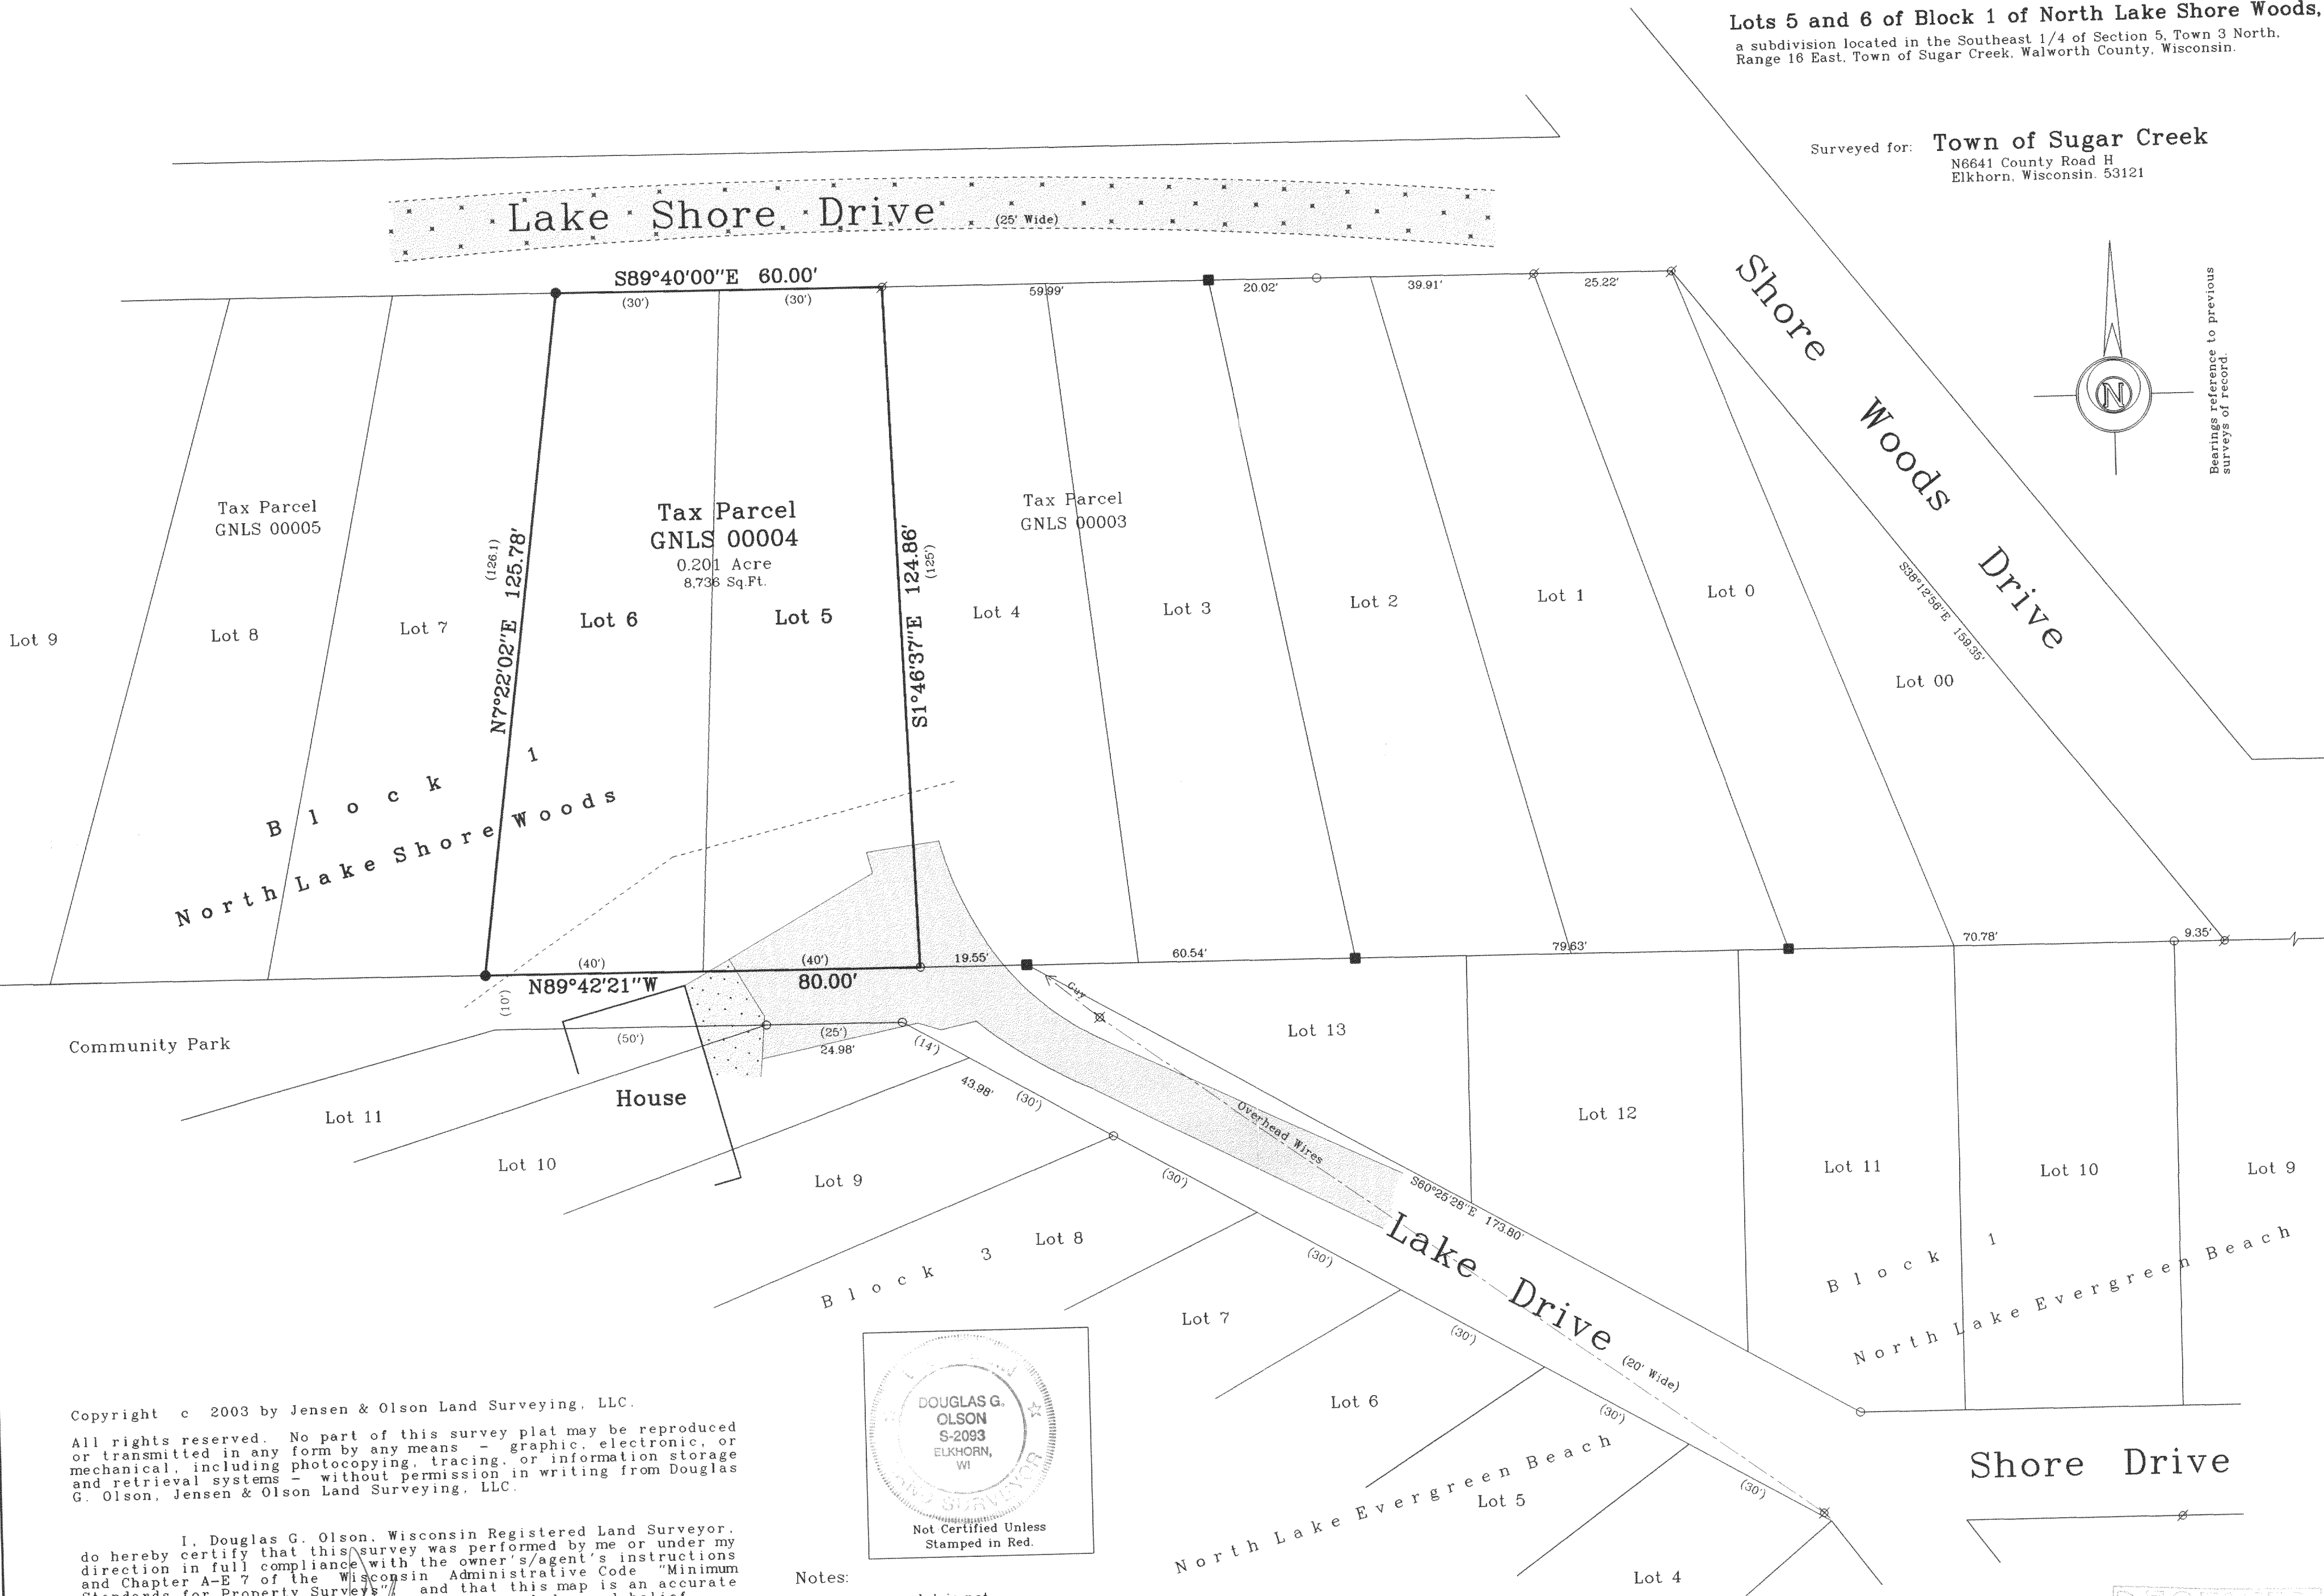


Copyright © 2003 by Jensen & Olson Land Surveying, LLC.

All rights reserved. No part of this survey plat may be reproduced or transmitted in any form by any means - graphic, electronic, or mechanical, including photocopying, tracing, or information storage and retrieval systems - without permission in writing from Douglas G. Olson, Jensen & Olson Land Surveying, LLC.

I, Douglas G. Olson, Wisconsin Registered Land Surveyor, do hereby certify that this survey was performed by me or under my direction in full compliance with the owner's/agent's instructions and Chapter A-E 7 of the Wisconsin Administrative Code "Minimum Standards for Property Surveys", and that this map is an accurate representation thereof to the best of my knowledge and belief.

Douglas G. Olson
Wisconsin Registered Land Surveyor - 2093

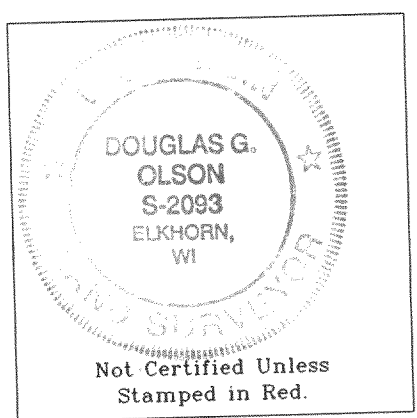

Notes:

- 1) This survey plat is not certified unless signed and sealed in red ink.
- 2) This survey is subject to Wisconsin lien laws. This Plat of Survey is the notice of intent to file lien. Lien waiver required.