

ABERNATHY and ASSOCIATES

Kenneth B. Abernathy Jr.

Wisconsin Registered Land Surveyor S-1594

W4056 BRAY RD.
ELKHORN, WI. 53121
PHONE: (262) 723-4260 (OFFICE)
(262) 723-7209 (FAX)
Email: abernathy@elknet.net

PLAT OF SURVEY


LOTS 6 - 11 INCLUSIVE AND LOTS 19 1/2 - 23
INCLUSIVE OF BLOCK "E" OF NORTH LAKE BEACH
TRACT NO. 1, LOCATED IN THE SOUTHWEST 1/4 OF
SECTION 5, TOWN 3 NORTH, RANGE 16 EAST, TOWN OF
SUGAR CREEK, WALWORTH COUNTY, WISCONSIN.

ORDERED BY: JOHN T. BRADY
2403 WEST MOSS AVE.
WEST PEORIA, IL. 61604

OWNER: ELIZABETH VICKERY
220 FULTON ST.
SOUTH ELGIN, IL. 60177


REVISED 7/24/03
PROPOSED RESIDENCE ADDED
TO LOTS 6-11 BLK. E

REVISED 10/28/03 TO SHOW
FOUNDATION "AS BUILT"

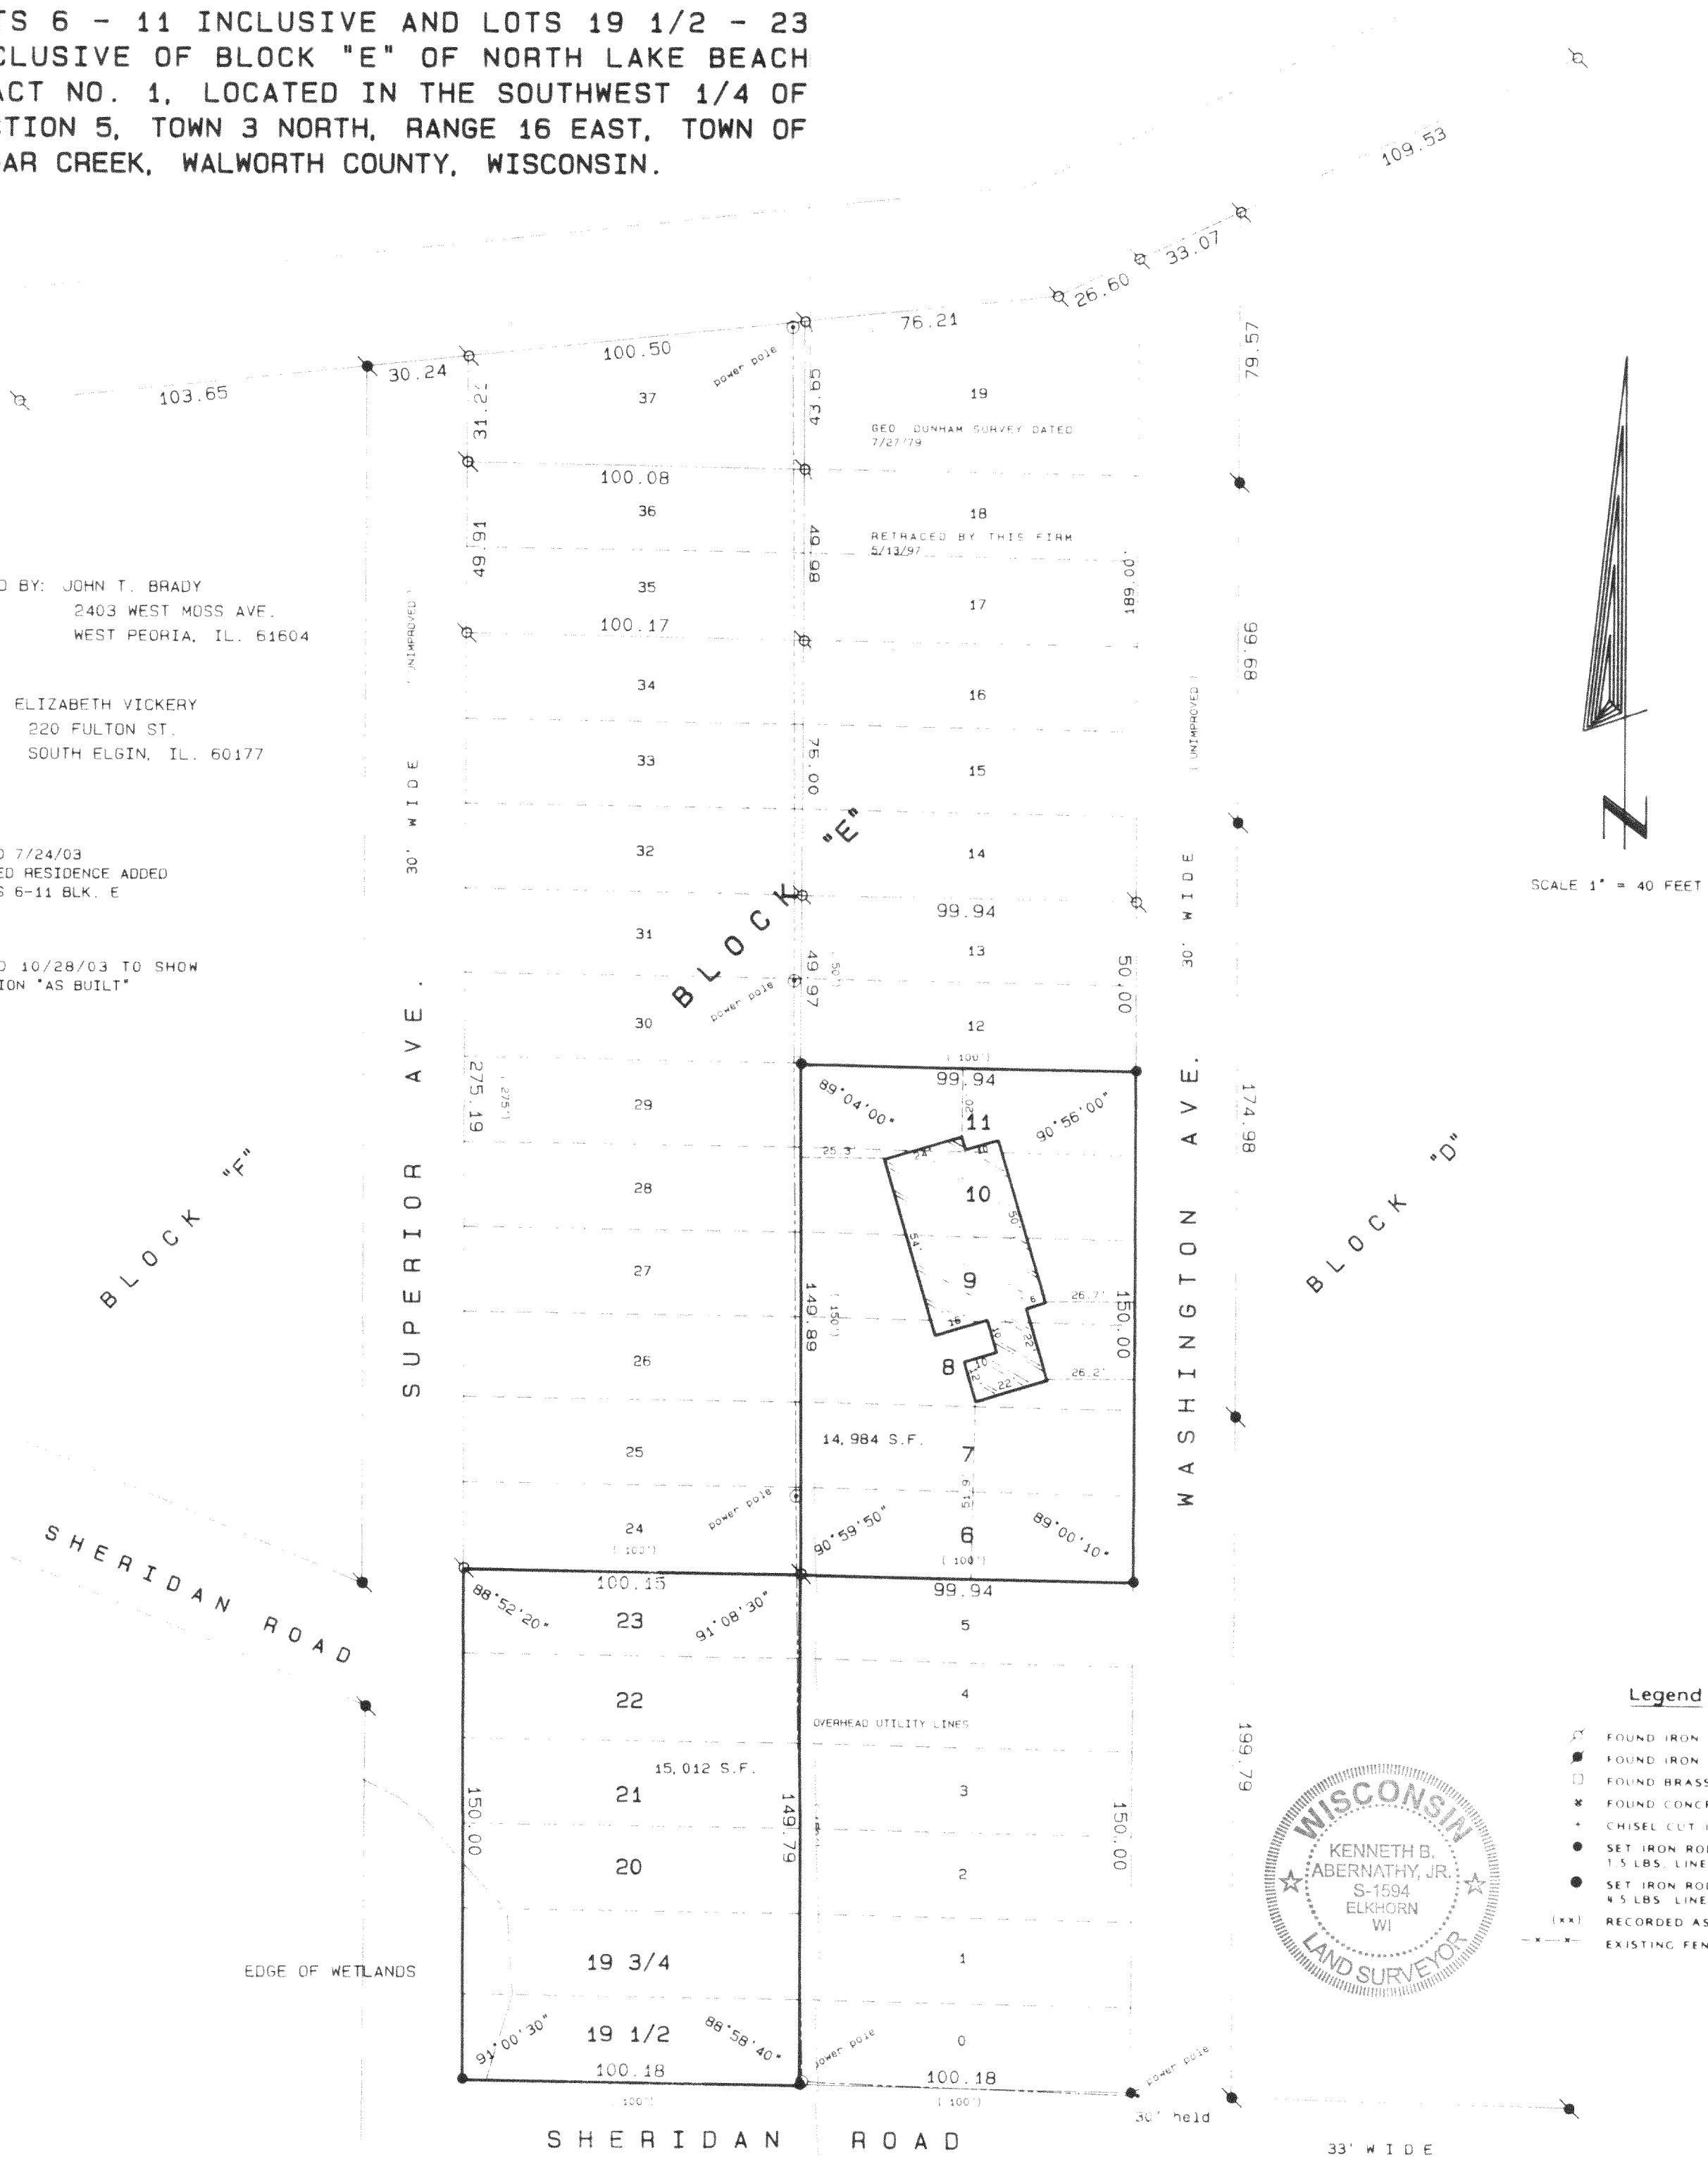


Legend

- FOUND IRON PIPE
- FOUND IRON ROD
- FOUND BRASS CAPPED MONUMENT
- FOUND CONCRETE MONUMENT
- CHISEL CUT IN CONCRETE
- SET IRON ROD, 24" LONG, WEIGHING 1.5 LBS. LINEAL FT., 1 1/4" DIA.
- SET IRON ROD, 30" LONG, WEIGHING 4.5 LBS. LINEAL FT., 1 1/4" DIA.
- RECORDED AS DIMENSION
- EXISTING FENCE

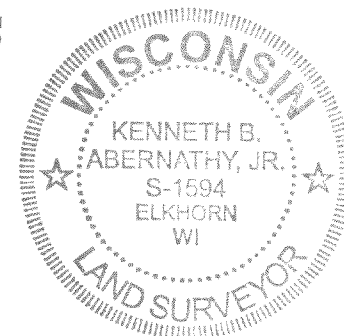

SCALE: 1"=40 FEET

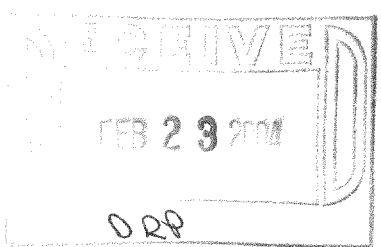

I hereby certify that the above described property has been surveyed by me or under my direction and that the above map is a true representation thereof and shows the size and location of the property, its exterior boundaries, the location of all visible structures, and dimensions of all principal buildings, the location of boundary lines, apparent easements, roadways and visible encroachments, if any. This survey is made for the use of the present owners of the property and also those who purchase hereafter, in guarantee of the same, and will remain in force for ever.

Kenneth B. Abernathy, Jr.
KENNETH B. ABERNATHY, JR.
WISCONSIN REGISTERED LAND SURVEYOR,
S-1594

Date: DEC. 19, 2001 Job No. 01-1201