




PLAT OF SURVEY

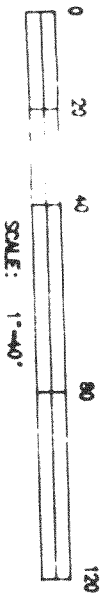

TIPPECANOE TRAIL (DOGWOOD RD.)

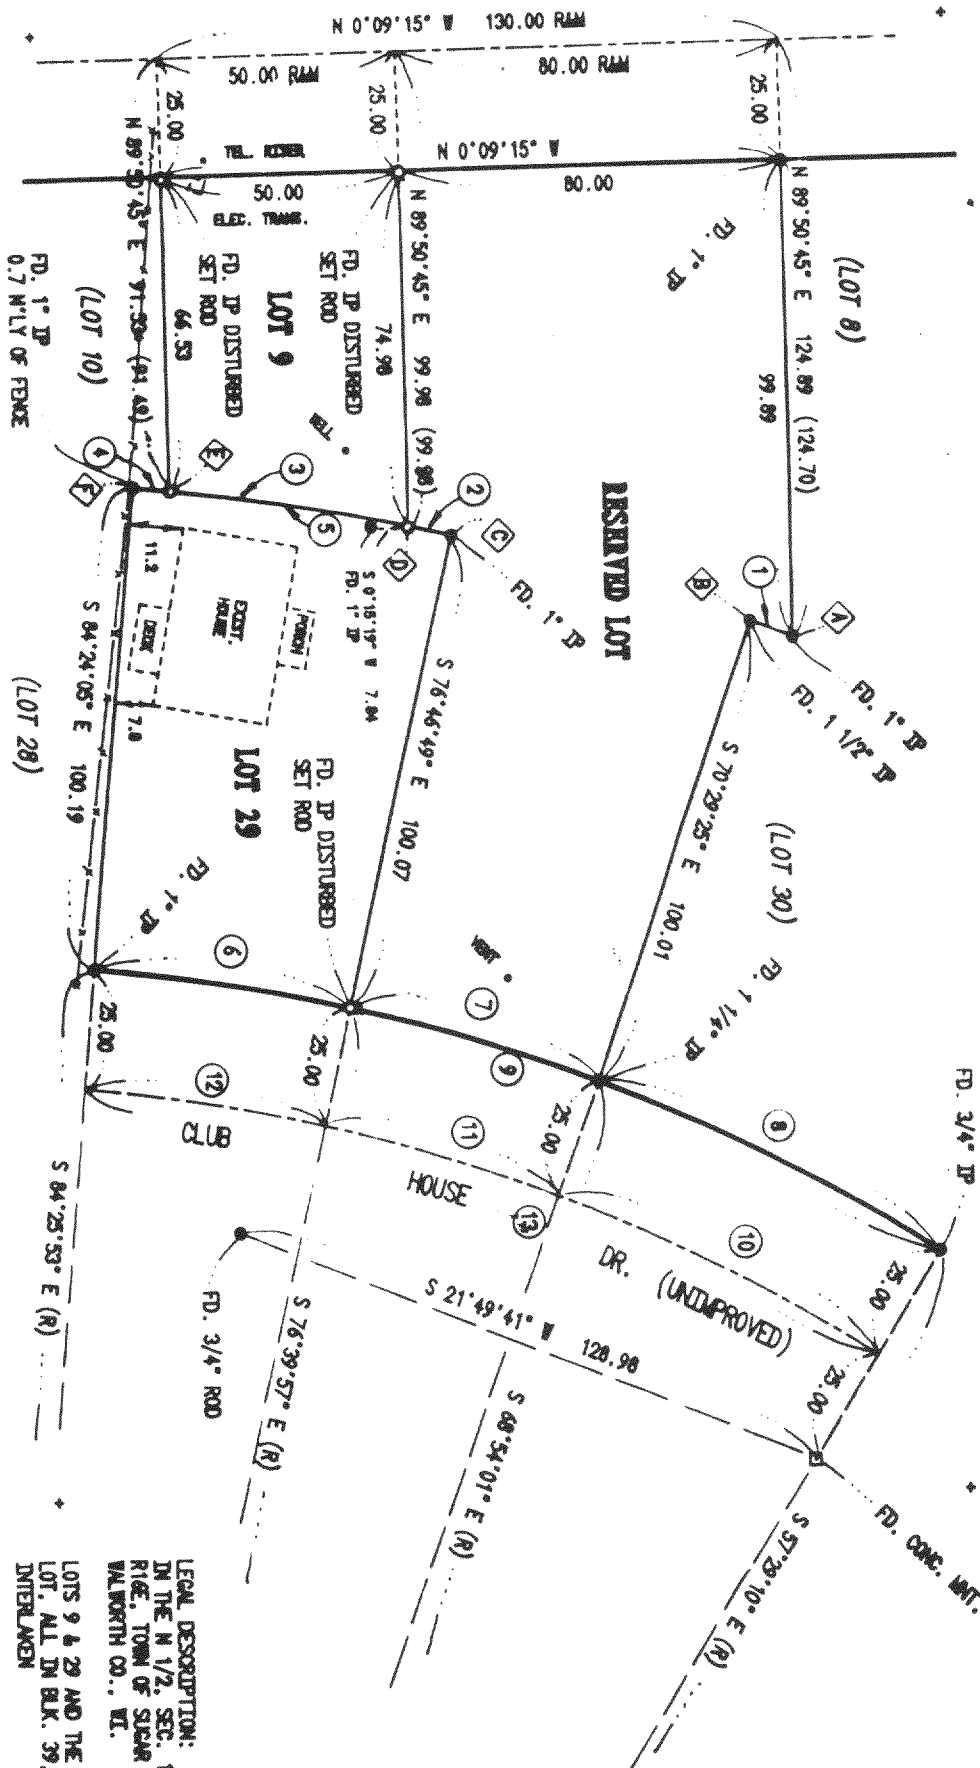


DATE: 9/19/03
 SURVEYOR'S CERTIFICATE
 I, JAMES K. LANGONE, REGISTERED LAND SURVEYOR, CERTIFY THAT
 I HAVE SURVEYED THE PROPERTY DESCRIBED HEREIN AND THAT THIS
 PLAT IS A TRUE AND CORRECT REPRESENTATION OF THE BOUNDARIES
 THEREOF.

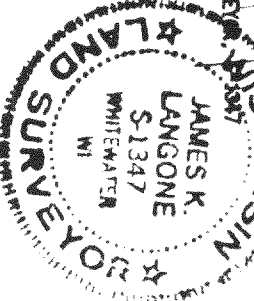

- NOTES:
- () INDICATES RECORD DATA
 - RAM INDICATES DIST. RECORD & MEASURED
 - INDICATES UNT. FD. AS NOTED
 - ② INDICATES CURVE DATA SEE SHT. 2
 - ⑧ INDICATES POINT BEARING SEE SHT. 2
 - INDICATES SET 3/4" IRON ROD

LEGAL DESCRIPTION:
 IN THE N 1/2, SEC. 11, T4N.
 R1E, TOWN OF SUGAR CREEK,
 VALWORTH CO., WI.
 LOTS 9 & 29 AND THE RESERVED
 LOT, ALL IN BLK. 39, 3RD MAP OF
 INTERLAKEN

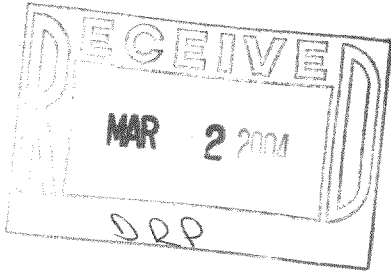

JAMES K. LANGONE
 LAND SURVEYS & CIVIL ENGINEERING

N339 Co. Rd. "N" (Upper)

Whitewater, WI. 53190-2842

(262) 473-4119

SHEET 1 OF 2
 JN: 03-116

GI-341B
 GI-349

316-1607

PLAT OF SURVEY

CURVE DATA

SYM	DELTA	RADIUS	LENGTH	LONG CHORD
1	1°04'57"	500.00	9.45	S 21°24'30" W 9.45
2	1°03'32"	500.00	9.24	S 12°52'03" W 9.24
3	5°48'48"	500.00	50.73	S 9°25'53" W 50.71
4	0°52'00"	500.00	7.56	S 6°05'25" W 7.56
5	7°44'19"	500.00	67.53	S 9°31'38" W 67.48
6	7°45'56"	400.00	54.21	N 9°27'05" E 54.17
7	7°45'56"	400.00	54.21	N 17°13'19" E 54.17
8	11°24'51"	400.00	79.68	N 26°48'12" E 79.55
9	26°56'43"	400.00	188.11	N 19°02'28" E 186.38
10	11°24'51"	375.00	74.70	S 26°48'11" W 74.58
11	7°45'56"	375.00	50.82	S 17°13'20" W 50.79
12	7°45'56"	375.00	50.83	S 9°27'05" W 50.79
13	26°56'43"	375.00	176.36	S 19°02'28" W 174.74

RADIAL BEARINGS

SYM	RADIAL BEARING
A	S 68°02'57" E (R)
B	S 69°07'54" E (R)
C	S 76°36'12" E (R)
D	S 77°39'44" E (R)
E	S 83°28'31" E (R)
F	S 84°20'31" E (R)



JAMES K. LANGONE

LAND SURVEYS & CIVIL ENGINEERING

N339 CO. RD. "N" (UPPER)

WHITEWATER, WI., 53190-2842

SHEET 2 OF 2
JN: 03-116

(262) 473-4119