

# FARRIS, HANSEN & ASSOCIATES, INC.


ENGINEERING - ARCHITECTURE - SURVEYING  
 7 RIDGWAY COURT - P.O. BOX 437 - ELKHORN, WISCONSIN 53121  
 PHONE: (262) 723-2098 FAX: (262) 723-5886

## PLAT OF SURVEY



LOT 1 OF CERTIFIED SURVEY MAP NO. 813  
 RECORDED AS DOC. NO. 36647  
 LOCATED IN PART OF INTERLAKEN 3rd MAP, TOWN 3 NORTH,  
 RANGE 16 EAST, WALWORTH COUNTY, WISCONSIN

- WORK ORDERED BY -  
 ART HALLENBERG - A. HALLENBERG ASSOCIATES  
 N6671 TIPPECANOE TRAIL  
 ELKHORN, WI 53121

RECEIVED  
 MAY 12  
 KW

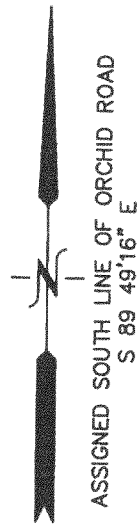

## ORCHID ROAD 50' WIDE R.O.W.

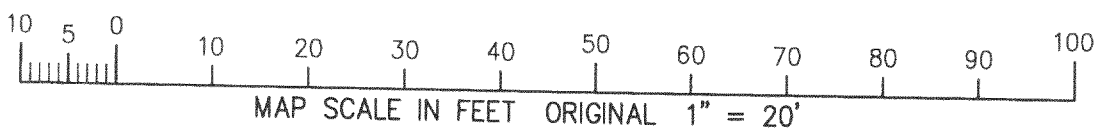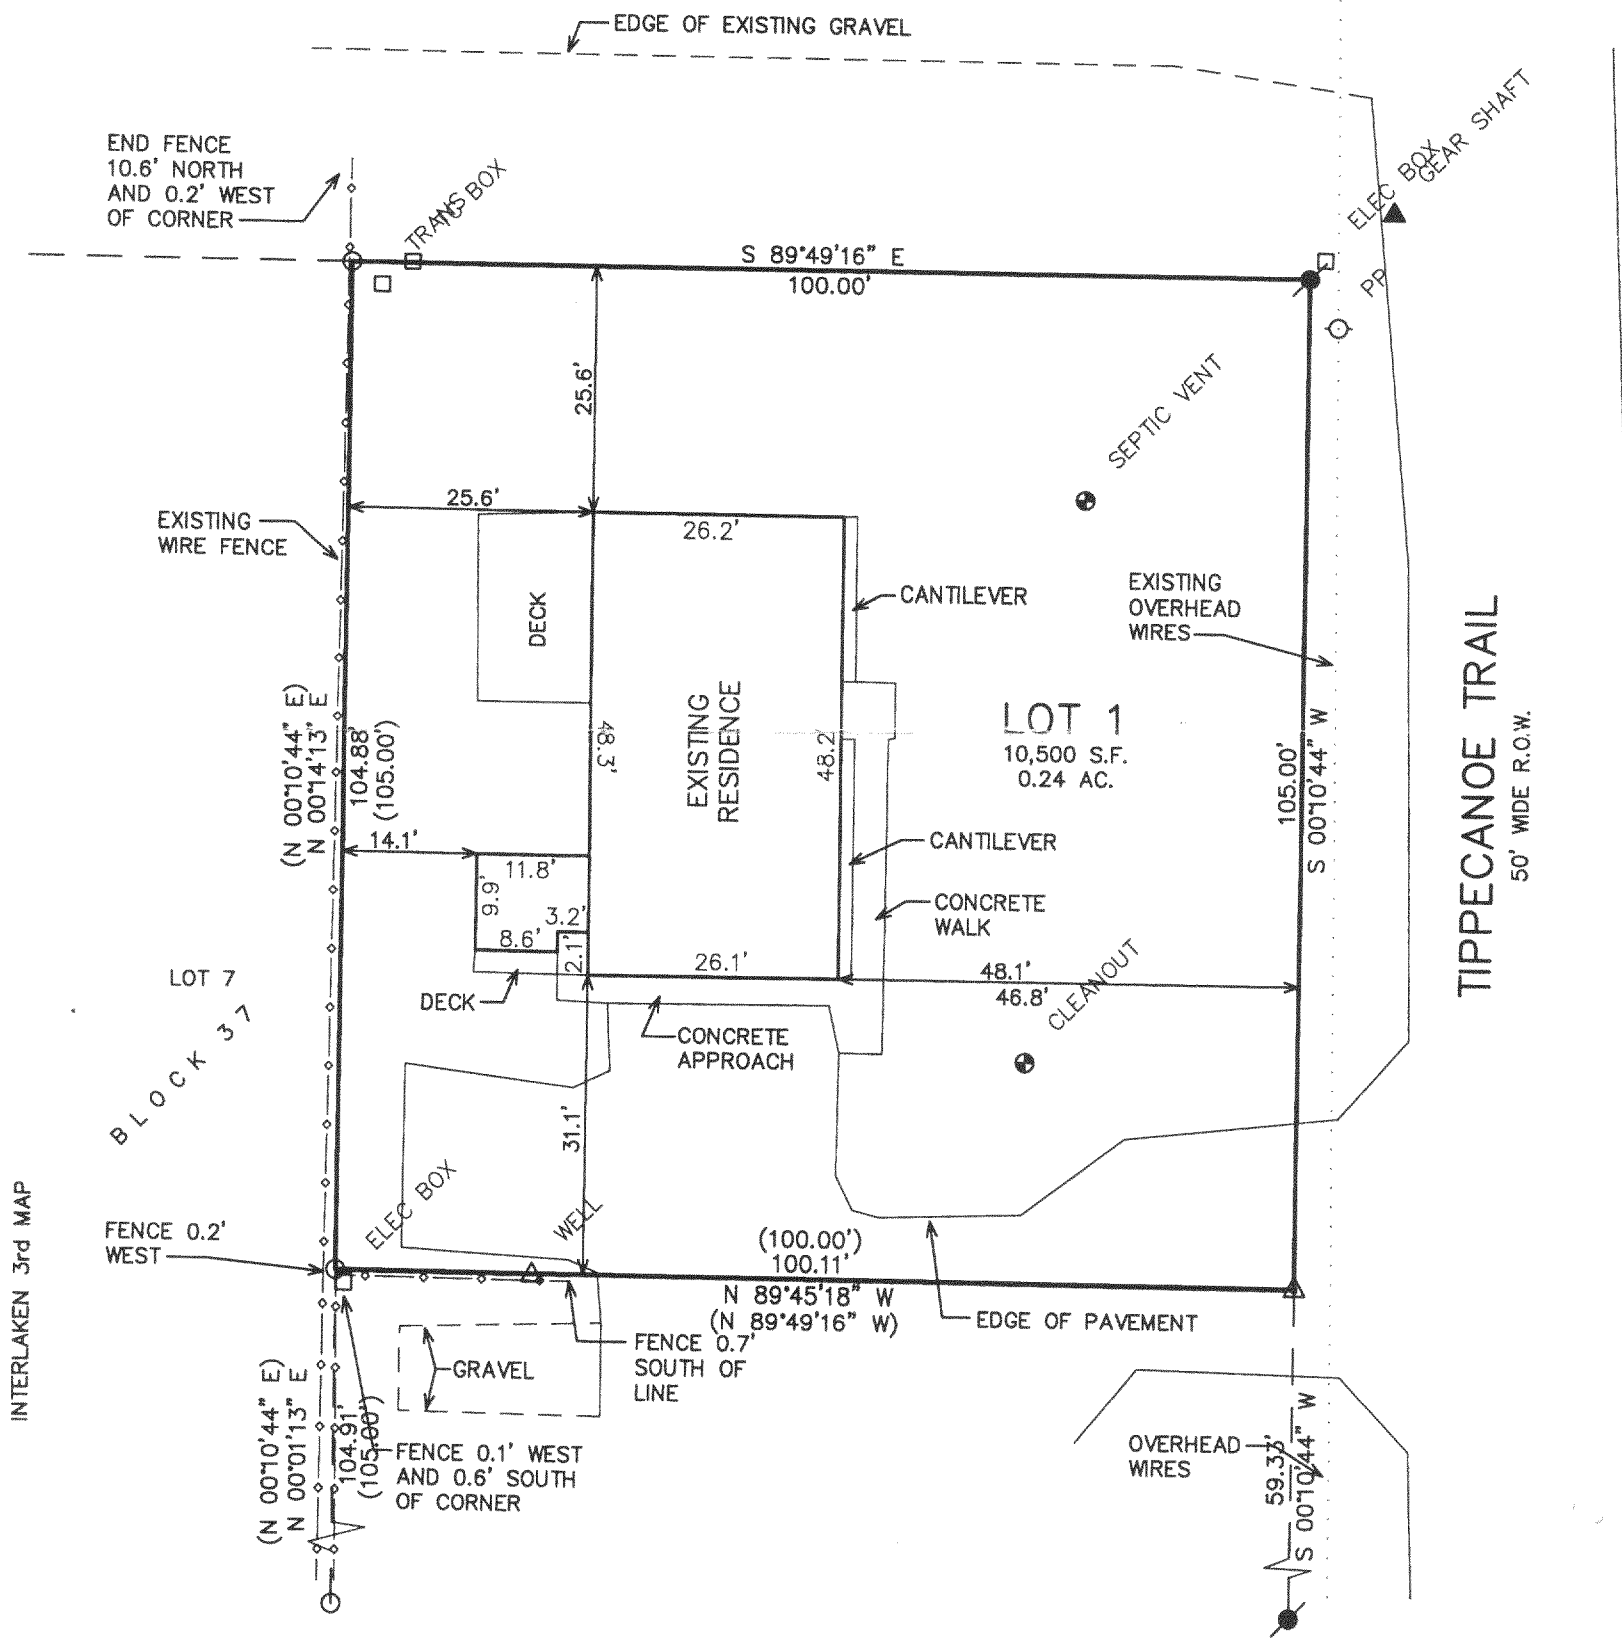

NOTE: COPIES OF THIS MAP TO WHICH THE FOLLOWING CERTIFICATE WILL APPLY SHOW THE SURVEYOR'S ORIGINAL SEAL AND SIGNATURE IN RED INK. COPIES BY ANY OTHER MEANS MAY HAVE ALTERATIONS WHICH DO NOT REPRESENT THE SURVEYOR'S WORK PRODUCT.

I HEREBY CERTIFY THAT THE ABOVE DESCRIBED PROPERTY HAS BEEN SURVEYED UNDER MY DIRECTION AND THAT THE ABOVE MAP IS A TRUE REPRESENTATION THEREOF AND SHOWS THE SIZE AND LOCATION OF THE PROPERTY AND ITS EXTERIOR BOUNDARIES. THIS SURVEY IS MADE FOR THE USE OF THE PRESENT OWNERS OF THE PROPERTY, AND ALSO THOSE WHO PURCHASE, MORTGAGE, OR GUARANTEE THE TITLE THERETO WITHIN ONE YEAR FROM THE DATE HEREOF.

DATED: MAY 5, 2004

*Peter S. Gordon*  
 PETER S. GORDON R.L.S. 2101

- LEGEND
- = FOUND IRON PIPE STAKE
  - = SET IRON REBAR STAKE
  - ▲ = SET RAILROAD SPIKE IN PAVEMENT
  - (XXX) = RECORDED AS

PROJECT: 6548  
 DATE: 05/05/2004  
 SHEET 1 OF 1

5/5/2004 X:\Projects\6548\Map\Lot1

GA 8180001

316-1630