


# PLAT OF SURVEY

## LOT 8 OF GRANVILLE ESTATES

LOCATED IN THE SW 1/4 & SE 1/4 OF THE NE 1/4 OF  
SECTION 34, TOWN 3 NORTH, RANGE 16 EAST,  
WALWORTH COUNTY, WISCONSIN

SOUTH LINE OF THE NE 1/4 OF SECTION 34-3-16  
BEARS S 86°29'31" W

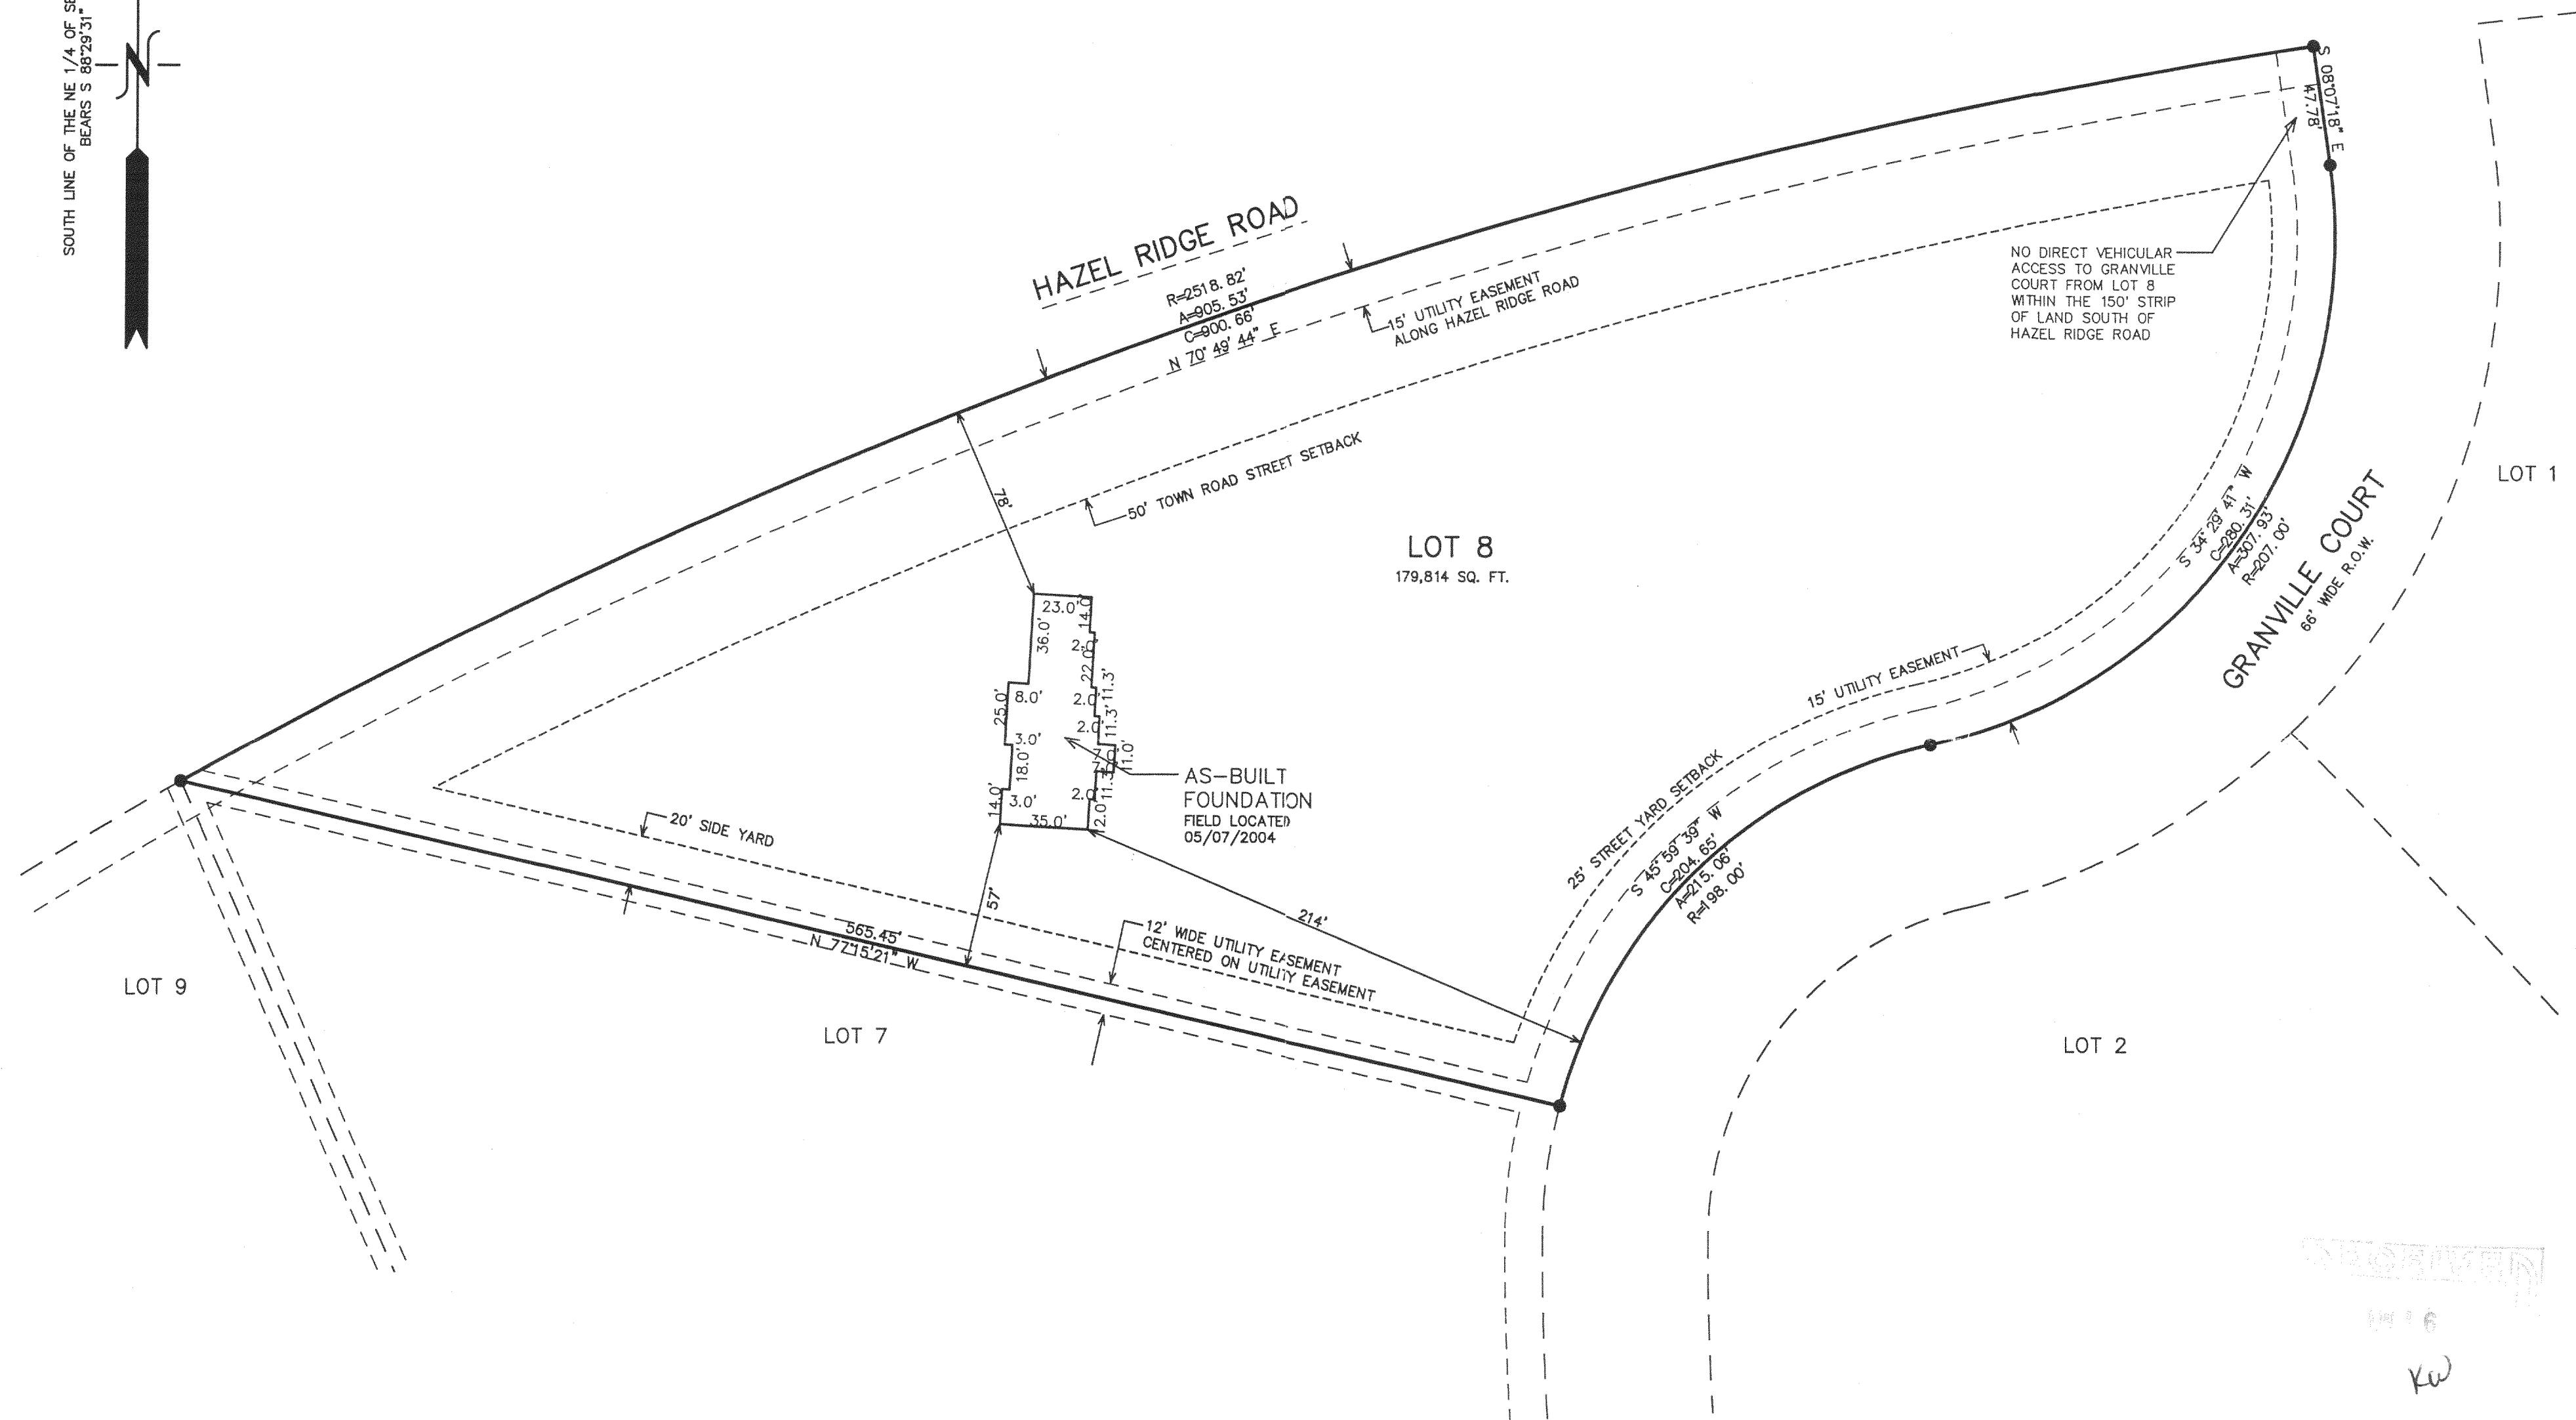

NOTE: COPIES OF THIS MAP TO WHICH THE FOLLOWING CERTIFICATE WILL APPLY SHOW THE SURVEYOR'S ORIGINAL SEAL AND SIGNATURE IN RED INK. COPIES BY ANY OTHER MEANS MAY HAVE ALTERATIONS WHICH DO NOT REPRESENT THE SURVEYOR'S WORK PRODUCT.

I HEREBY CERTIFY THAT THE ABOVE DESCRIBED PROPERTY HAS BEEN SURVEYED UNDER MY DIRECTION AND THAT THE ABOVE MAP IS A TRUE REPRESENTATION THEREOF AND SHOWS THE SIZE AND LOCATION OF THE PROPERTY AND ITS EXTERIOR BOUNDARIES. THIS SURVEY IS MADE FOR THE USE OF THE PRESENT OWNERS OF THE PROPERTY, AND ALSO THOSE WHO PURCHASE, MORTGAGE, OR GUARANTEE THE TITLE THERETO WITHIN ONE YEAR FROM THE DATE HEREOF.

DATED: FEBRUARY 9, 2004

REVISED 02-23-2004

PETER S. GORDON R.L.S. 2101

LEGEND  
● = FOUND IRON REBAR STAKE  
(XXX) = RECORDED AS

MAP SCALE IN FEET ORIGINAL 1" = 50'

WORK ORDERED BY -  
ALLAN KLAMM  
209 NORTH LINCOLN  
ELKHORN, WI 53121

FARRIS, HANSEN & ASSOCIATES, INC.  
ENGINEERING - ARCHITECTURE - SURVEYING  
7 RIDGWAY COURT P.O. BOX 437  
ELKHORN, WISCONSIN 53121  
OFFICE: (262) 723-2098 FAX: (262) 723-5886

REVISIONS  
05/10/2004  
TO SHOW SIZE  
AND LOCATION  
OF AS-BUILT  
FOUNDATION

PROJECT NO.  
4872.08  
DATE:  
02-09-04  
SHEET NO.  
1 OF 1

GG R 00008

316-1645