


PREPARED FOR: JEFF WINKLER  
34305 HONEY LN.  
BURLINGTON WI. 53105



J.K. SURVEYING INC.  
N3705 WILLOWBEND LANE  
LAKE GENEVA, WI, 53147  
262-248-3697

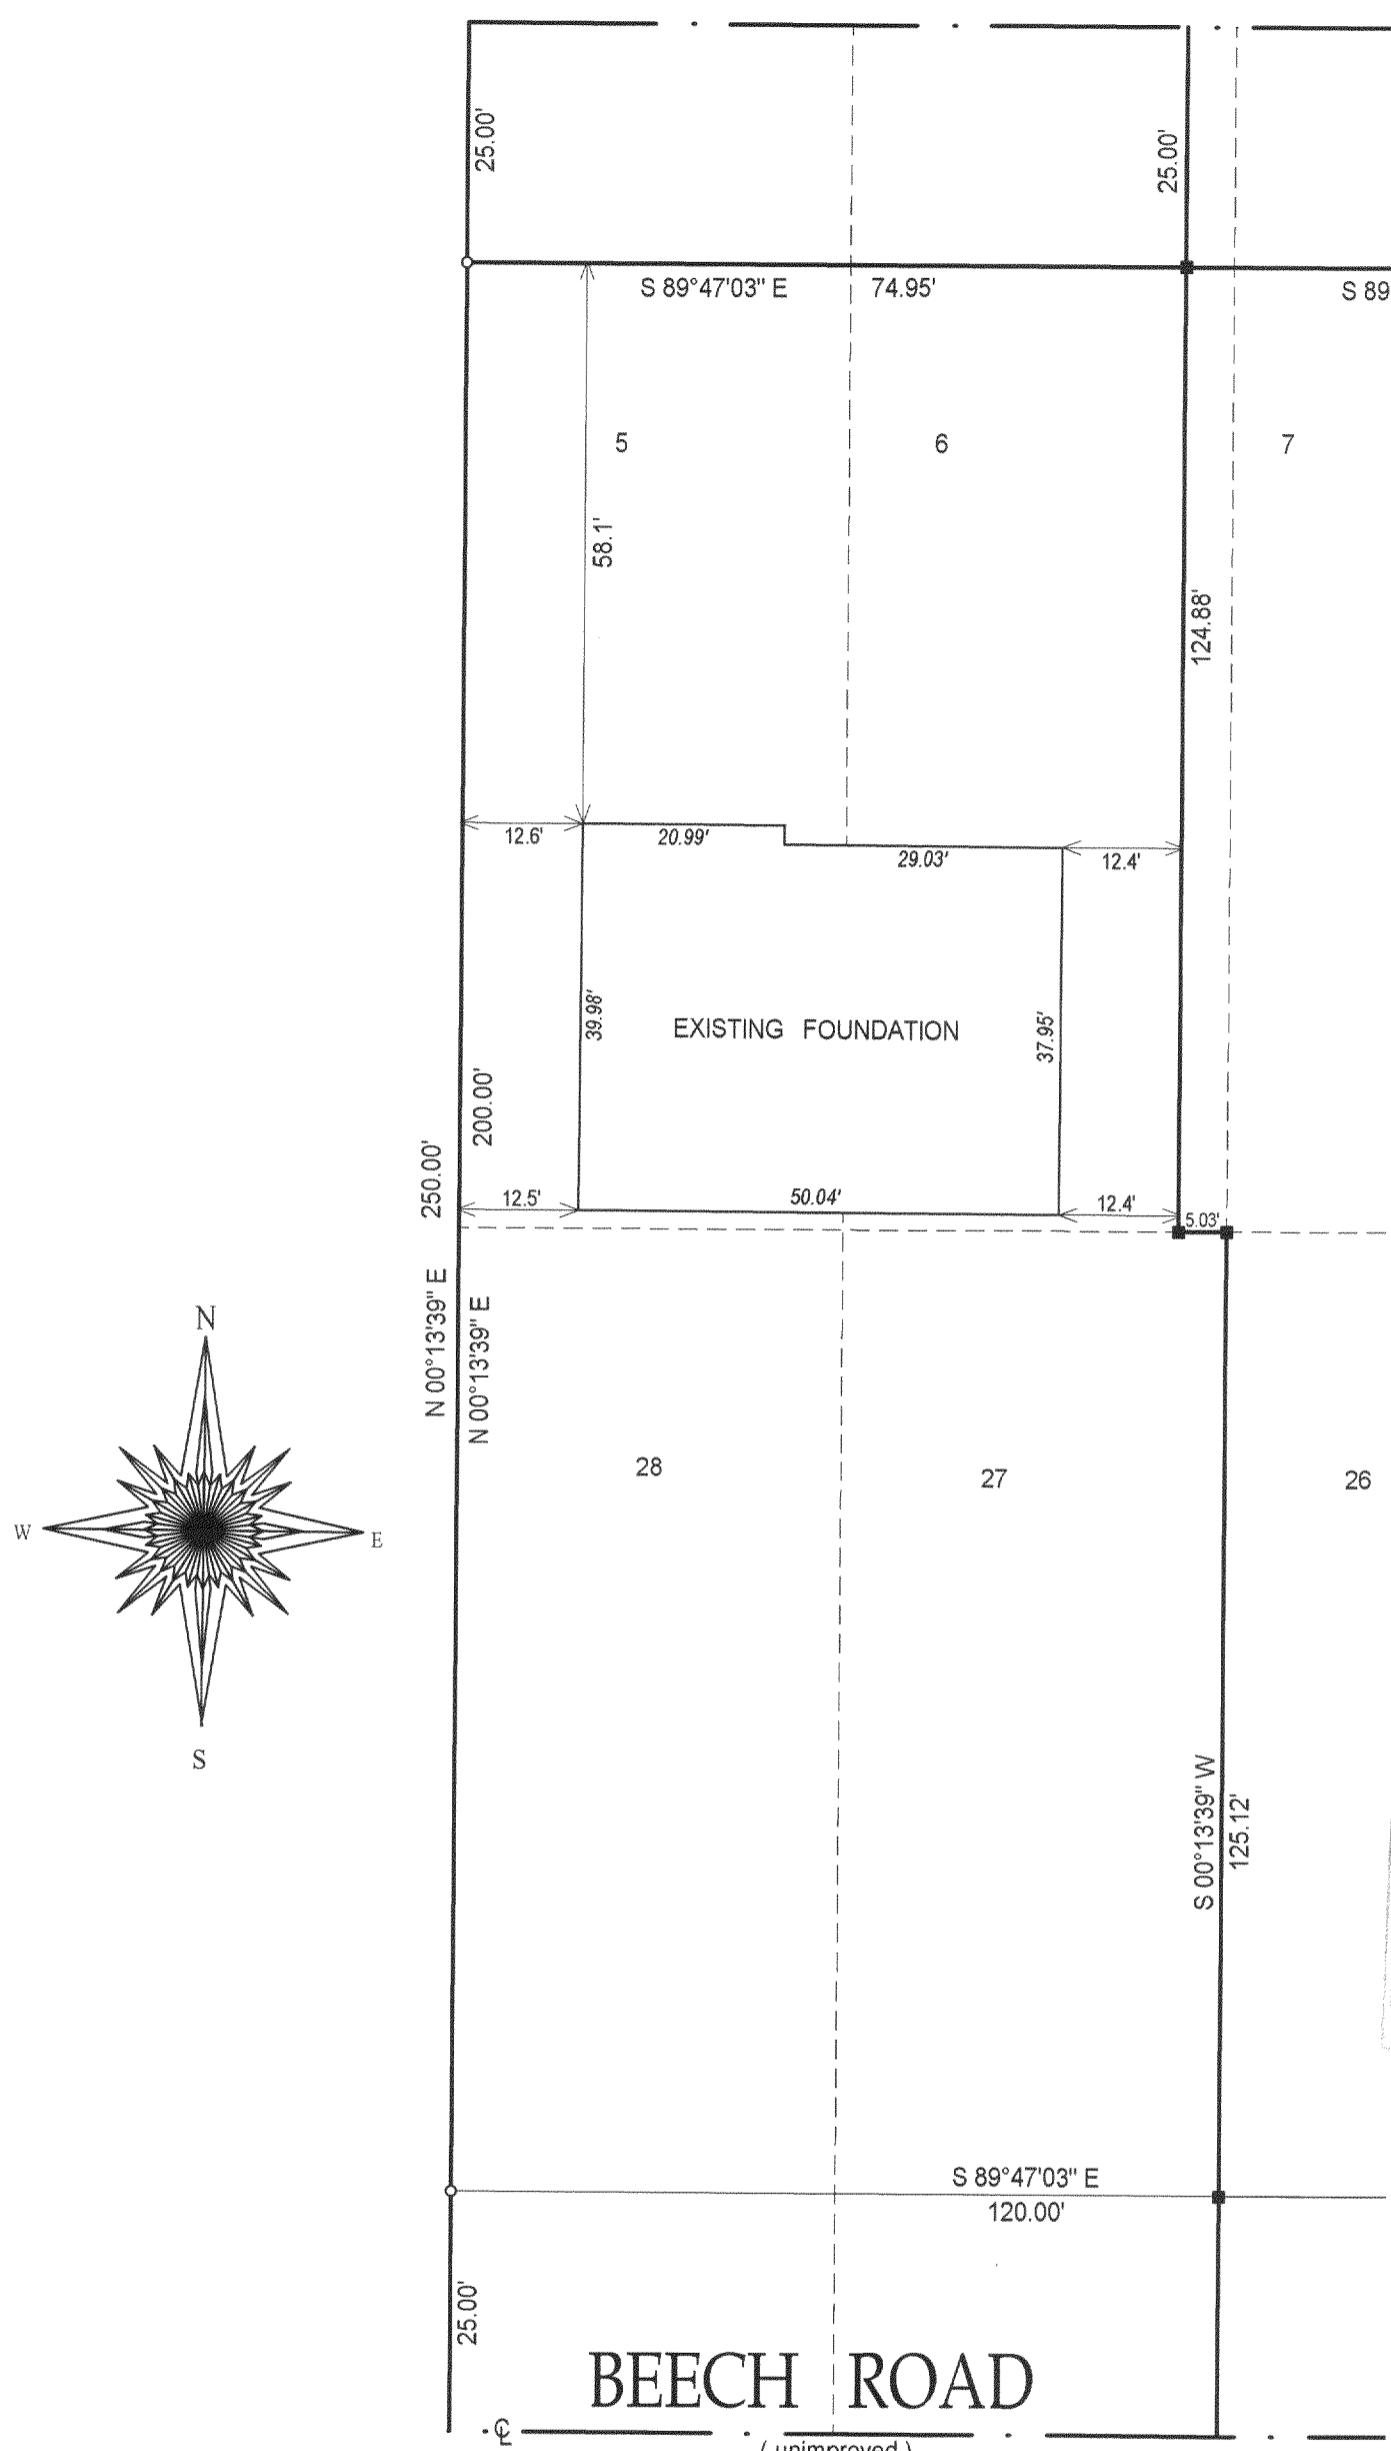

## PLAT OF SURVEY

-OF-

LOT 5 AND THE WEST 35 FEET OF LOT 6 AND LOTS 27 AND 28 BLOCK 67, INTERLAKEN, A SUBDIVISION LOCATED IN THE NW 1/4 OF SECTION 14, TOWN 3 NORTH, RANGE 16 EAST, TOWN OF SUGAR CREEK, WALWORTH COUNTY, WISCONSIN.

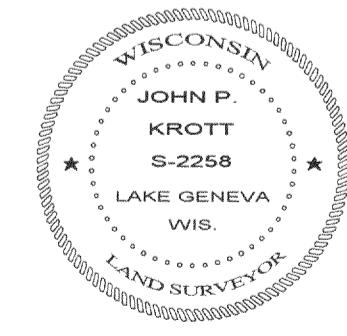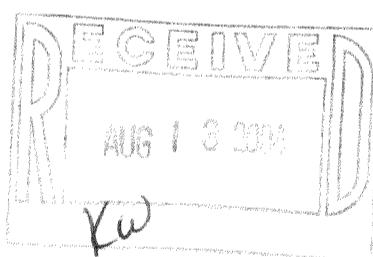

( ) = RECORDED AS

= FOUND IRON BAR

= FOUND IRON PIPE

= SET IRON PIPE

= SET IRON BAR

SCALE: 1" = 20'


JOB #: 03-417A

TAX ID #:

REVISED 2-3-2004 MOVED HOUSE BACK

COMPARE LEGAL DESCRIPTION ABOVE AND DRAWING WITH DEED. FOR BUILDING RESTRICTIONS AND EASEMENTS NOT SHOWN REFER TO DEED, ABSTRACT SOURCES AND LOCAL MUNICIPAL CODES. NOTIFY THE SURVEYOR IMMEDIATELY OF ANY DISCREPANCY.

"I hereby certify that the above described property was surveyed under my supervision and that the above map, to the best of my knowledge and belief, is a true representation thereof and shows the size and location of all visible structures, apparent easements and encroachments if any." This survey is made for the present owners of the property, and those who purchase, mortgage, or guarantee the title thereto, within one year from the date hereof.

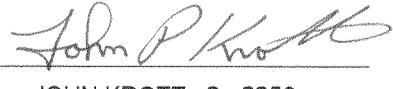  
JOHN KROTT S-2258  
Wisconsin Registered Land Surveyor  
(original if signed in red)

DATE OF LAST REVISION 04-20-04

DATED THE 3 RD, DAY OF FEB. 2004.

GI 80613

316-1663