

LAND-MARK SURVEYING

Mark L. Miritz

Wisconsin Registered Land Surveyor S-2582

N9330 Knuteson Drive
Whitewater, WI 53190
Phone: (262) 495-3284
FAX : (262) 495-8421
LAND-MARKSURVEYING.COM



PLAT OF SURVEY

LOT 20 OF BAYWOOD ESTATES
SUBDIVISION LOCATED IN THE
NORTHEAST 1/4 OF SECTION 2,
TOWN 2 NORTH, RANGE 16 EAST,
WALWORTH COUNTY, WISCONSIN.

DON JEAN BAY

100 YEAR FLOOD ELEVATION = 886.00'
FALLS IN RIP - RAP ALONG SHORELINE

OWNERS: JOSEPH AND JANICE REICHEL
W5330 PLANTATION ROAD
ELKHORN, WI. 53121

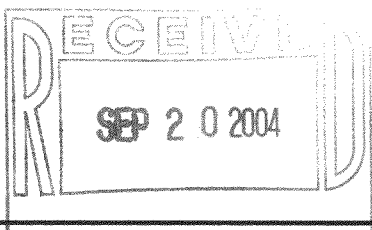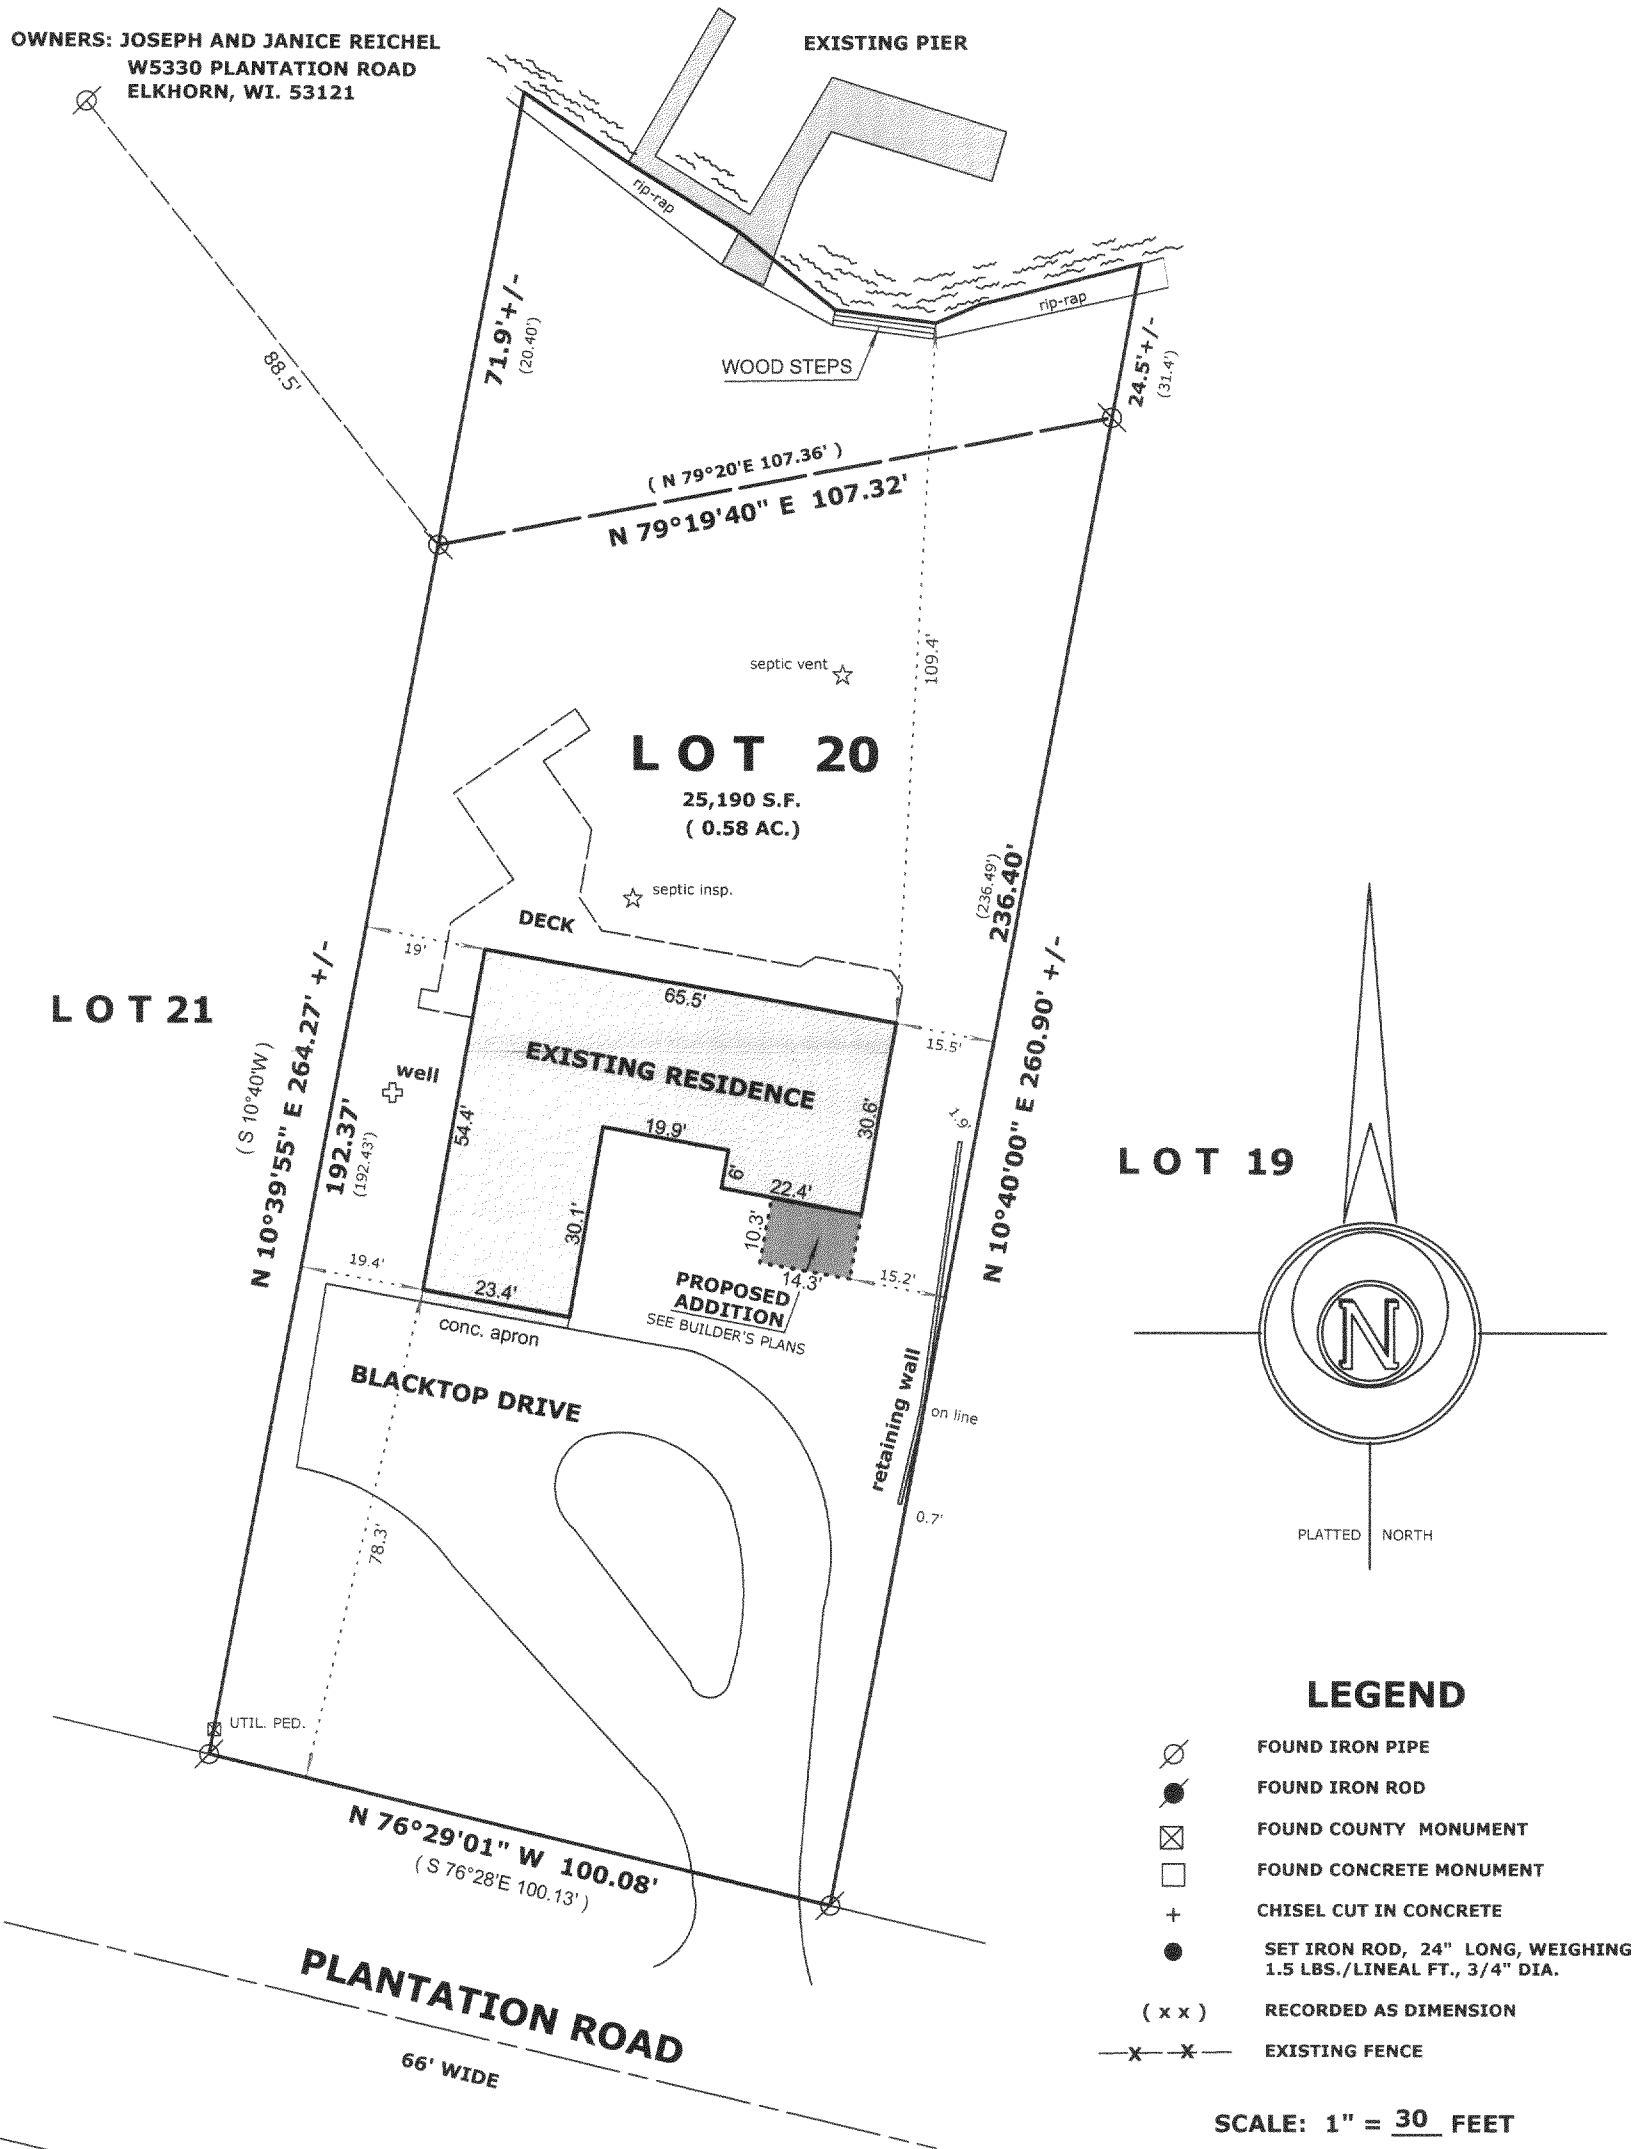

"I hereby certify that the above described property has been surveyed by me or under my direction and that the above map is a true representation thereof and shows the size and location of the property, its exterior boundaries, the location of all visible structures and dimensions of all principal buildings thereon, boundary fences, apparent easements, roadways and visible encroachments, if any."

"This survey is made for the use of the present owners of the property, and also those who purchase, mortgage, or guarantee the title thereto within one year from date hereof."

Mark L. Miritz
MARK L. MIRITZ
WISCONSIN REGISTERED
LAND SURVEYOR S-2582

DATE: Sept. 17, 2004 JOB NO. 04.906

GBE 00020

316-1677