


Plat of Survey

A parcel of land described in Title Commitment No. 412049 prepared by Chicago Title Insurance Company, dated October 12, 2004 as shown below:



Lots 33 and 34, and the following described portion of Lot 32, to-wit: Beginning at the SW corner of Lot 32 and proceeding in a Northerly direction along the West boundary line of said Lot to the NW corner thereof, proceeding thence in an Easterly direction along the North boundary thereof a distance of 3 feet and 6 inches from said NW corner, and proceeding thence in a Southerly direction in a straight line from said point to the place of beginning; all in Block 100 in Lake Wandawega Subdivision in Sections 1 and 2, Tsp. 3 N., R. 16 E.; And Also, Lots 15 and 16 in Block 100, Lake Wandawega Subdivision, as per plat recorded in Vol. 8 of Plats, Walworth County Records, Walworth County, Wisconsin.

Tax Key No. GLW 00212 & GLW 00206

Surveyed for: **Elk Realty**
N5488 Newman Drive
Elkhorn, Wisconsin. 53121

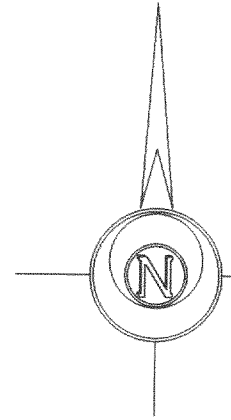

Bearings reference to previous surveys of record.

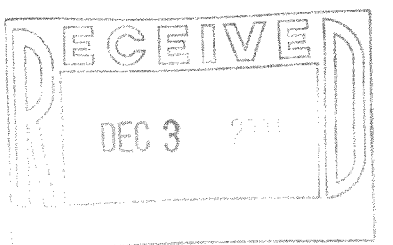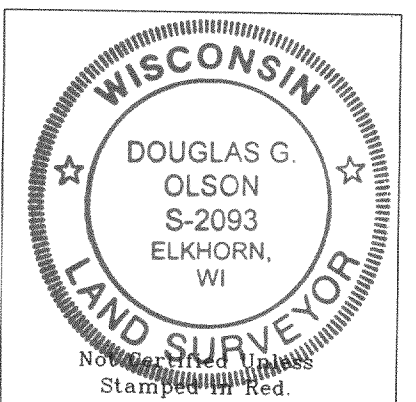

- Notes: 1) This survey plat is not certified unless signed and sealed in red ink.
- 2) This survey is subject to Wisconsin lien laws. This Plat of Survey is the notice of intent to file lien. Lien waiver required.


Copyright © 2004 by Jensen & Olson Land Surveying, LLC.

All rights reserved. No part of this survey plat may be reproduced or transmitted in any form by any means - graphic, electronic, or mechanical, including photocopying, tracing, or information storage and retrieval systems - without permission in writing from Douglas G. Olson, Jensen & Olson Land Surveying, LLC.

I hereby certify that I have surveyed the above described property and the map hereon is correct to the best of my professional knowledge and belief and shows the size and location of the property, its exterior boundaries, the location and dimensions of all visible structures thereon, boundary fences, apparent easements and roadways and visible encroachments, if any.

This survey is made for the exclusive use of the present owners of property, and also those who purchase, mortgage or guarantee title thereto, within one year from the date hereof.


Douglas G. Olson
Wisconsin Registered Land Surveyor - 2093

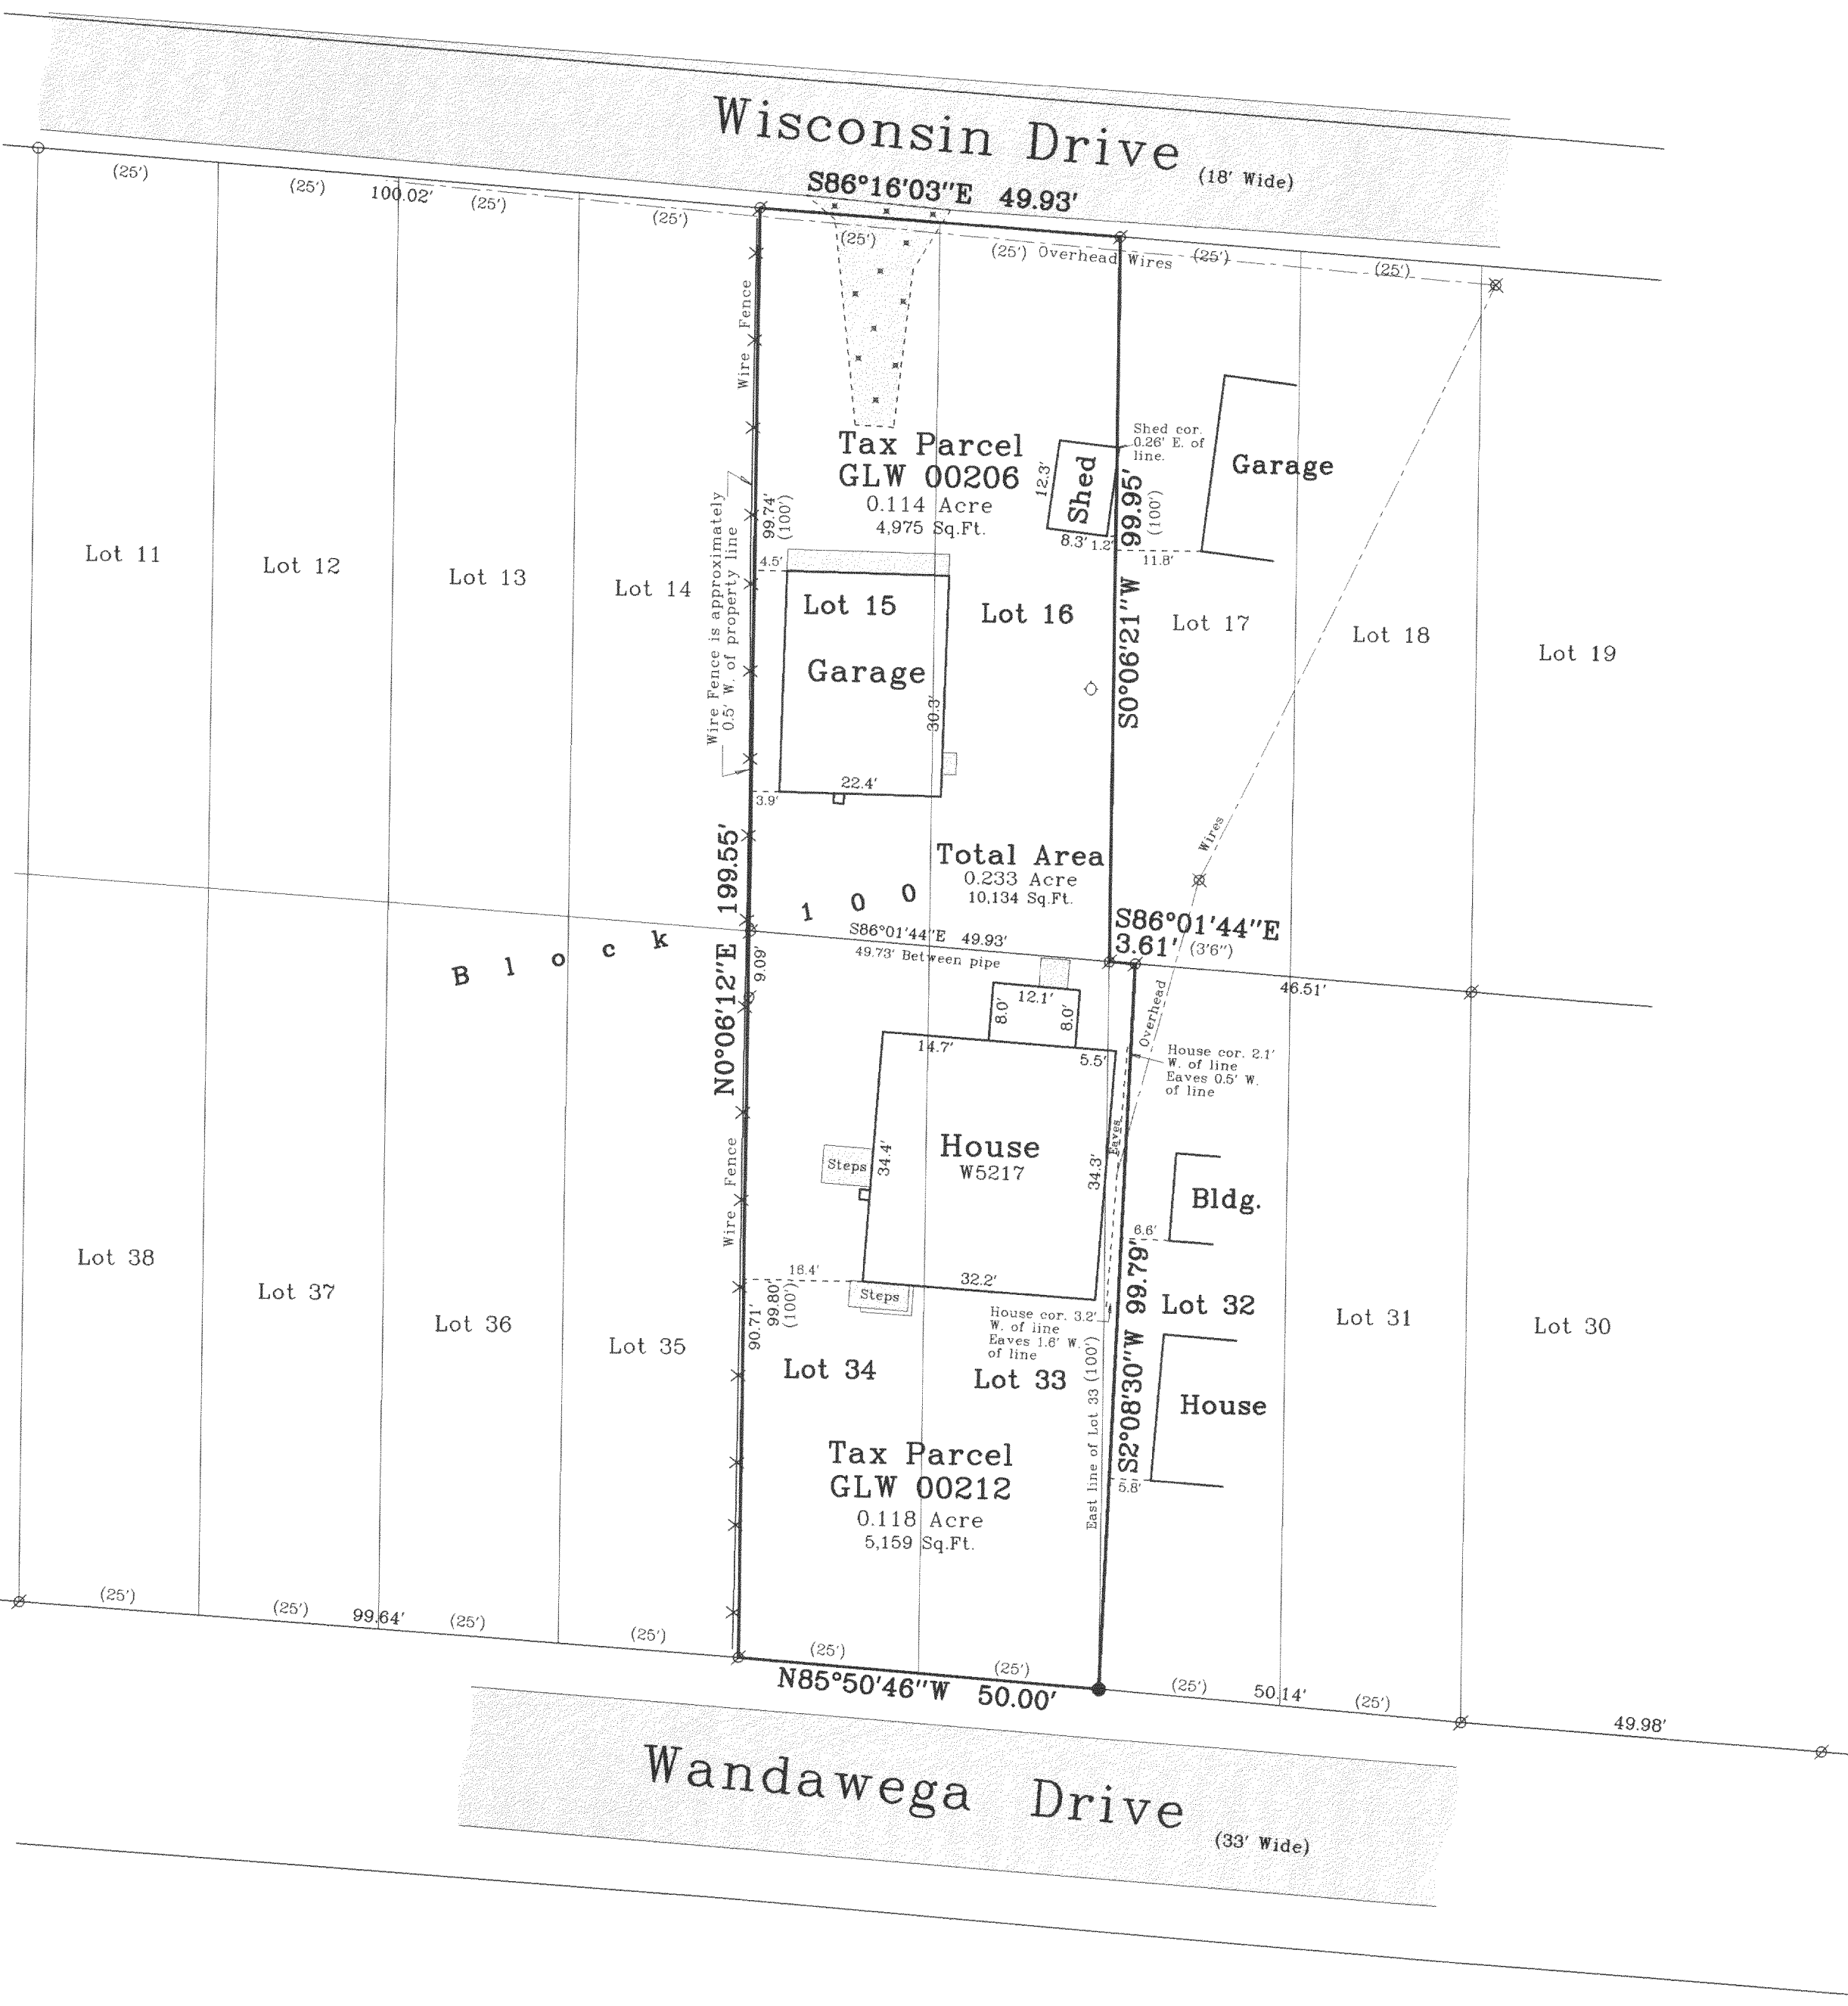

GLW-206
GLW-212

316-1699

Survey Date: October 22, 2004.
Revisions:

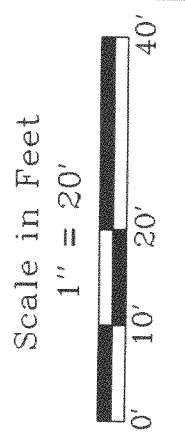

Jensen & Olson Land Surveying, LLC
45 South Wisconsin Street
Elkhorn, Wisconsin. 53121
Telephone (262) 723-3434
Facsimile (262) 723-8044

- Legend
- Found Iron Pipe
 - Found Iron Rod
 - Set Iron Rod
 - Recorded Information
 - Utility Pole
 - Septic Vent
 - Asphalt Surface
 - Concrete Surface
 - Gravel

Sheet 1 of 1 Sheets
Job Reference Number
2004.175

2004.175