


"RECERTIFICATION"
PLAT OF SURVEY


SURVEY FOR: WOLTER BROS. BUILDERS
LOCATION: GRENNING FARM ROAD

DRIGGETT/3184

DESCRIPTION: LOT 2 CERTIFIED SURVEY MAP NO. 2656, located in the N.E. 1/4 of the N.E. 1/4 and the S.E. 1/4 of the N.E. 1/4 of Section 6, Town 3 North, Range 16 East, Town of Sugar Creek, Walworth County, Wisconsin.

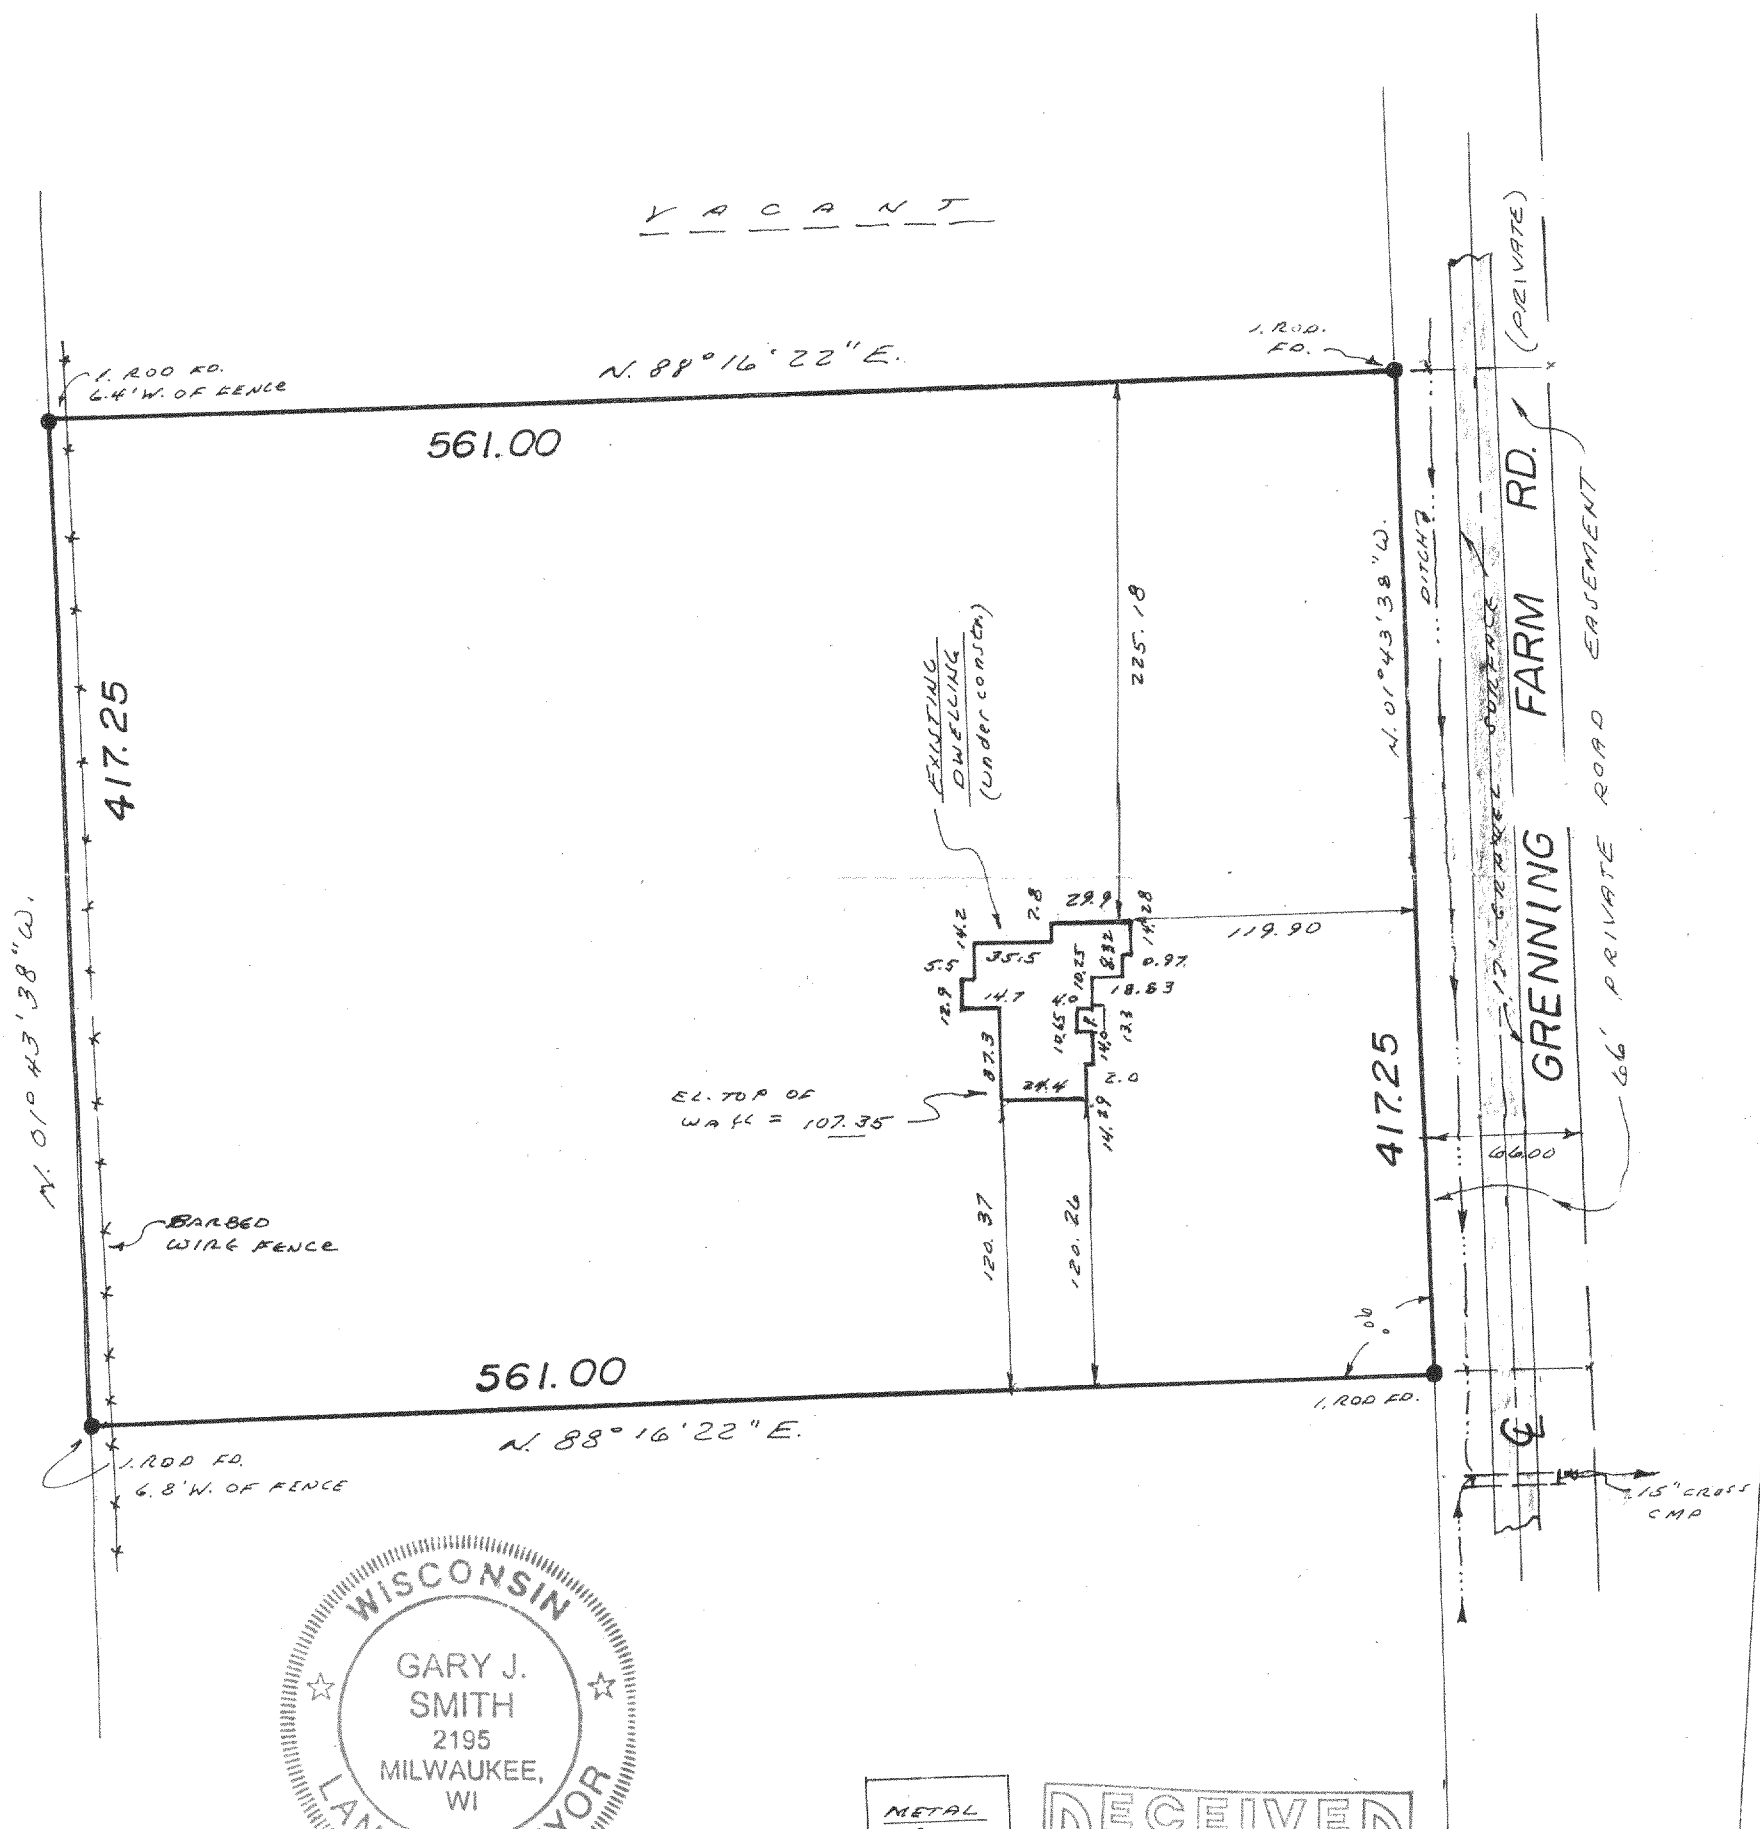

METAL
BLOG.

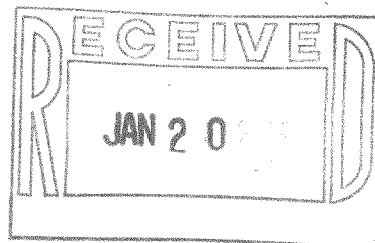

SURVEY CERTIFICATE

State of Wisconsin)SS
Milwaukee County)

We, Interline Survey Services, Inc., certify that we have surveyed the above described property and the above map is a true representation thereof, and shows the size and location of the property, its exterior boundaries, the location and dimensions of all visible structures thereon, fences, apparent easements and roadways and visible encroachments, if any.

This survey is made for the exclusive use of the present owners of the Property, and also those who purchase, mortgage, or guarantee the title thereto, within one (1) year from date hereof.

Gary J. Smith

Wisconsin Registered Land Surveyor

DATE: 9-8-04

JOB NO. 30113

316-1709

GA2656-2