

LAND-MARK SURVEYING
Mark L. Miritz


Wisconsin Registered Land Surveyor S-2582

N9330 Knuteson Drive
Whitewater, WI 53190
Phone: (262) 495-3284
FAX : (262) 495-8421
LAND-MARKSURVEYING.COM

PLAT OF SURVEY


**LOTS 19 AND 20, BLOCK A, NORTH LAKE BEACH TRACT NO. 3,
LOCATED IN THE SOUTHEAST 1/4 OF SECTION 5, TOWN 3
NORTH, RANGE 16 EAST, WALWORTH COUNTY, WISCONSIN.**

**OWNERS: ANDREW & JULIE PETERS
P.O. BOX 193
ELKHORN, WI 53121**

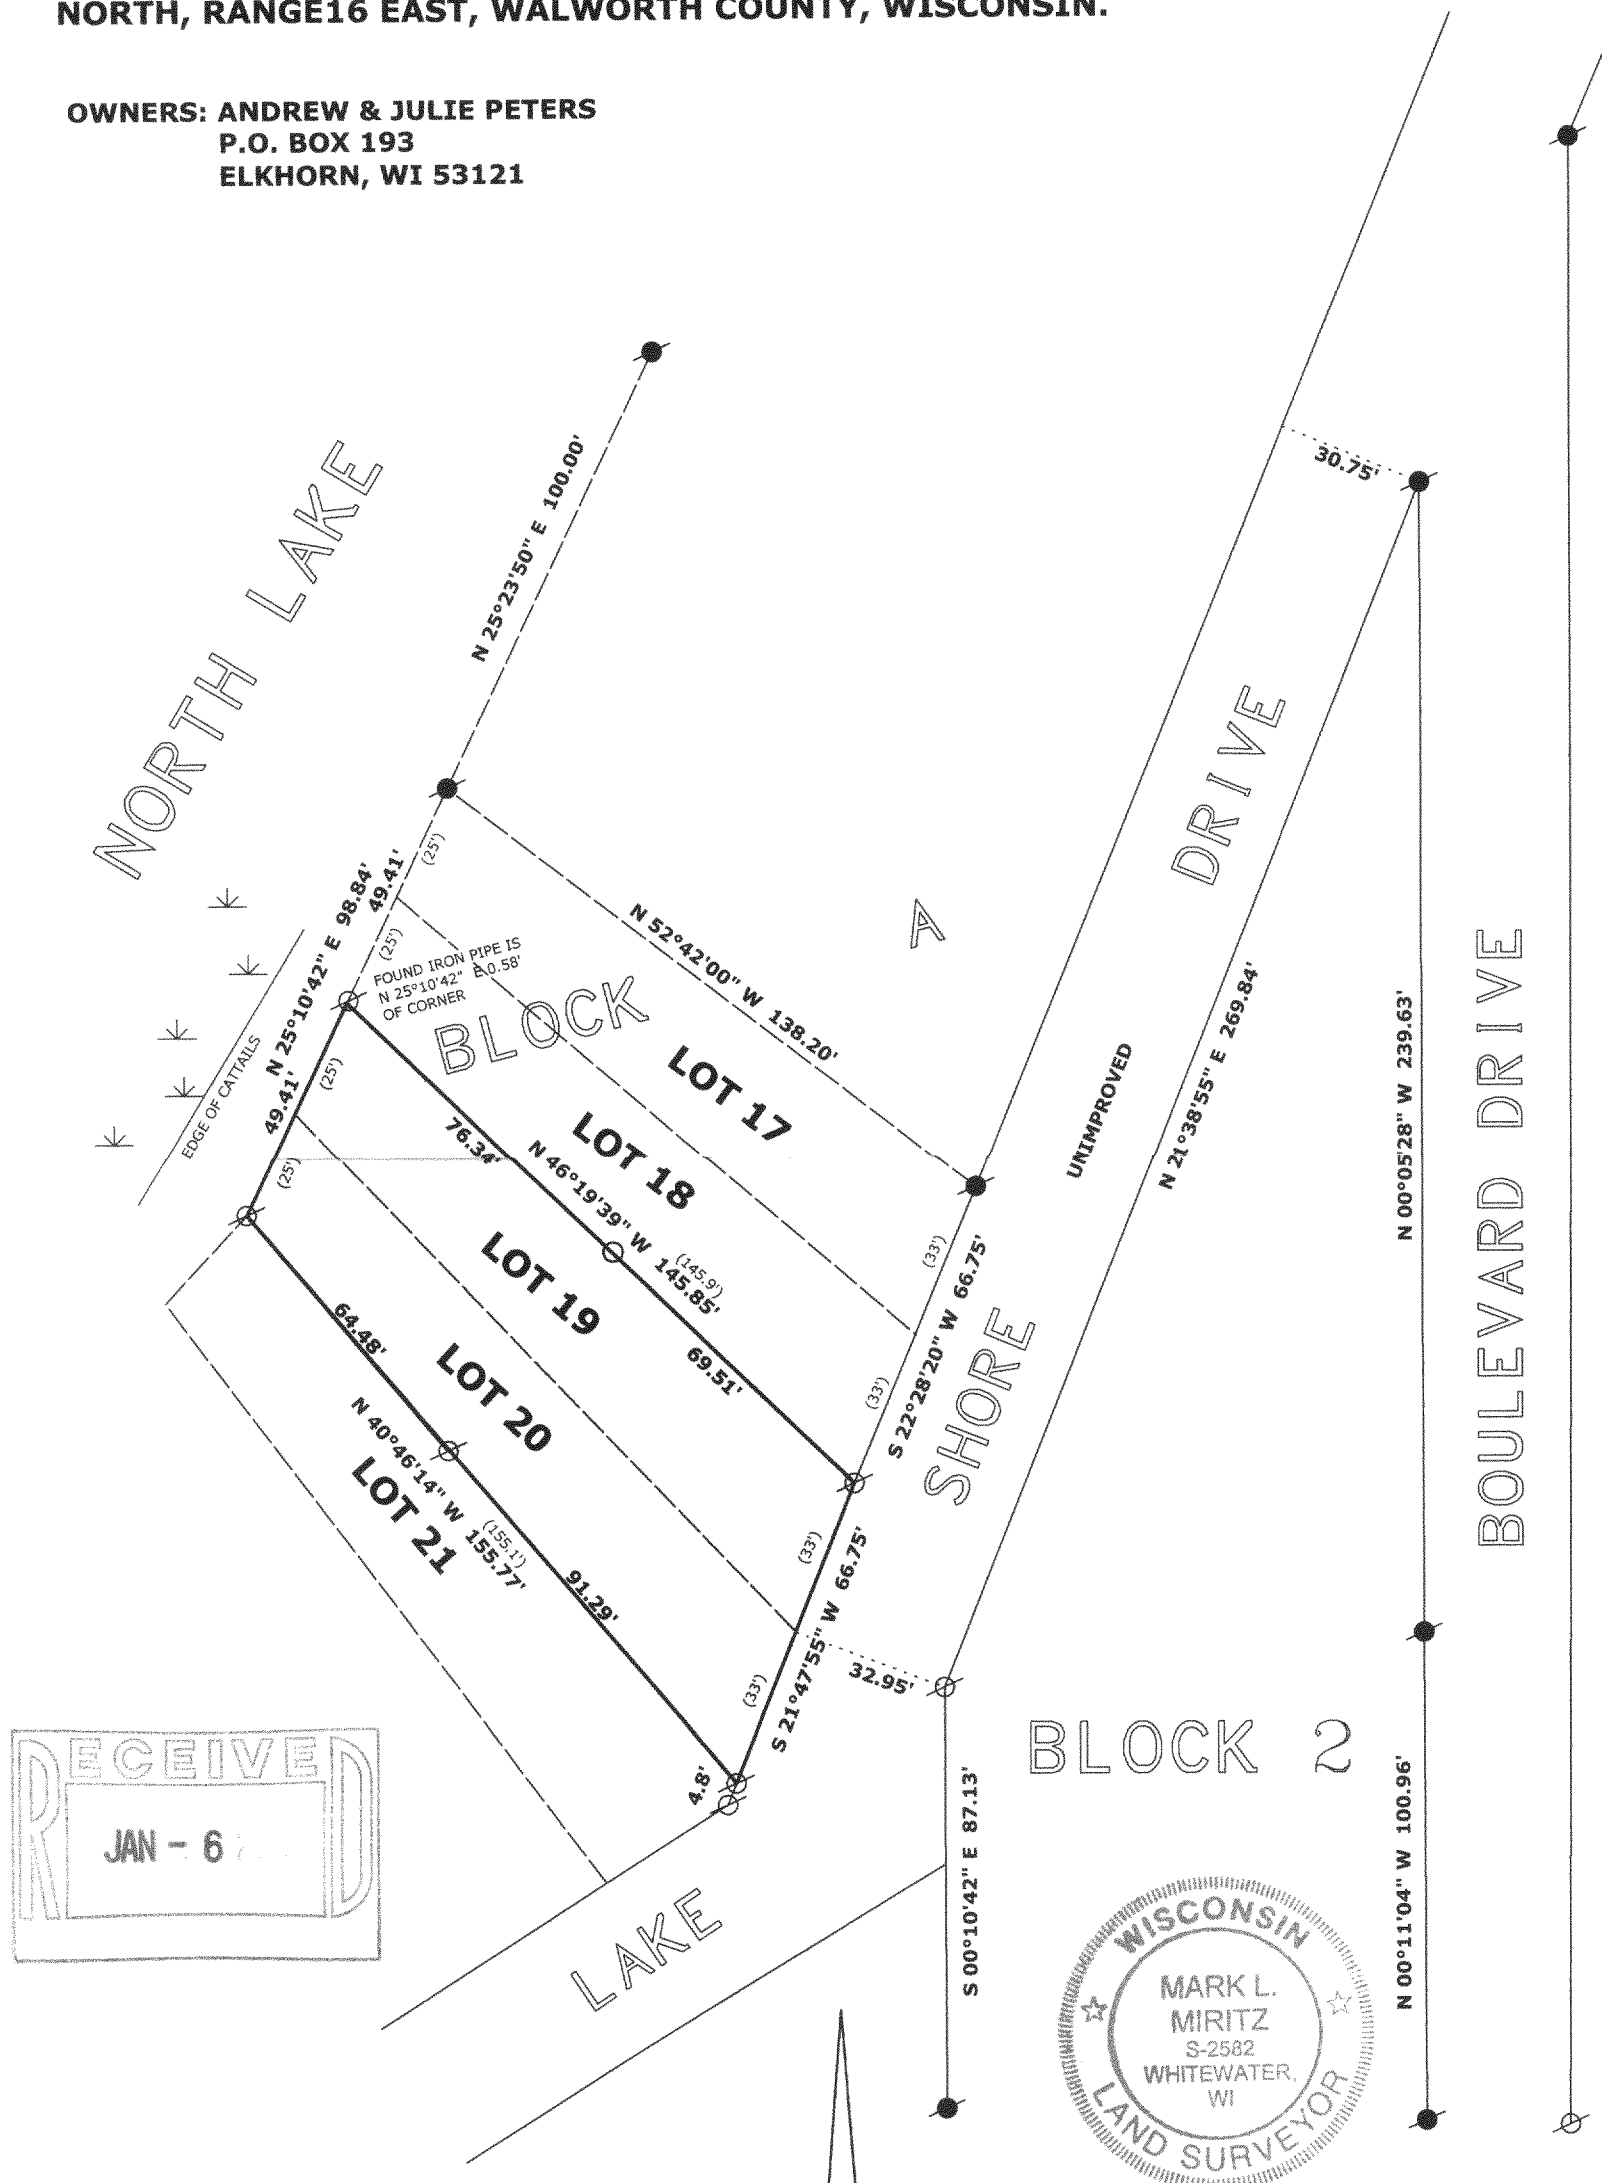

LEGEND

- FOUND IRON PIPE
- FOUND IRON ROD
- ⊠ FOUND COUNTY MONUMENT
- WOOD STAKE AT 10' OFFSET
- ⊕ CHISEL CUT IN CONCRETE
- SET IRON PIPE, 24" LONG, WEIGHING 1.13 LBS./LINEAL FT., 1" DIA.
- (x x) RECORDED AS DIMENSION
- x—x— EXISTING FENCE

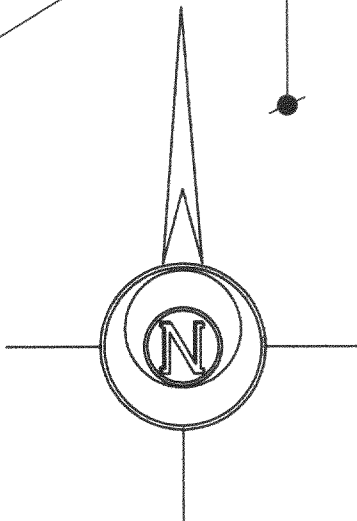

BEARINGS ARE BASED ON PREVIOUS SURVEYS
OF RECORD WHICH ASSUME THE EAST LINE OF
SEC. 5-3-16 TO BEAR NORTH

SCALE: 1" = 40 FEET

"I hereby certify that the above described property has been surveyed by me or under my direction and that the above map is a true representation thereof and shows the size and location of the property, its exterior boundaries, the location of all visible structures and dimensions of all principal buildings thereon, boundary fences, apparent easements, roadways and visible encroachments, if any."
"This survey is made for the use of the present owners of the property, and also those who purchase, mortgage, or guarantee the title thereto within one year from date hereof."

Mark L. Miritz
**MARK L. MIRITZ
S-2582
WHITWATER, WI
LAND SURVEYOR**

DATE: DEC. 25, 2004 JOB NO. 04.1008

GNLB3-300

316-1712