

LAND-MARK SURVEYING

Mark L. Miritz

Wisconsin Registered Land Surveyor S-2582

N9330 Knuteson Drive
Whitewater, WI 53190
Phone: (262) 495-3284
FAX: (262) 495-8421
LAND-MARKSURVEYING.COM

PLAT OF SURVEY

LOT 3 OF BLOCK 12 OF BLUE WING ESTATES,
LOCATED IN SECTION 5, TOWN 3 NORTH,
RANGE 16 EAST, SUGAR CREEK TOWNSHIP,
WALWORTH COUNTY, WISCONSIN.


LEGAL DESCRIPTION FOR WELL EASEMENT

A 10 FOOT WIDE EASEMENT FOR AN EXISTING WELL LOCATED ON LOT 3 OF BLOCK 12 OF BLUE WING ESTATES, LOCATED IN SECTION 5, TOWN 3 NORTH, RANGE 16 EAST, SUGAR CREEK TOWNSHIP, WALWORTH COUNTY, WISCONSIN, DESCRIBED AS FOLLOWS; COMMENCE AT THE NORTHWEST CORNER OF SAID LOT 3; THENCE S 13°10'E ALONG THE WEST LINE OF SAID LOT 3, 73.92 FEET TO THE POINT OF BEGINNING; THENCE S 89°20'27"E 33.32 FEET; THENCE S 00°39'33"W 10.00 FEET; THENCE N 89°20'27"W 30.85 FEET TO A POINT IN THE WEST LINE OF SAID LOT 3; THENCE N 13°10'W 10.30 FEET TO THE POINT OF BEGINNING. SAID EASEMENT CONTAINS 321 SQUARE FEET OF LAND MORE OR LESS.

ORDERED BY: ED KILEEN
C/O ENDEAVOUR DEVELOPMENT, INC.
1818 NORTH HUBBARD STREET
MILWAUKEE, WI. 53212

NOTE:

THE SHORELINE SETBACK IS 75'. AVERAGING THE ADJACENT PROPERTIES CAN BE USED WITH APPROVAL FROM WALWORTH COUNTY ZONING DEPARTMENT. THE AVERAGE IN THIS CASE WOULD BE $75' + 61.7' / 2 = 68.4'$

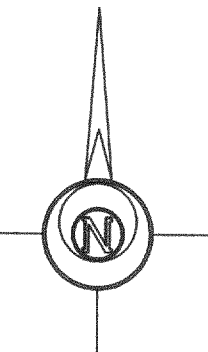

LEGEND


- FOUND IRON PIPE
- FOUND IRON ROD
- FOUND COUNTY MONUMENT
- FOUND CONCRETE MONUMENT
- CHISEL CUT IN CONCRETE
- SET IRON ROD, 24" LONG, WEIGHING 1.5 LBS./LINEAL FT., 3/4" DIA.
- RECORDED AS DIMENSION
- EXISTING FENCE

SCALE: 1" = 30 FEET

"I hereby certify that the above described property has been surveyed by me or under my direction and that the above map is a true representation thereof and shows the size and location of the property, its exterior boundaries, the location of all visible structures and dimensions of all principal buildings thereon, boundary fences, apparent easements, roadways and visible encroachments, if any."
"This survey is made for the use of the present owners of the property, and also those who purchase, mortgage, or guarantee the title thereto within one year from date hereof."

MARK L. MIRITZ
WISCONSIN REGISTERED
LAND SURVEYOR S-2582

DATE: APRIL 20, 2005 JOB NO. 05.409

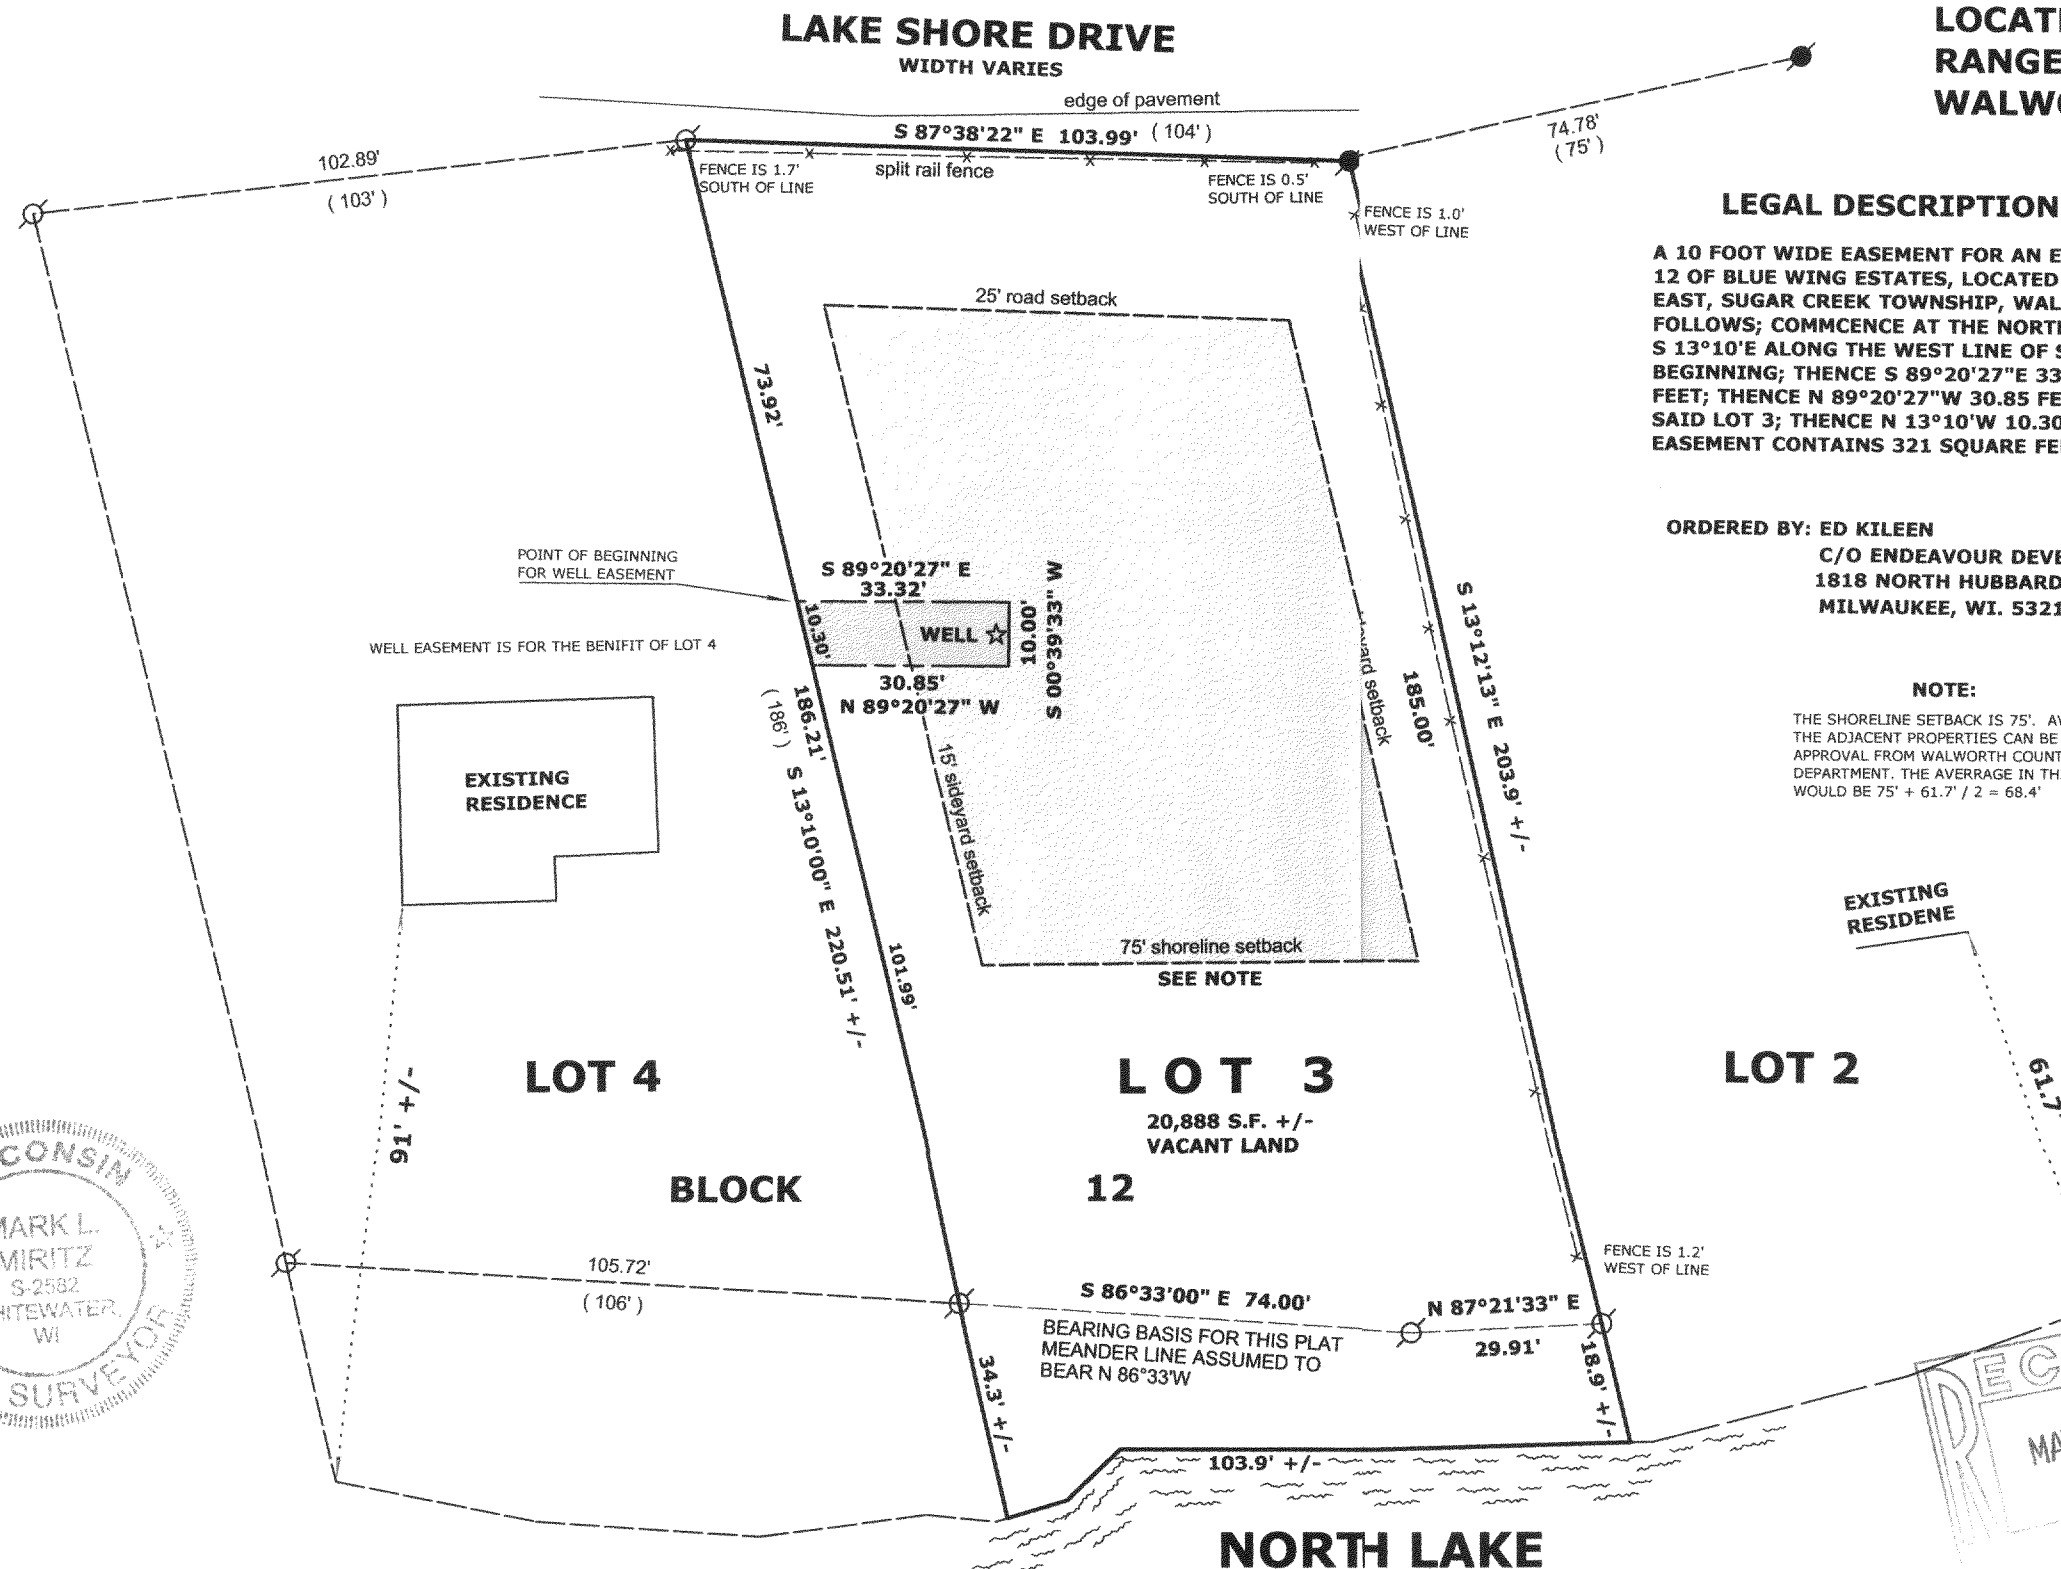

316-1734

616W 00032