


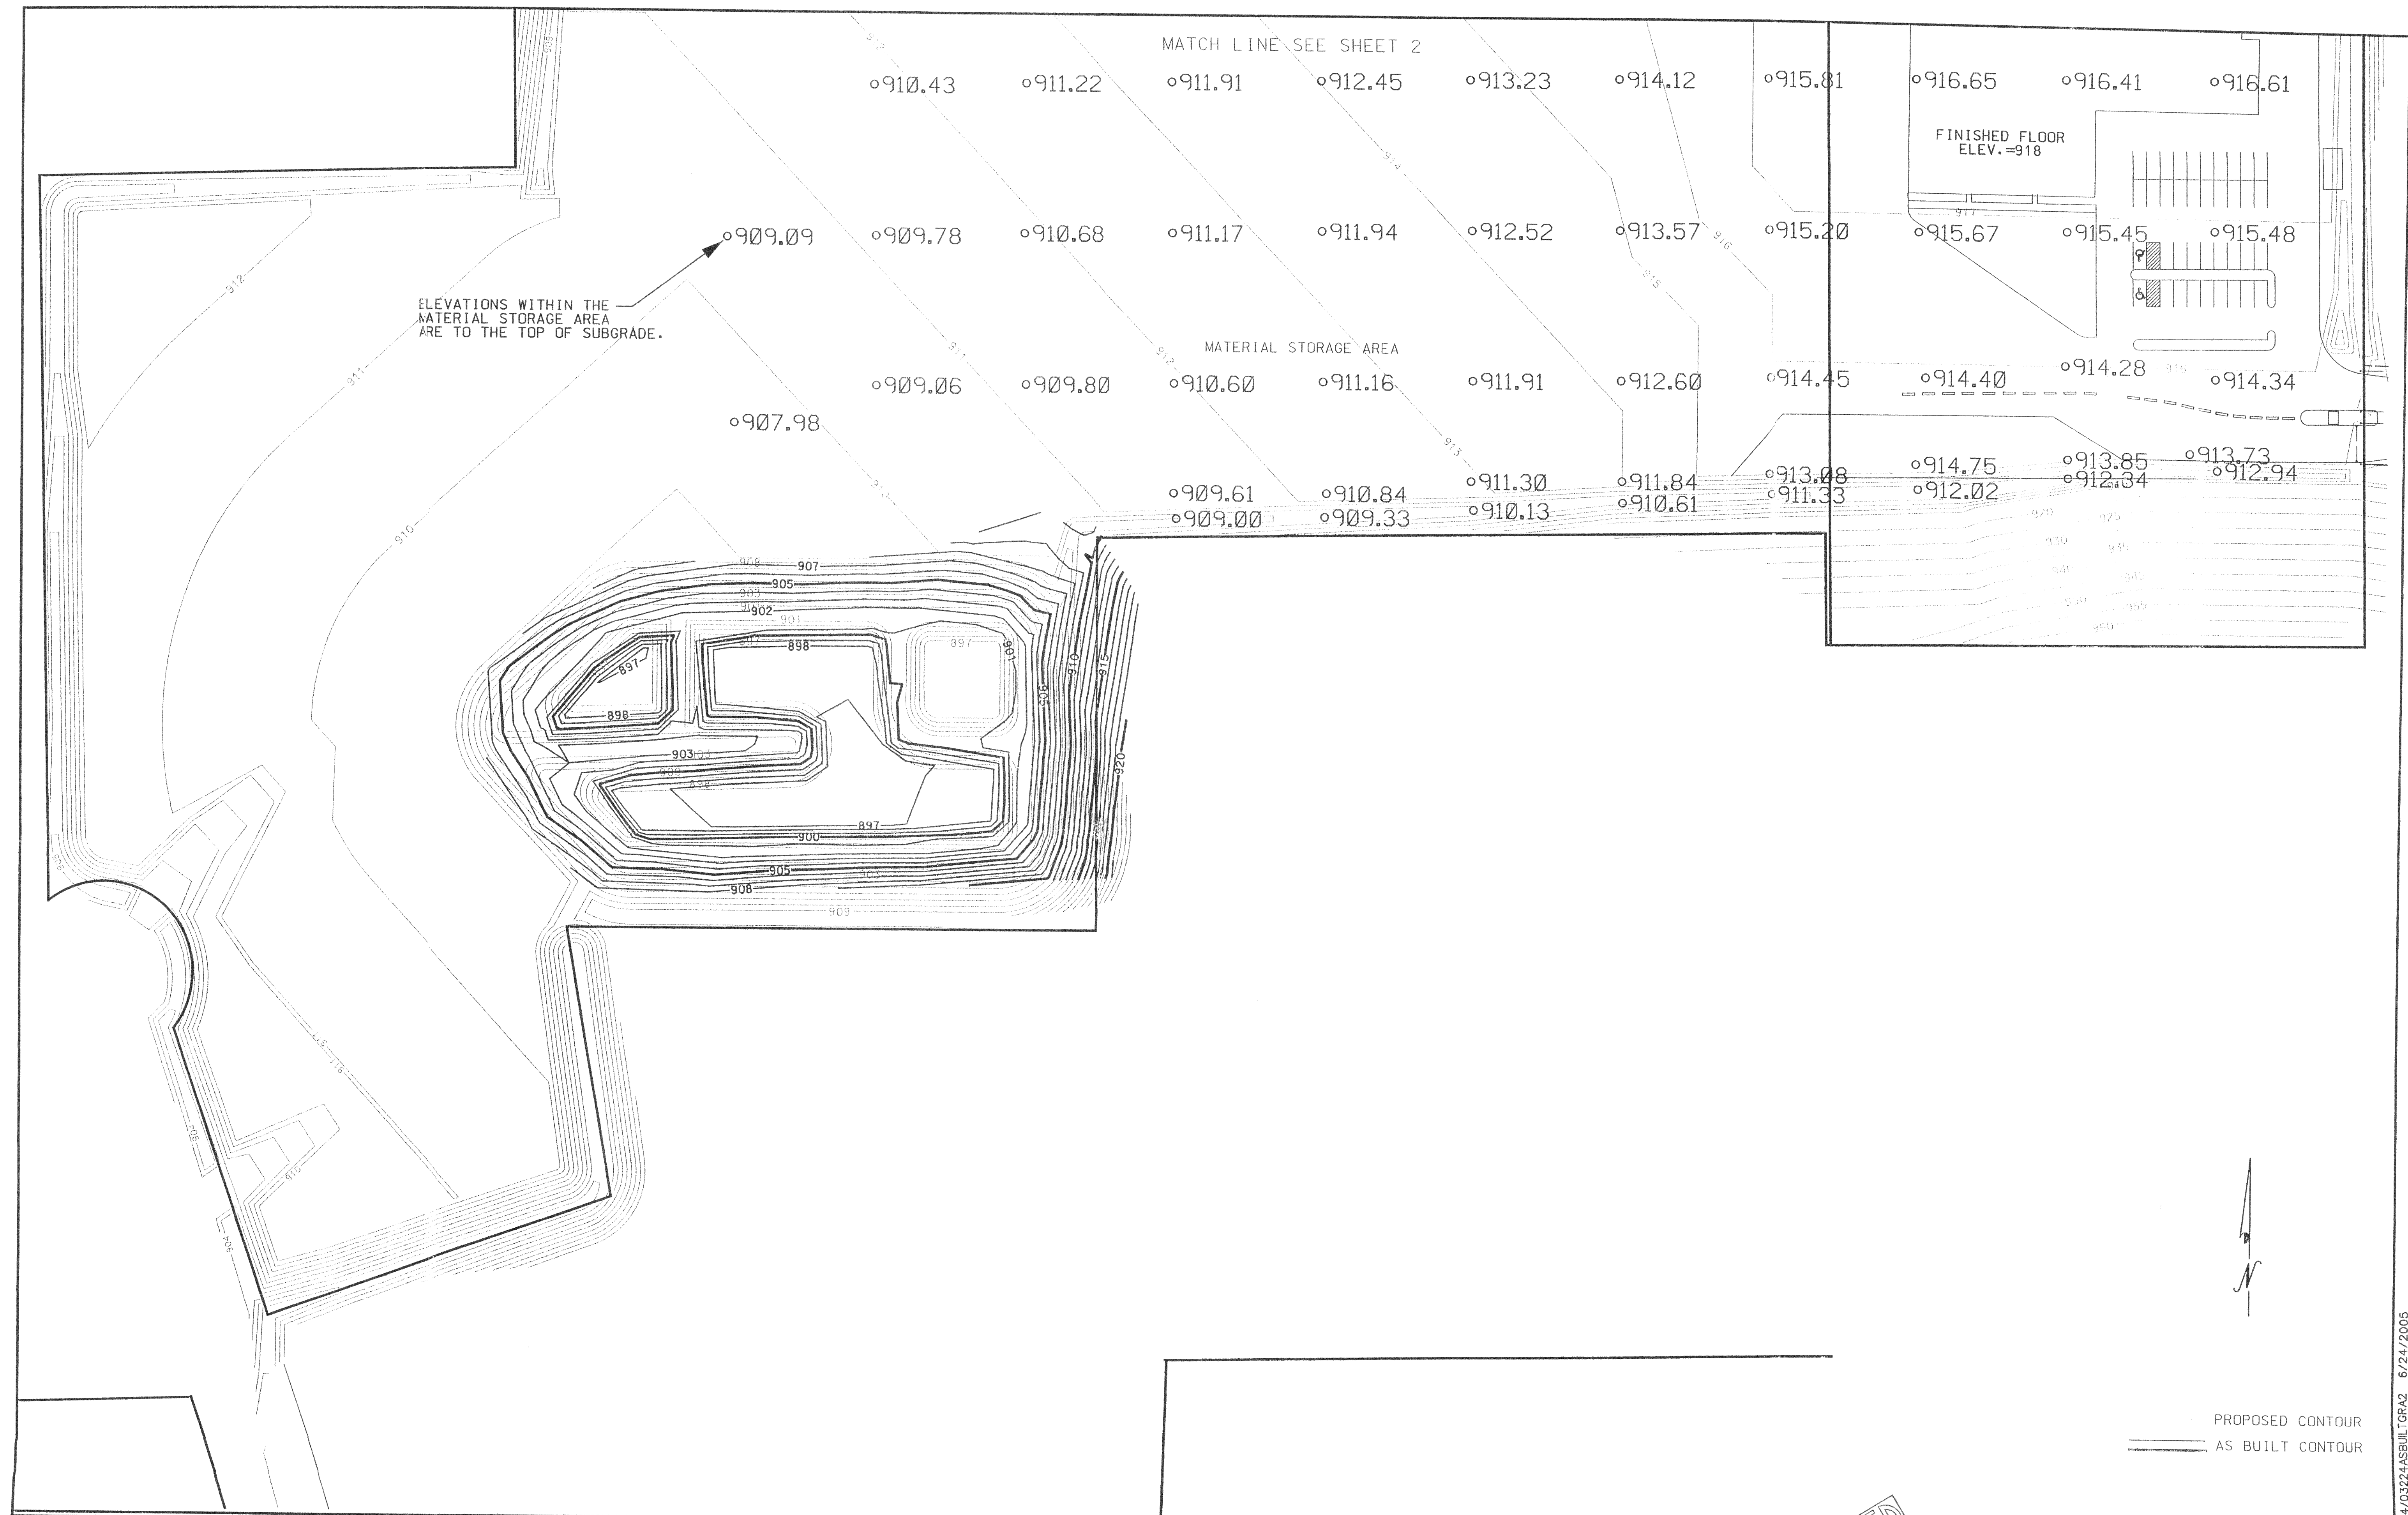

RSV
ENGINEERING, INC.
Engineers • Land Surveyors • Environmental Scientists
801 MAIN STREET MUKWONAGO, WISCONSIN 53149 (262)363-2004

INITIALS	DATE
DESIGN DKV	
DRAWN MEM	6/24/05
CHECKED PHV	
PROJECT NO.	03224

1" = 50'
Scale

UNILOCK
TOWN OF SUGAR CREEK
WALWORTH COUNTY

NO.	REVISIONS	BY	DATE

RECEIVED
JUL 11 2005


GRADING AND
EROSION CONTROL
PLAN

SHEET NO.
1
OF
2

RSV* RSVDATA5/03224/03224ASEULLTGRA2 6/24/2005

GA372100003

36-1739

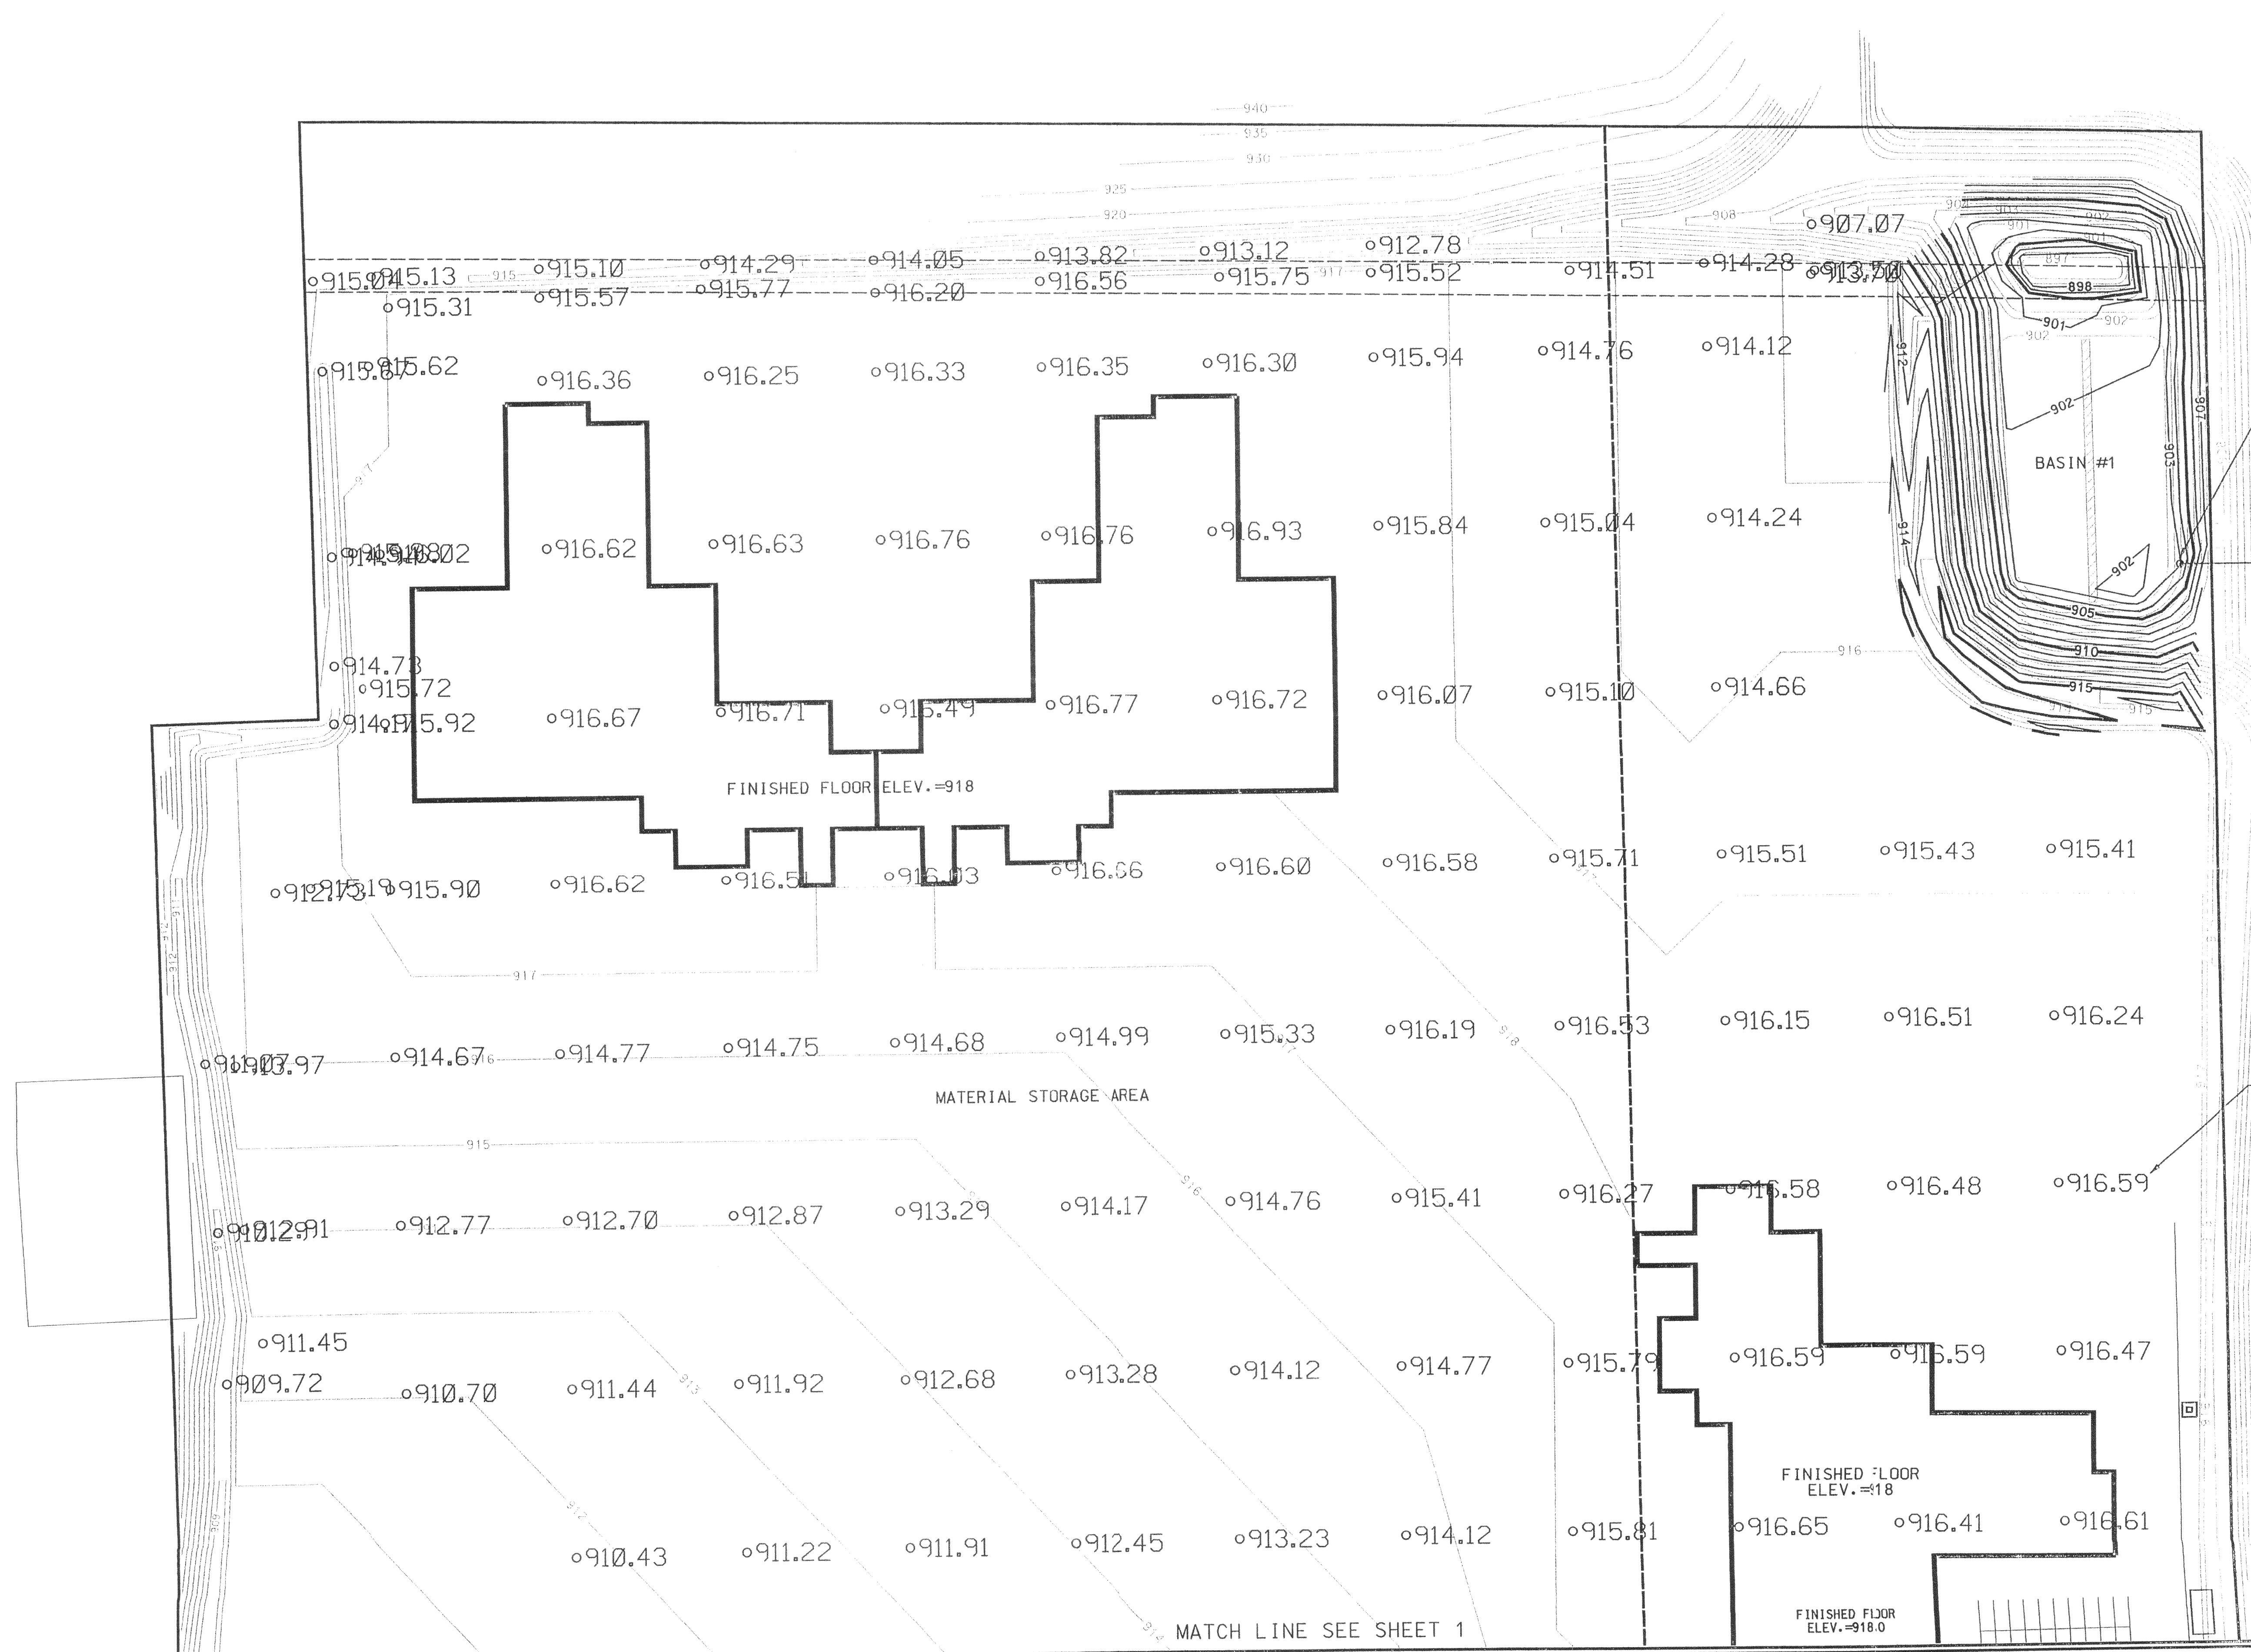

PROPOSED CONTOUR
 AS BUILT CONTOUR

RSV ENGINEERING, INC.
 Engineers • Land Surveyors • Environmental Scientists
 801 MAIN STREET • MUKWONG, WISCONSIN 53149 (262) 363-2004

DESIGN	INITIALS	DATE
DRAWN	DKV	6/24/05
CHECKED	MEM	
	PHV	
PROJECT NO.	03224	

1" = 50'

 Scale

UNILOCK
 TOWN OF SUGAR CREEK
 WALWORTH COUNTY


NO.	REVISIONS	BY	DATE

GRADING AND
 EROSION CONTROL
 PLAN

SHEET NO.	2
OF	2

RSV • RSV/DAT/AS/03224/03224-AS-BUILT-GRAD 6/24/2005

Letter of Transmittal

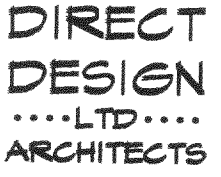

Date: June 28, 2005

Records office

Walworth County Land Information Services
100W Walworth St., Room 106
Elkhorn WI 53121, 1001

JOB NUMBER: 13155		JOB NAME: Unilock - Elkhorn	
We are sending you			
via:	☐ UPS Ground (one-day del. to Chicago area - no time guar.)	☐ UPS Next Day - (Delivery by 10:30 a.m.)	
	☐ FED-EX	☐ Messenger	
	☐ Pick-up	☒ Drop-off	
	☐ Other	☐ U.S. Mail	
Copies: Drawing Date: Description:			
1	6/24/05	Grading and erosion Control As-Builts	

Notes: Please call me with any questions or comments.

☐ For approval.	☐ Review as submitted.	☐ Re-submit copies.
☒ For your use.	☐ Reviewed as noted.	☐ Submit for distribution.
☒ As requested.	☐ Returned for corrections.	☐ For your review/comment.
BIDS DUE:		
☐	☐ Please sign original & return in S.A.S.E.	☐ Returned after loan.
☐	☐	☐ Copy for your file.

Other: Prints sealed by:
Signed: