

LAND-MARK SURVEYING

Mark L. Miritz

Wisconsin Registered Land Surveyor S-2582



N9330 Knuteson Drive
Whitewater, WI 53190
Phone: (262) 495-3284
FAX: (262) 495-8421
LAND-MARKSURVEYING.COM

PLAT OF SURVEY

LOTS 64-69 INCLUSIVE OF BLOCK A OF NORTH LAKE
BEACH TRACT NO. 3, LOCATED IN SECTION 8, TOWN 3
NORTH, RANGE 16 EAST, SUGAR CREEK TOWNSHIP,
WALWORTH COUNTY, WISCONSIN.

OWNERS: BRIAN AND SUSEN RASMUSSEN
W6612 BARKERS ROAD
ELKHORN, WI. 53121

ORDERED BY: PHIL CLARK
BEST BUILT GARAGE BUILDERS
P.O. BOX 37
HONEY CREEK, WI 53138

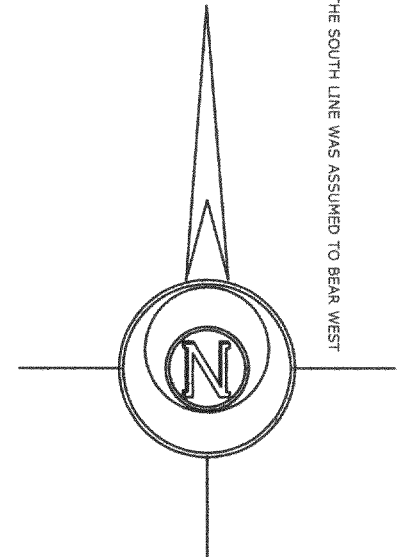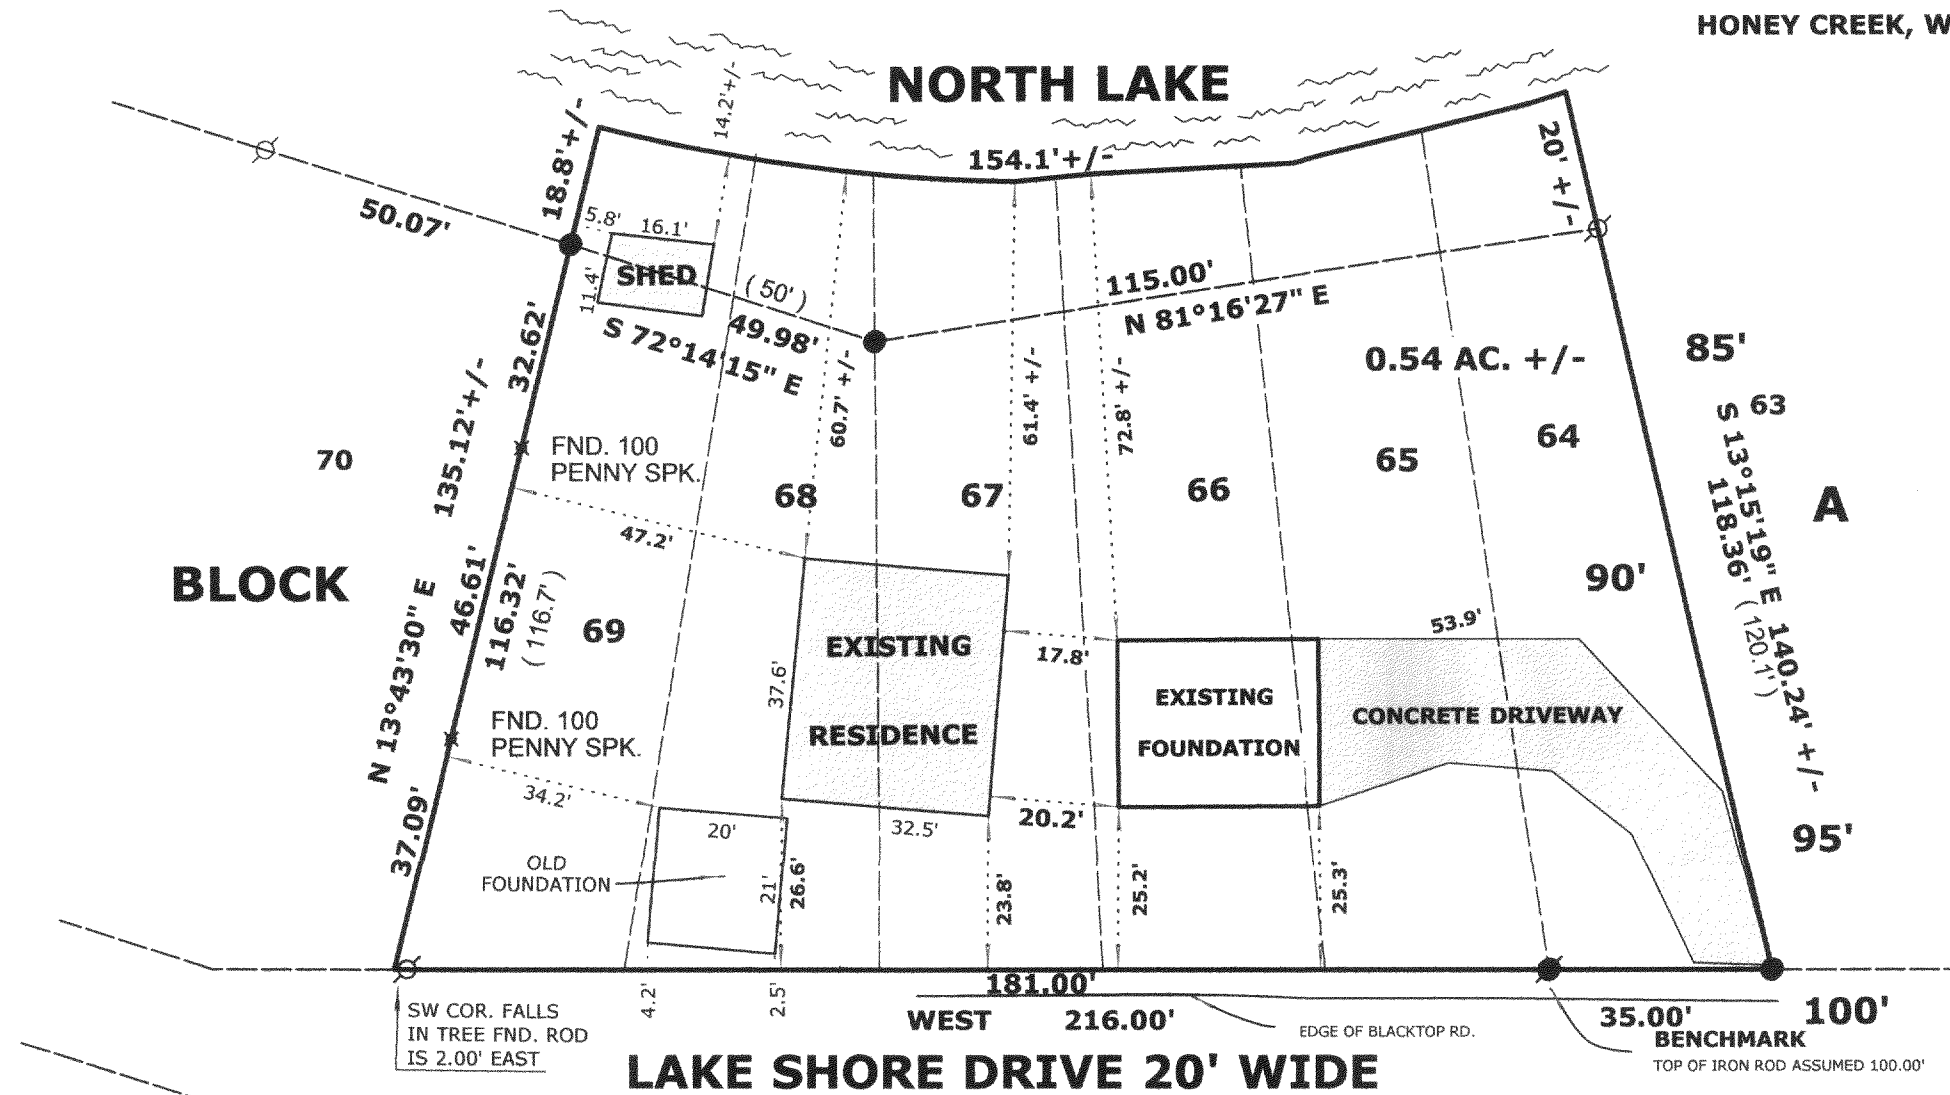

LEGEND

- FOUND IRON PIPE
- FOUND IRON ROD
- FOUND COUNTY MONUMENT
- WOOD STAKE MARKING 10' OFFSET
- CHISEL CUT IN CONCRETE
- SET IRON ROD, 24" LONG, WEIGHING 1.5 LBS./LINEAL FT., 3/4" DIA.
- RECORDED AS DIMENSION
- EXISTING FENCE

SCALE: 1" = 30 FEET

"I hereby certify that the above described property has been surveyed by me or under my direction and that the above map is a true representation thereof and shows the size and location of the property, its exterior boundaries, the location of all visible structures and dimensions of all principal buildings thereon, boundary fences, apparent easements, roadways and visible encroachments, if any."
"This survey is made for the use of the present owners of the property, and also those who purchase, mortgage, or guarantee the title thereto within one year from date hereof."

Mark L. Miritz
MARK L. MIRITZ
WISCONSIN REGISTERED
LAND SURVEYOR S-2582

REVISED JUNE 7, 2005 TO SHOW GARAGE "AS BUILT"

DATE: OCT. 16, 2004 JOB NO. 04.602

316-1745

8130 00705