

LAND-MARK SURVEYING


Mark L. Miritz

Wisconsin Registered Land Surveyor S-2582

N9330 Knuteson Drive
Whitewater, WI 53190
Phone: (262) 495-3284
FAX : (262) 495-8421
LAND-MARKSURVEYING.COM


PLAT OF SURVEY

THE EASTERLY 1/2 OF LOT 3 AND ALL OF LOTS 4 AND 5
OF BLOCK 11, OF INTERLAKEN SUBDIVISION, LOCATED IN
SOUTH 1/2 OF SECTION 11, TOWN 3 NORTH, RANGE 16
EAST, TOWN OF SUGAR CREEK. WALWORTH COUNTY,
WISCONSIN.

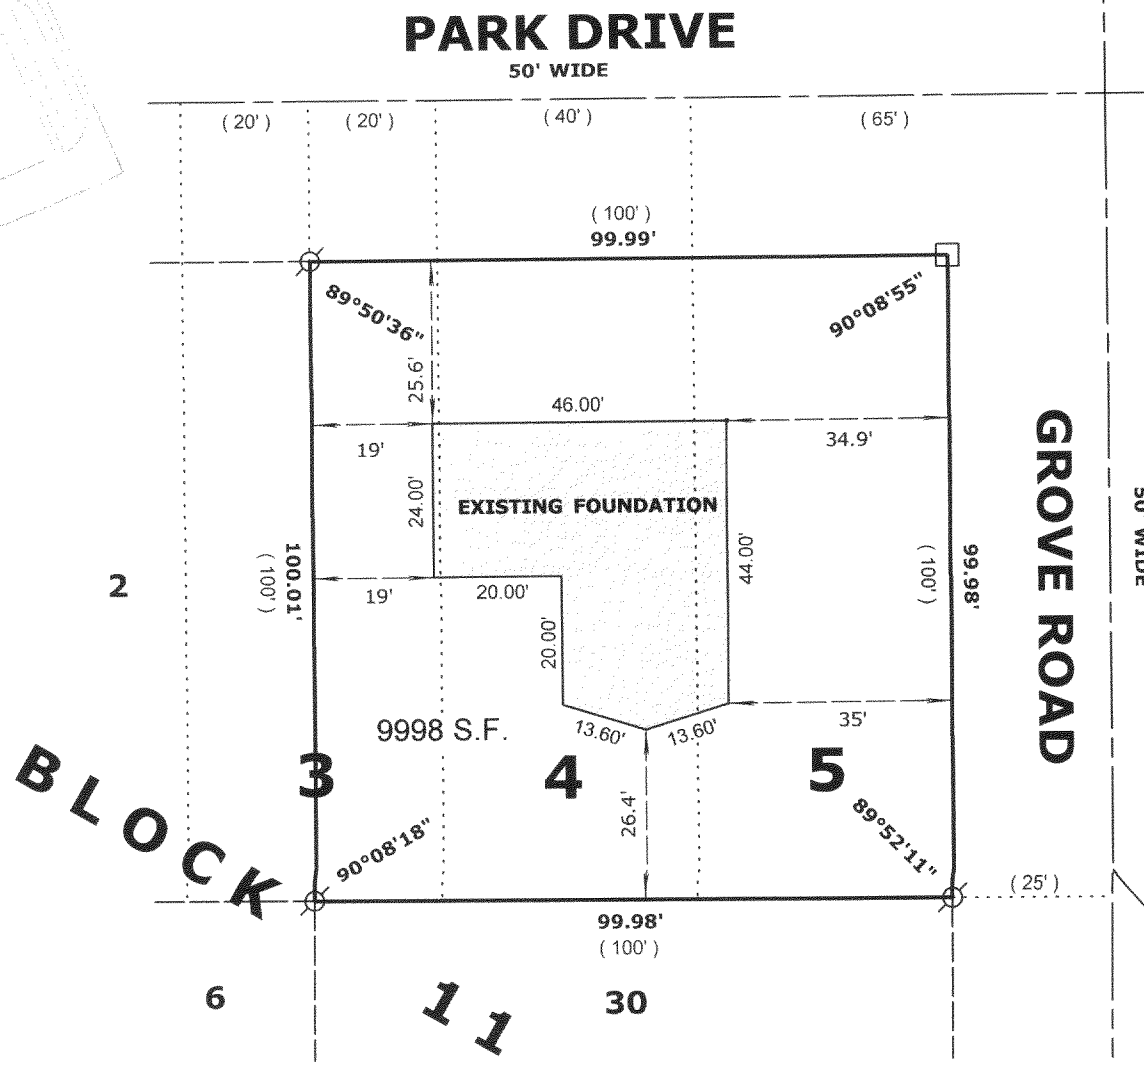

ORDERED BY:
SCHAUDER BUILDING, INC.
4115 U.S. HIGHWAY 51 NORTH
JANESVILLE, WI 53545-9674

OWNER: BONNIE L. NEWBURY
267 S. PERKINS BLVD.
BURLINGTON, WI. 53105

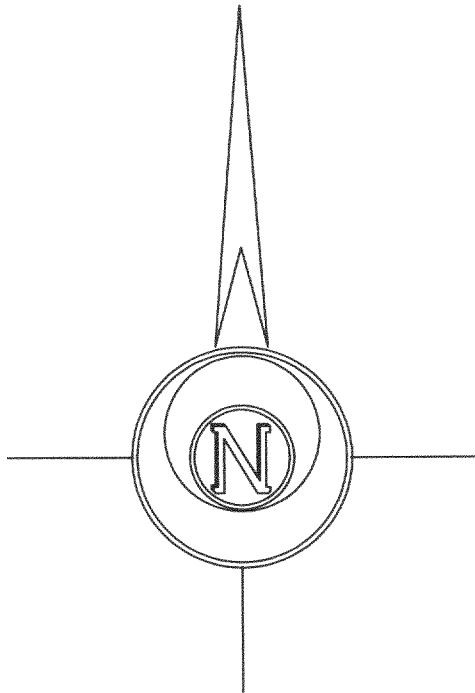

LEGEND

- ⊗ FOUND IRON PIPE
- FOUND IRON ROD
- ⊠ 10' BUILDING OFFSET STAKE
- FOUND CONCRETE MONUMENT
- + CHISEL CUT IN CONCRETE
- SET IRON ROD, 24" LONG, WEIGHING 1.5 LBS./LINEAL FT., 3/4" DIA.
- (x x) RECORDED AS DIMENSION
- x-x- EXISTING FENCE

SCALE: 1" = 30 FEET

"I hereby certify that the above described property has been surveyed by me or under my direction and that the above map is a true representation thereof and shows the size and location of the property, its exterior boundaries, the location of all visible structures and dimensions of all principal buildings thereon, boundary fences, apparent easements, roadways and visible encroachments, if any."
"This survey is made for the use of the present owners of the property, and also those who purchase, mortgage, or guarantee the title thereto within one year from date hereof."

MARK L. MIRITZ
WISCONSIN REGISTERED
LAND SURVEYOR S-2582

DATE: JUNE 9, 2005 JOB NO. 05.605

REVISED 7/22/2005 TO SHOW FOUNDATION "AS BUILT"



36-1779

GTZ 8005