

Plat of Survey

of


A parcel of land described in a Warranty Deed recorded August 5, 2004 as Document No. 612820 as shown below:

Lot 6 of Block 11 of Cool Hill Park Addition No. 2,
a subdivision located in the Northeast 1/4 of Section 3, Town 3 North, Range 16 East, Town of Sugar Creek, Walworth County, Wisconsin.


Excepting Therefrom

Part of Lot 6 of Block 11 of Cool Hill Park Addition No. 2, a subdivision located in the Northeast 1/4 of Section 3, Town 3 North, Range 16 East, Town of Sugar Creek, Walworth County, Wisconsin, described as follows: Begin at an iron pipe marking the most Northeast corner of said Lot 6; thence South 42°55'34" East, along the East line of said Lot 6, 1.03 feet; thence Southwesterly along the arc of a curve to the right (central angle = 47°18'45", radius=61.00 feet, whose chord bears South 57°34'44" West 48.95 feet) 50.37 feet to a point on the West line of said Lot 6; thence North 15°02'00" East, along said West line, 1.09 feet to an iron pipe at the Northwest corner of said Lot 6; thence Northeasterly along the North line of said Lot 6 and the arc of a curve to the left (central angle=47°06'51", radius=60.00 feet, whose chord bears North 57°15'23" East 47.96 feet) 49.34 feet to the Point of Beginning. Said parcel contains 0.001 acre (50 sq.ft.) of land, more or less.

Surveyed for: **Richard Krol**
916 Fortress Drive
McHenry, Illinois 60050

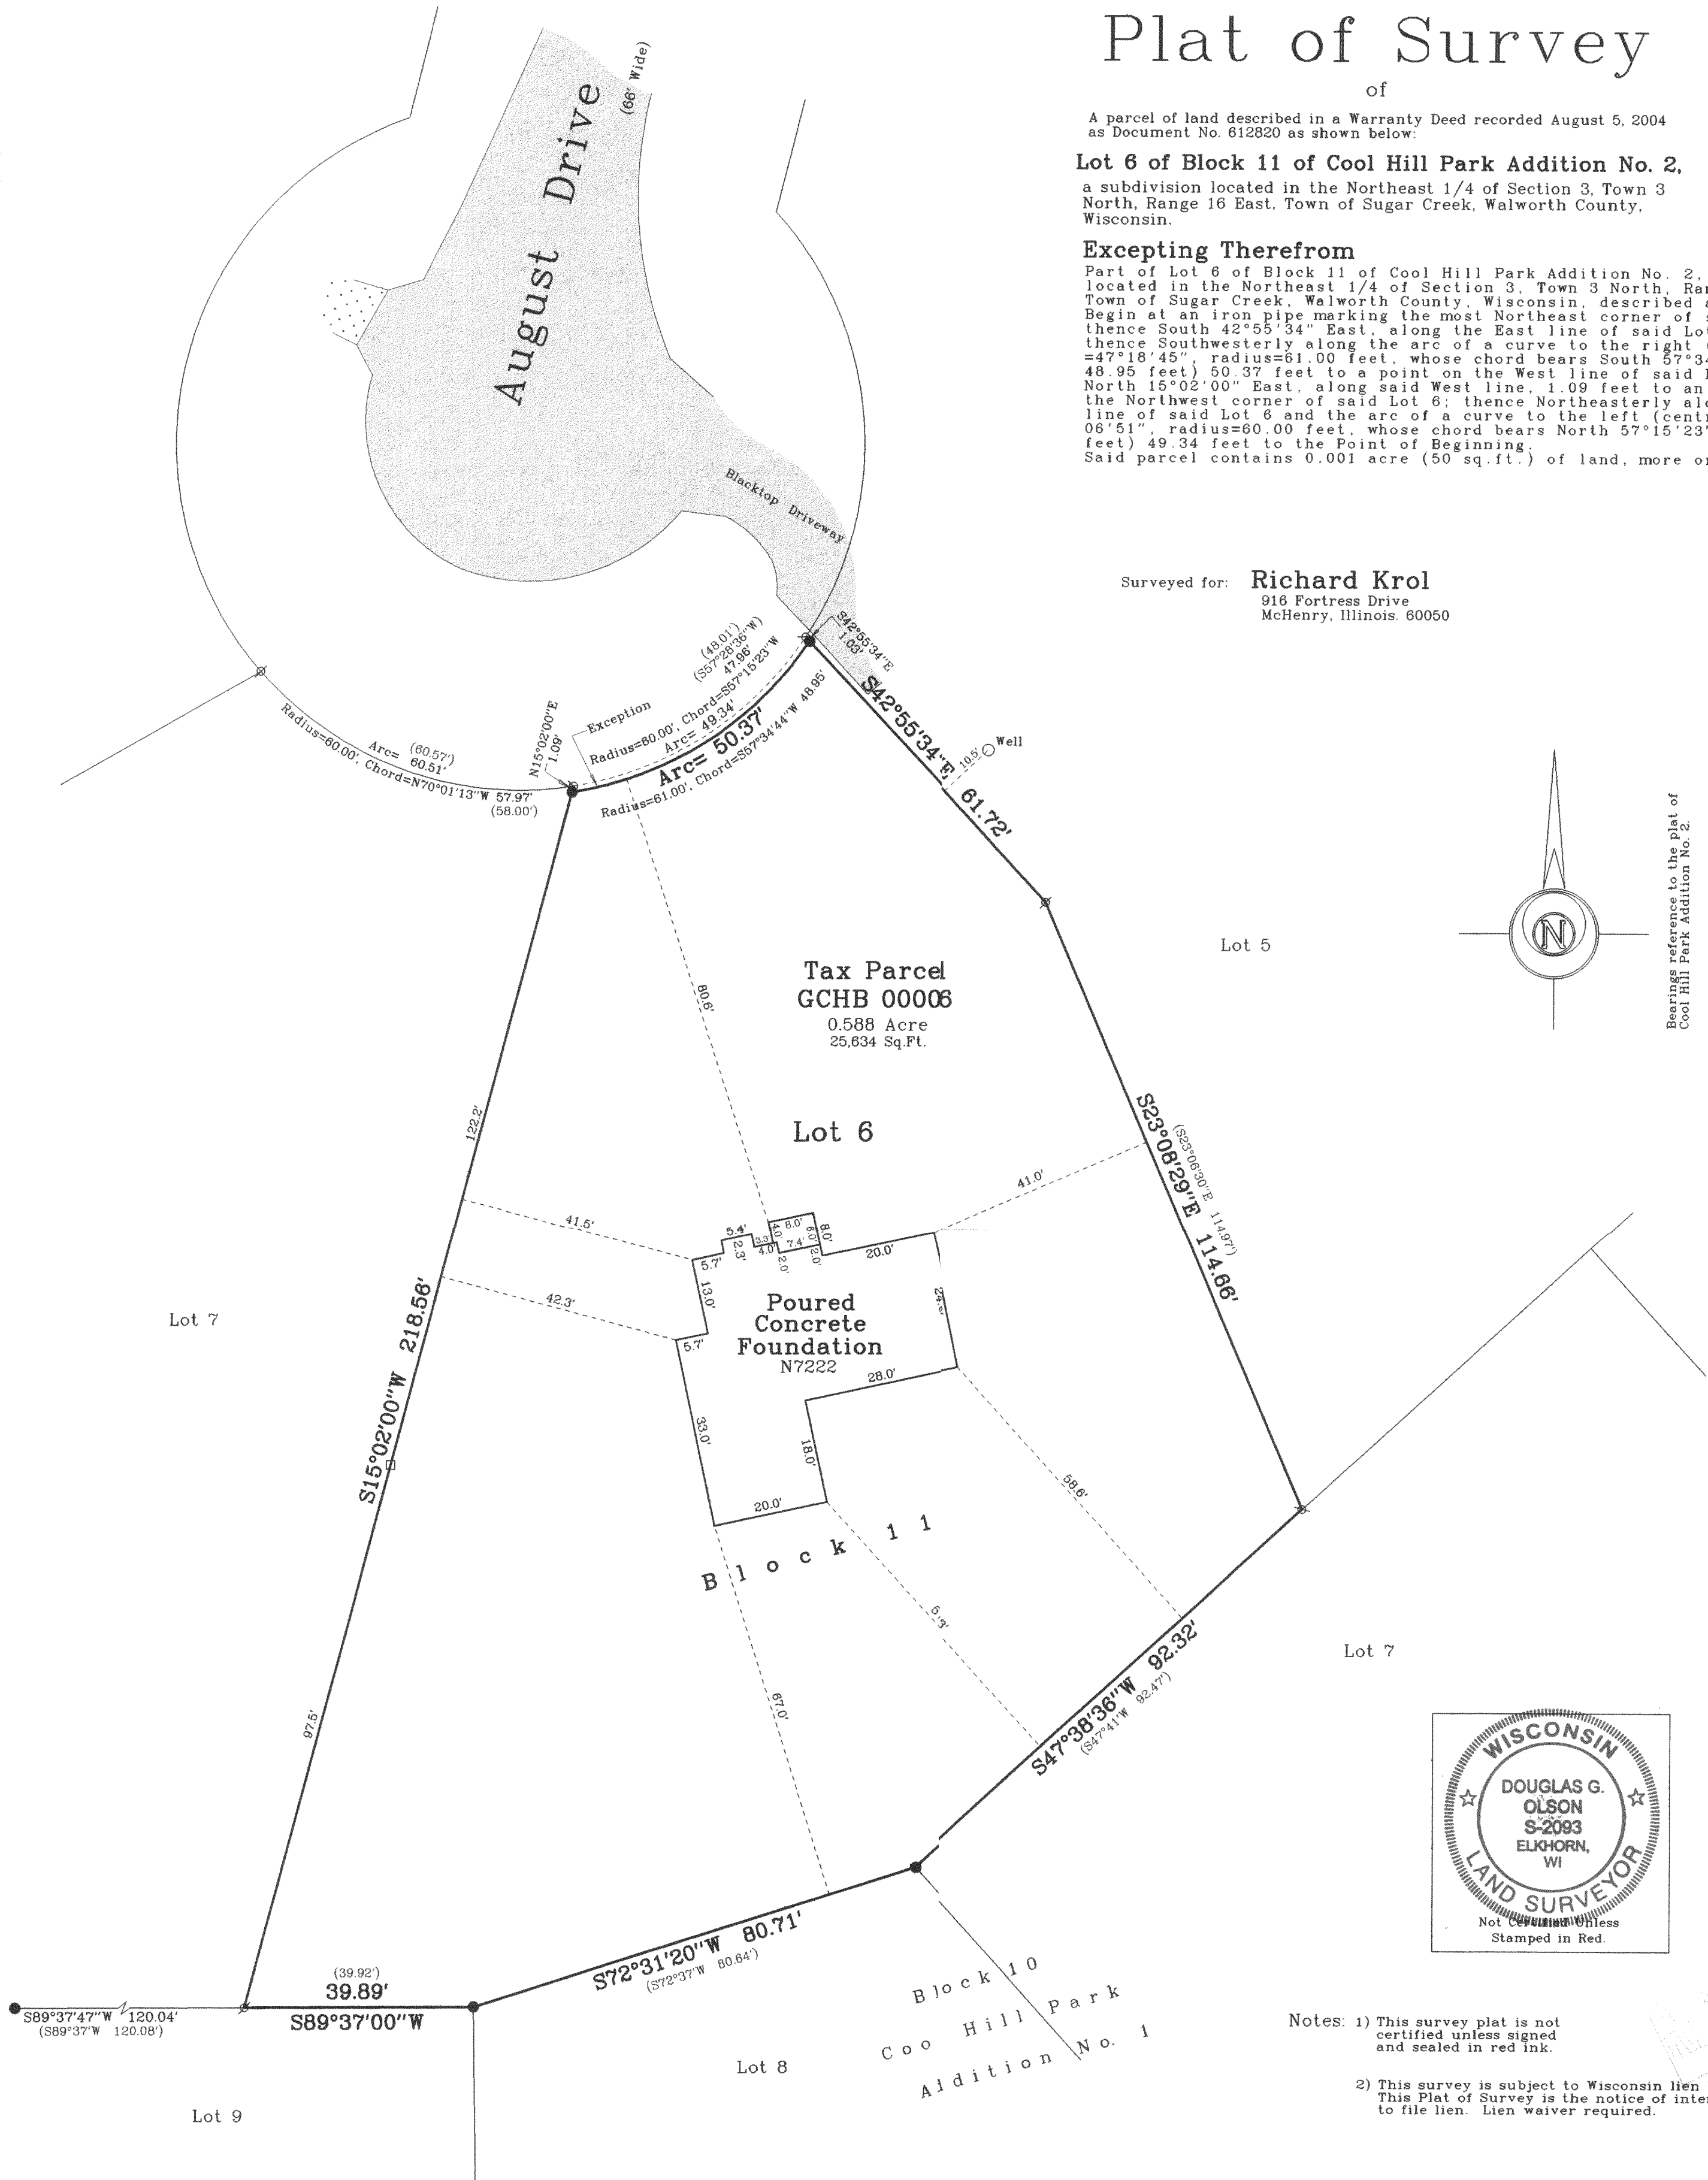

Bearings reference to the plat of
Cool Hill Park Addition No. 2.

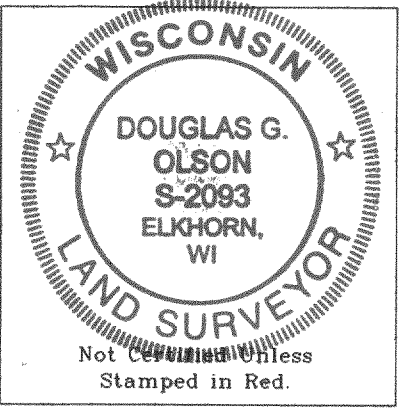

- Notes: 1) This survey plat is not certified unless signed and sealed in red ink.
2) This survey is subject to Wisconsin lien laws. This Plat of Survey is the notice of intent to file lien. Lien waiver required.

Copyright c 2005 by Jensen & Olson Land Surveying, LLC.

All rights reserved. No part of this survey plat may be reproduced or transmitted in any form by any means - graphic, electronic, or mechanical, including photocopying, tracing, or information storage and retrieval systems - without permission in writing from Douglas G. Olson, Jensen & Olson Land Surveying, LLC.

I hereby certify that I have surveyed the above described property and the map hereon is correct to the best of my professional knowledge and belief and shows the size and location of the property, its exterior boundaries, the location and dimensions of all visible structures thereon, boundary fences, apparent easements and roadways and visible encroachments, if any.
This survey is made for the exclusive use of the present owners of property, and also those who purchase, mortgage or guarantee title thereto, within one year from the date hereof.

Douglas G. Olson
Wisconsin Registered Land Surveyor - 2093

2005.055	Sheet 1 of 1 Sheets Job Reference Number 2005.055 Legend - Found Iron Pipe - Found Iron Rod - Recorded Information - Concrete Surface - Asphalt Surface - Set Wood Stake	Jensen & Olson land Surveying, LLC 45 South Wisconsin Street P.O. Box 322 Elkhorn, Wisconsin 53121 Telephone (262) 723-3434 Facsimile (262) 723-8044	Scale in Feet 1" = 20' 0' 10' 20' 40'	Survey Date: April 25, 2005. Revisions:
----------	---	---	--	---

GCHB 00006

3K-1787